


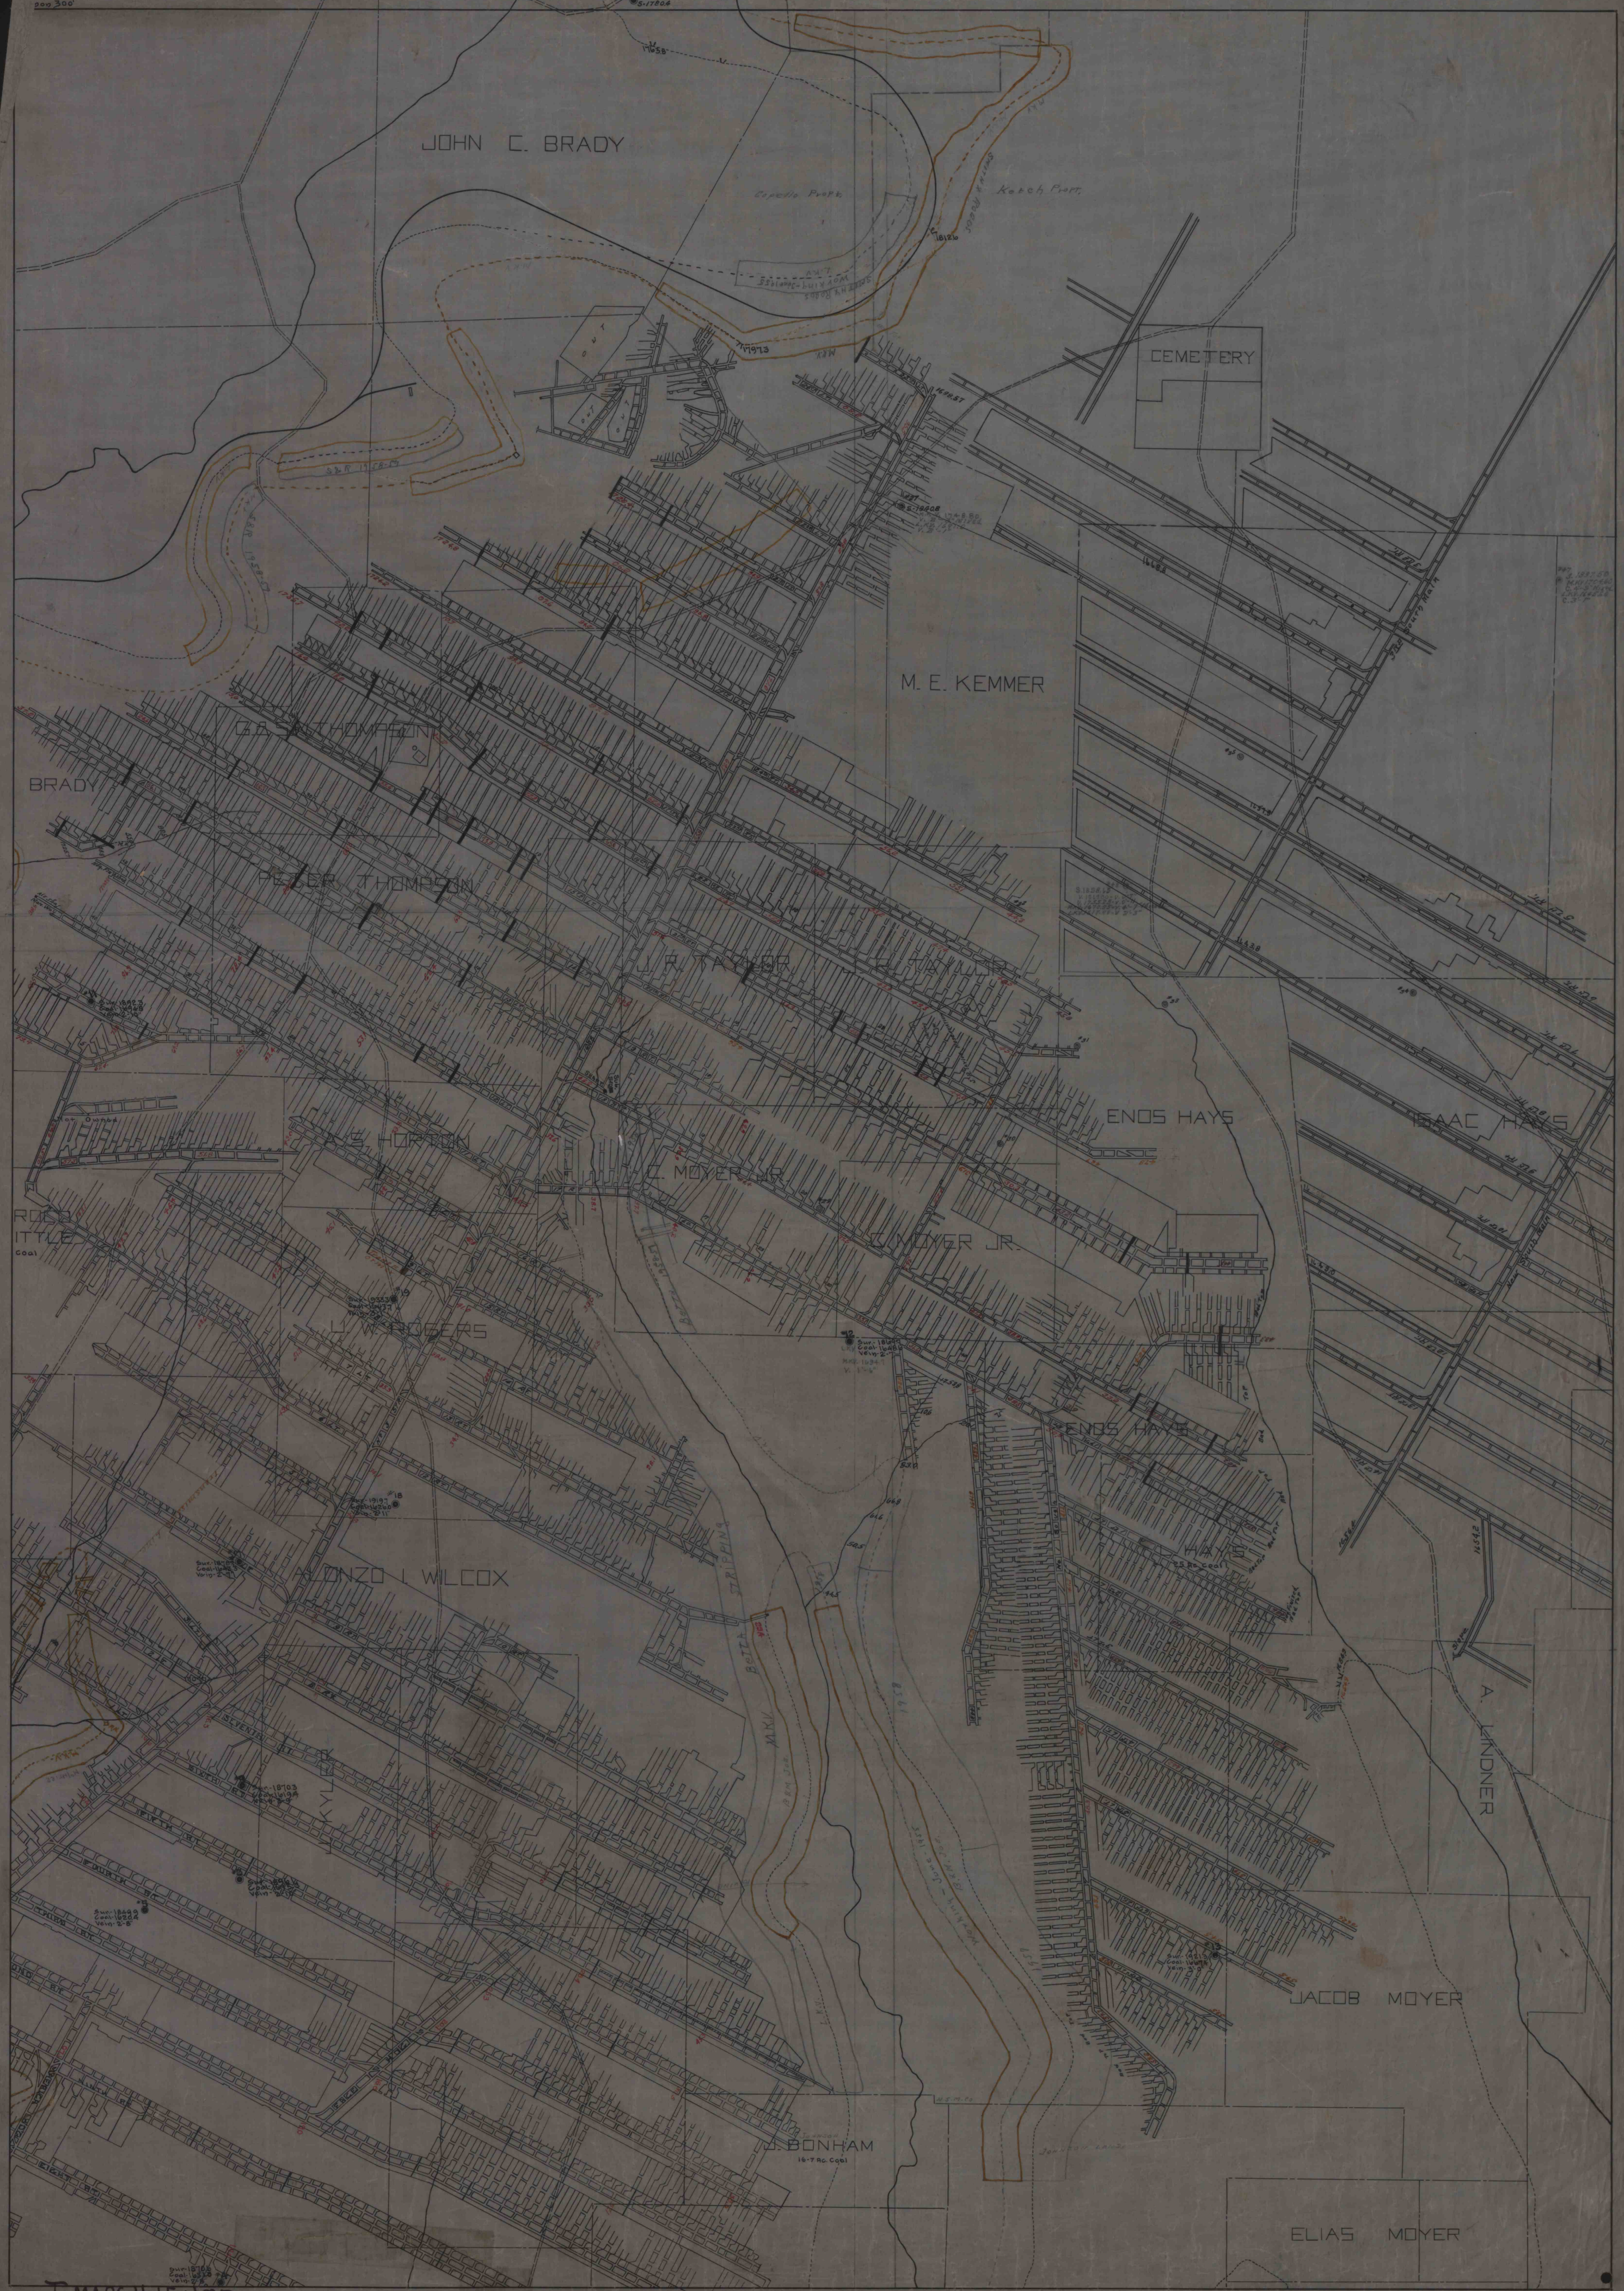

JOHN C. BRADY

CEMETERY

M. E. KEMMER

BRADY

G. B. THOMPSON

PETER THOMPSON

R. TAYLOR

ENOS HAYS

ISAAC HAYS

ROCK
LITTLE
Coal

S. HORTON

C. MOYER JR.

C. MOYER JR.

J. W. ROGERS

ALONZO I. WILCOX

A. LINDNER

JACOB MOYER

D. BONHAM
16-T RO. COAL

ELIAS MOYER