


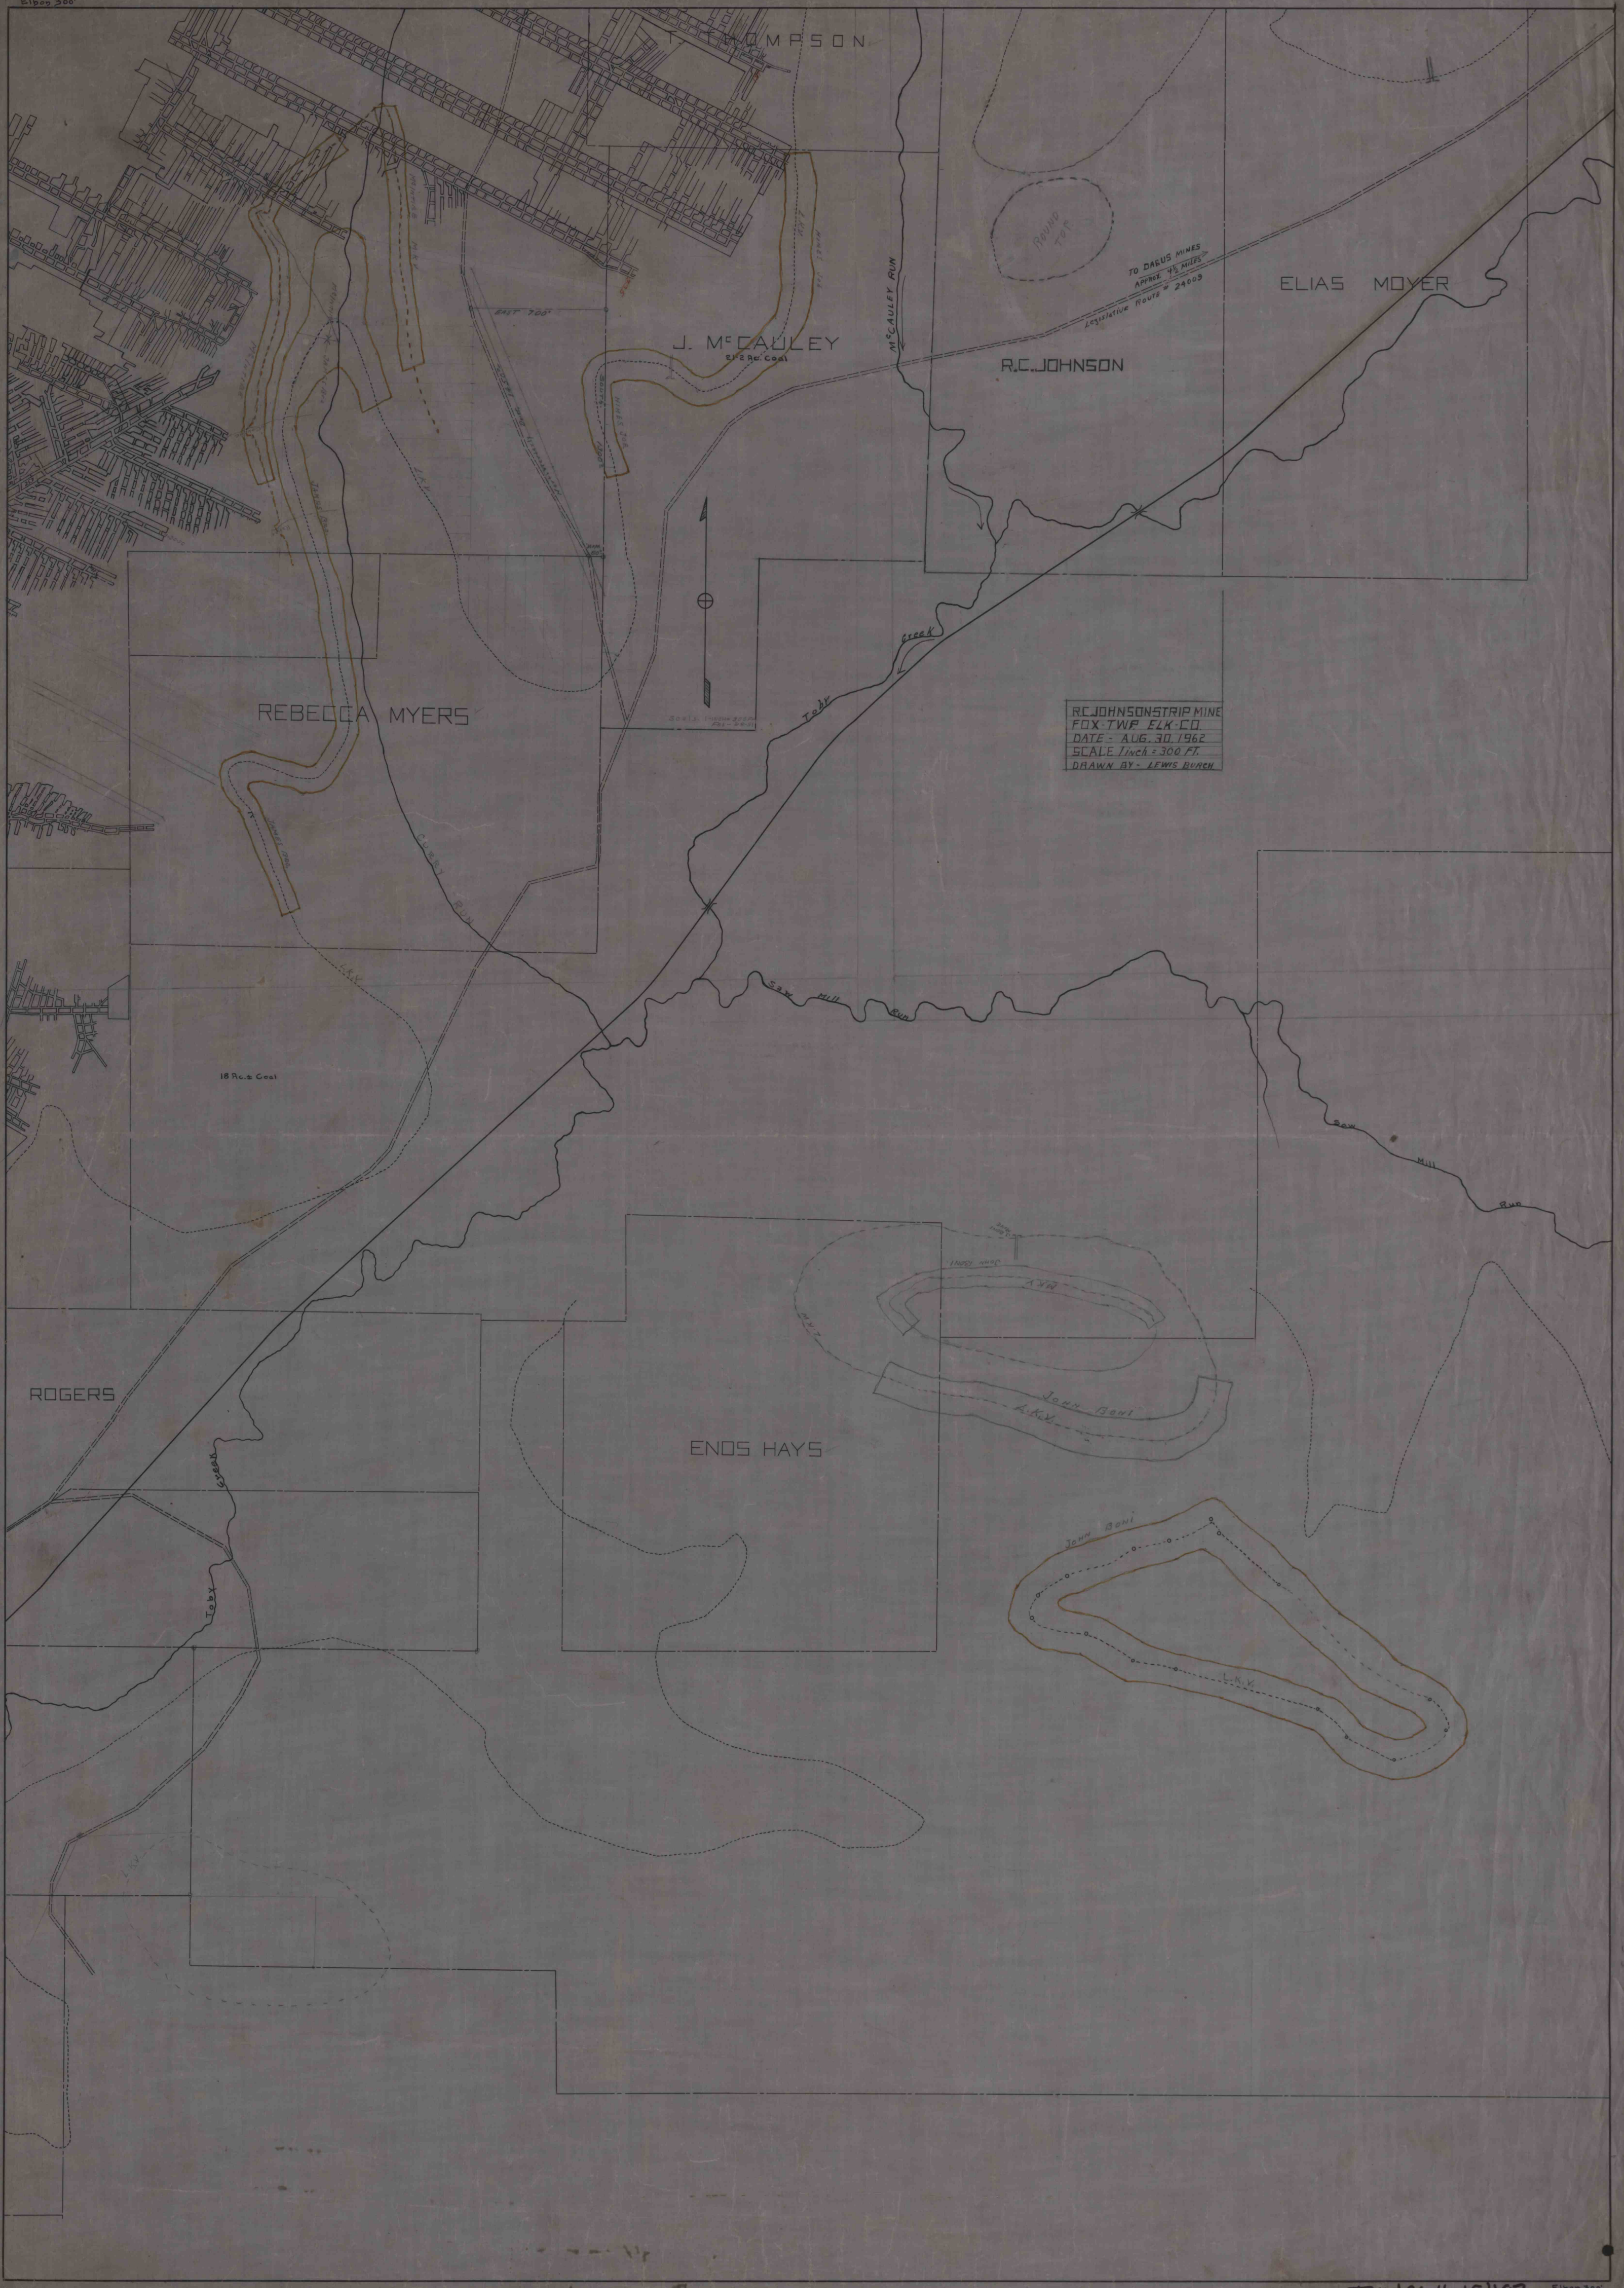

RC JOHNSON STRIP MINE
FOX-TWP ELK CO.
DATE - AUG. 30, 1962
SCALE 1 inch = 300 FT.
DRAWN BY - LEWIS BURCH