


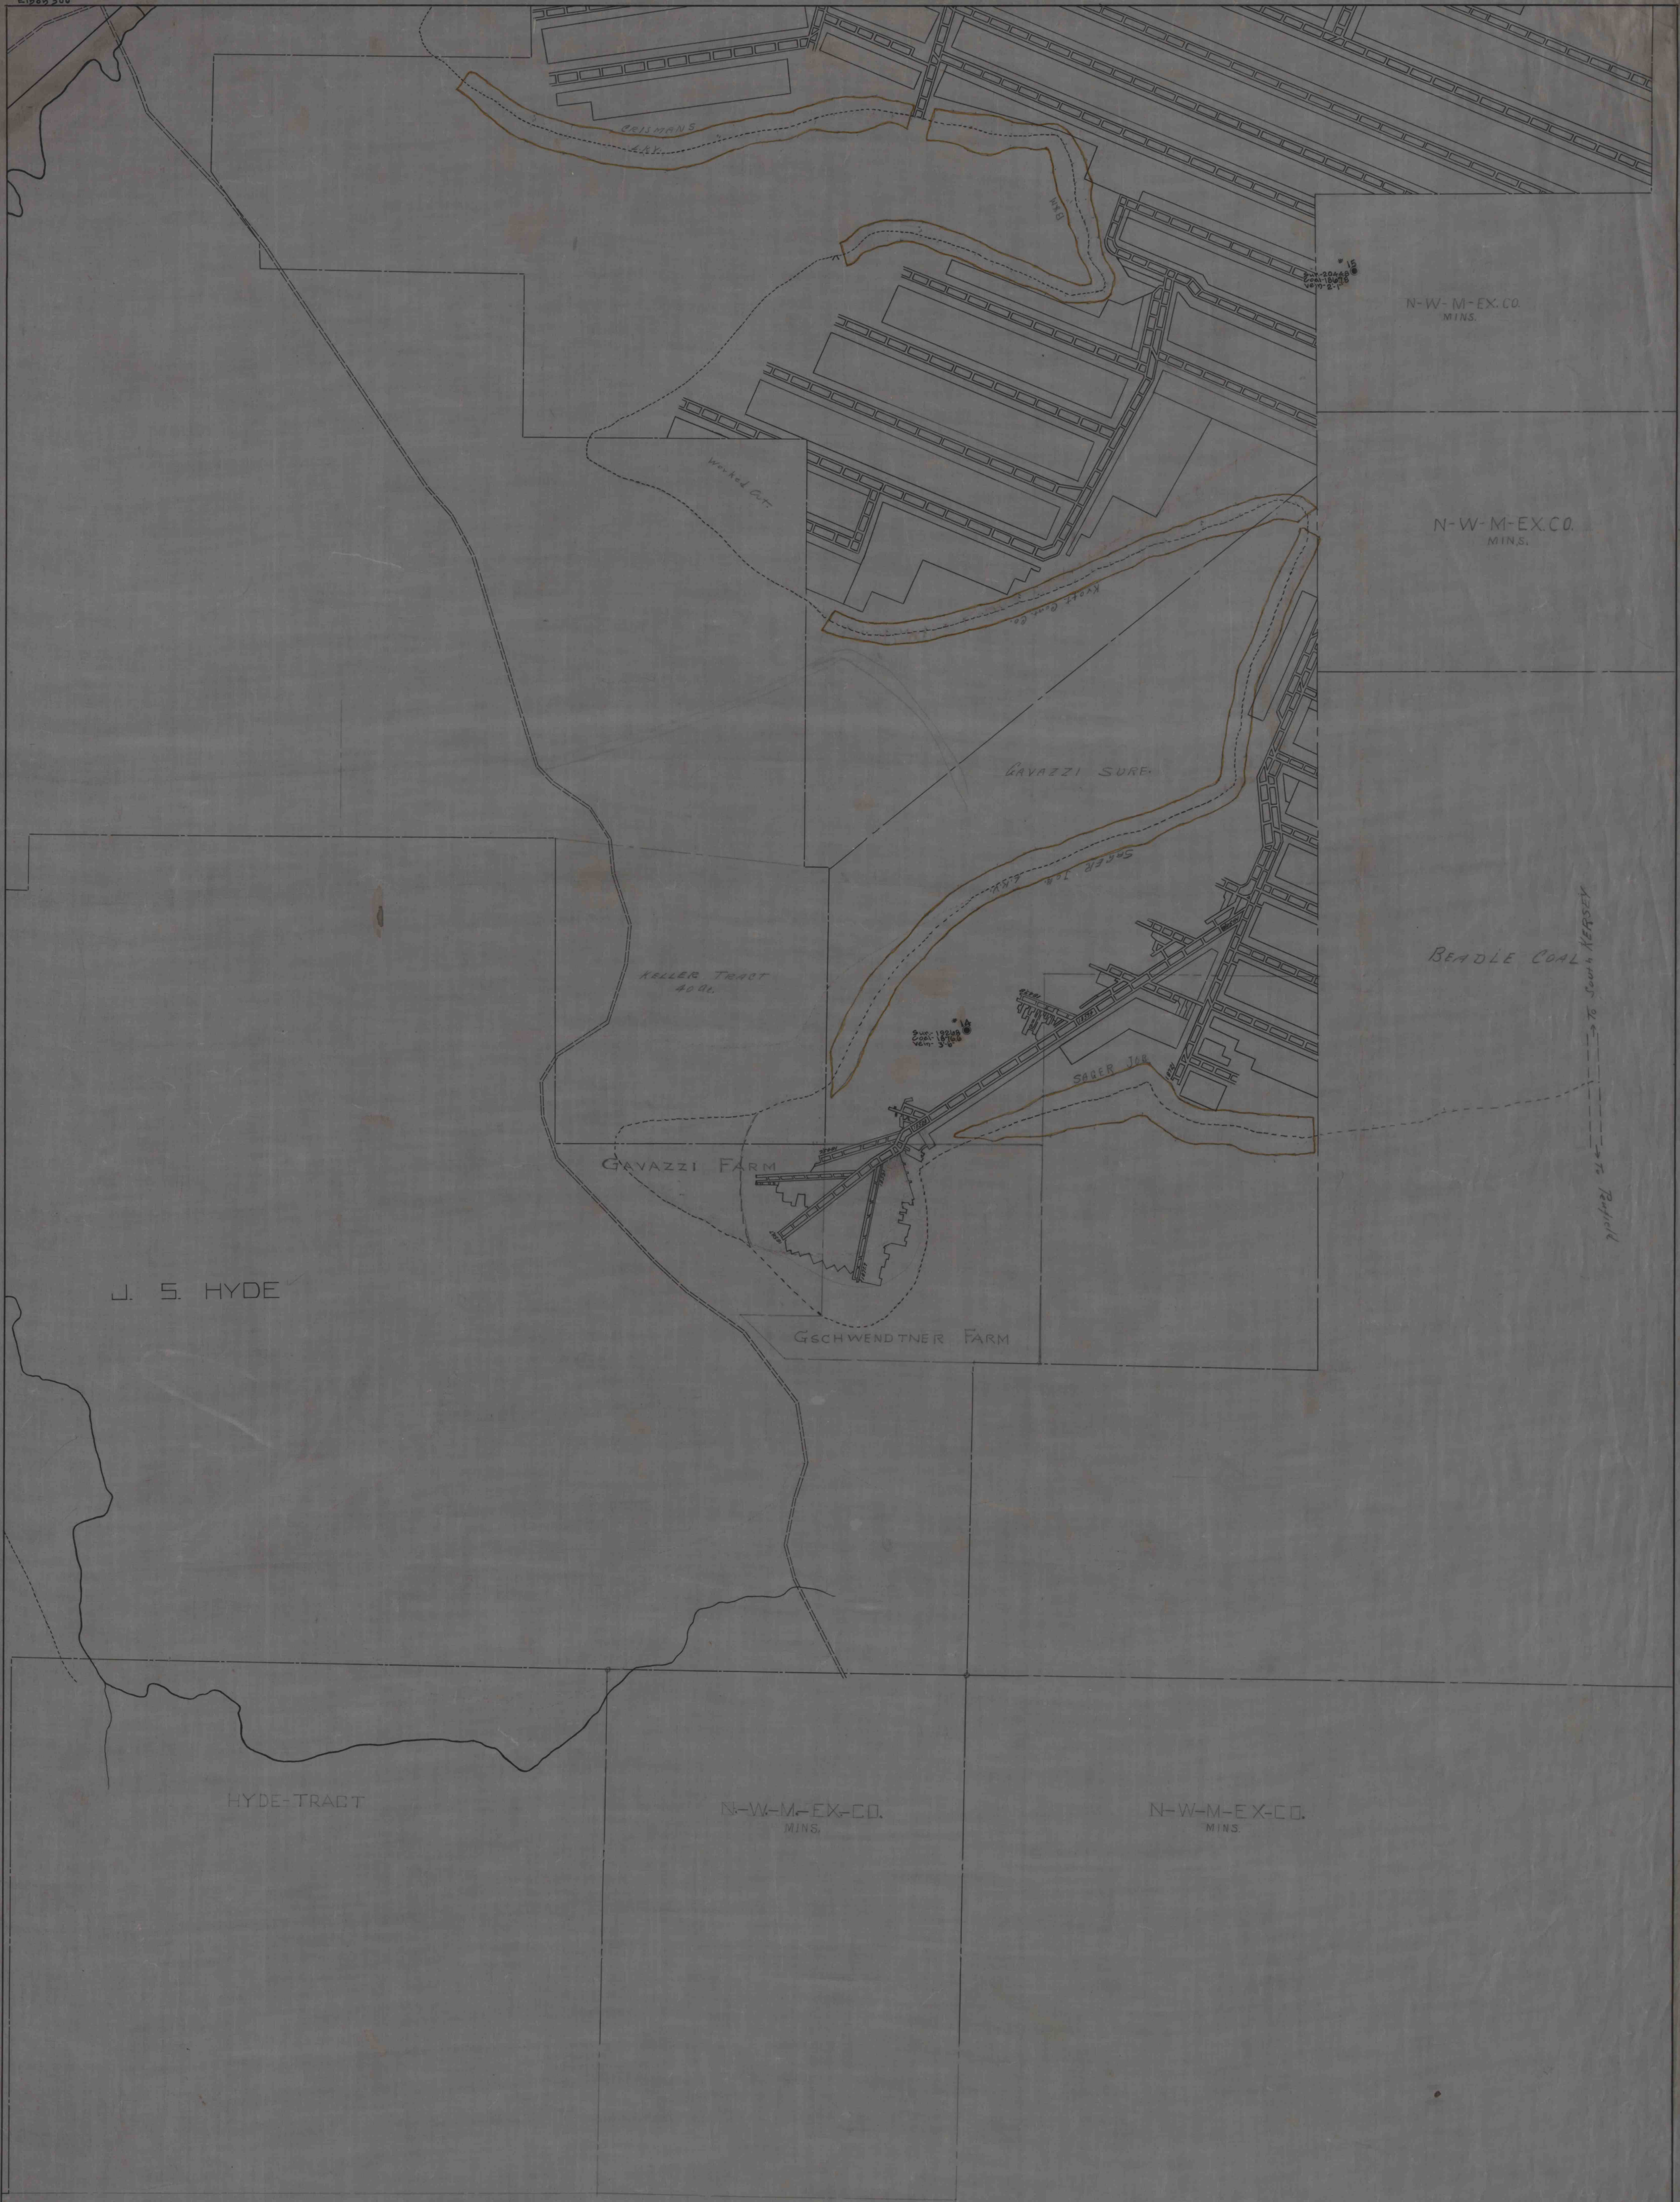

N-W-M-EX.CO.
MINS.

N-W-M-EX.CO.
MINS.

KELLER TRACT
4000

GAYAZZI FARM

GESCHWENDTNER FARM

GAYAZZI SURF

SAGER 178

BEADLE COAL

TO RAILROAD

J. S. HYDE

HYDE-TRACT

N-W-M-EX.CO.
MINS.

N-W-M-EX.CO.
MINS.