




July - 6 - 1950

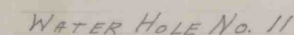

JULY- 7-1950

 

July - 7 - 1950

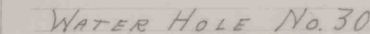

Scale 1-Inch = 100 Ft.

IMAPS# 15533 ~~15533~~