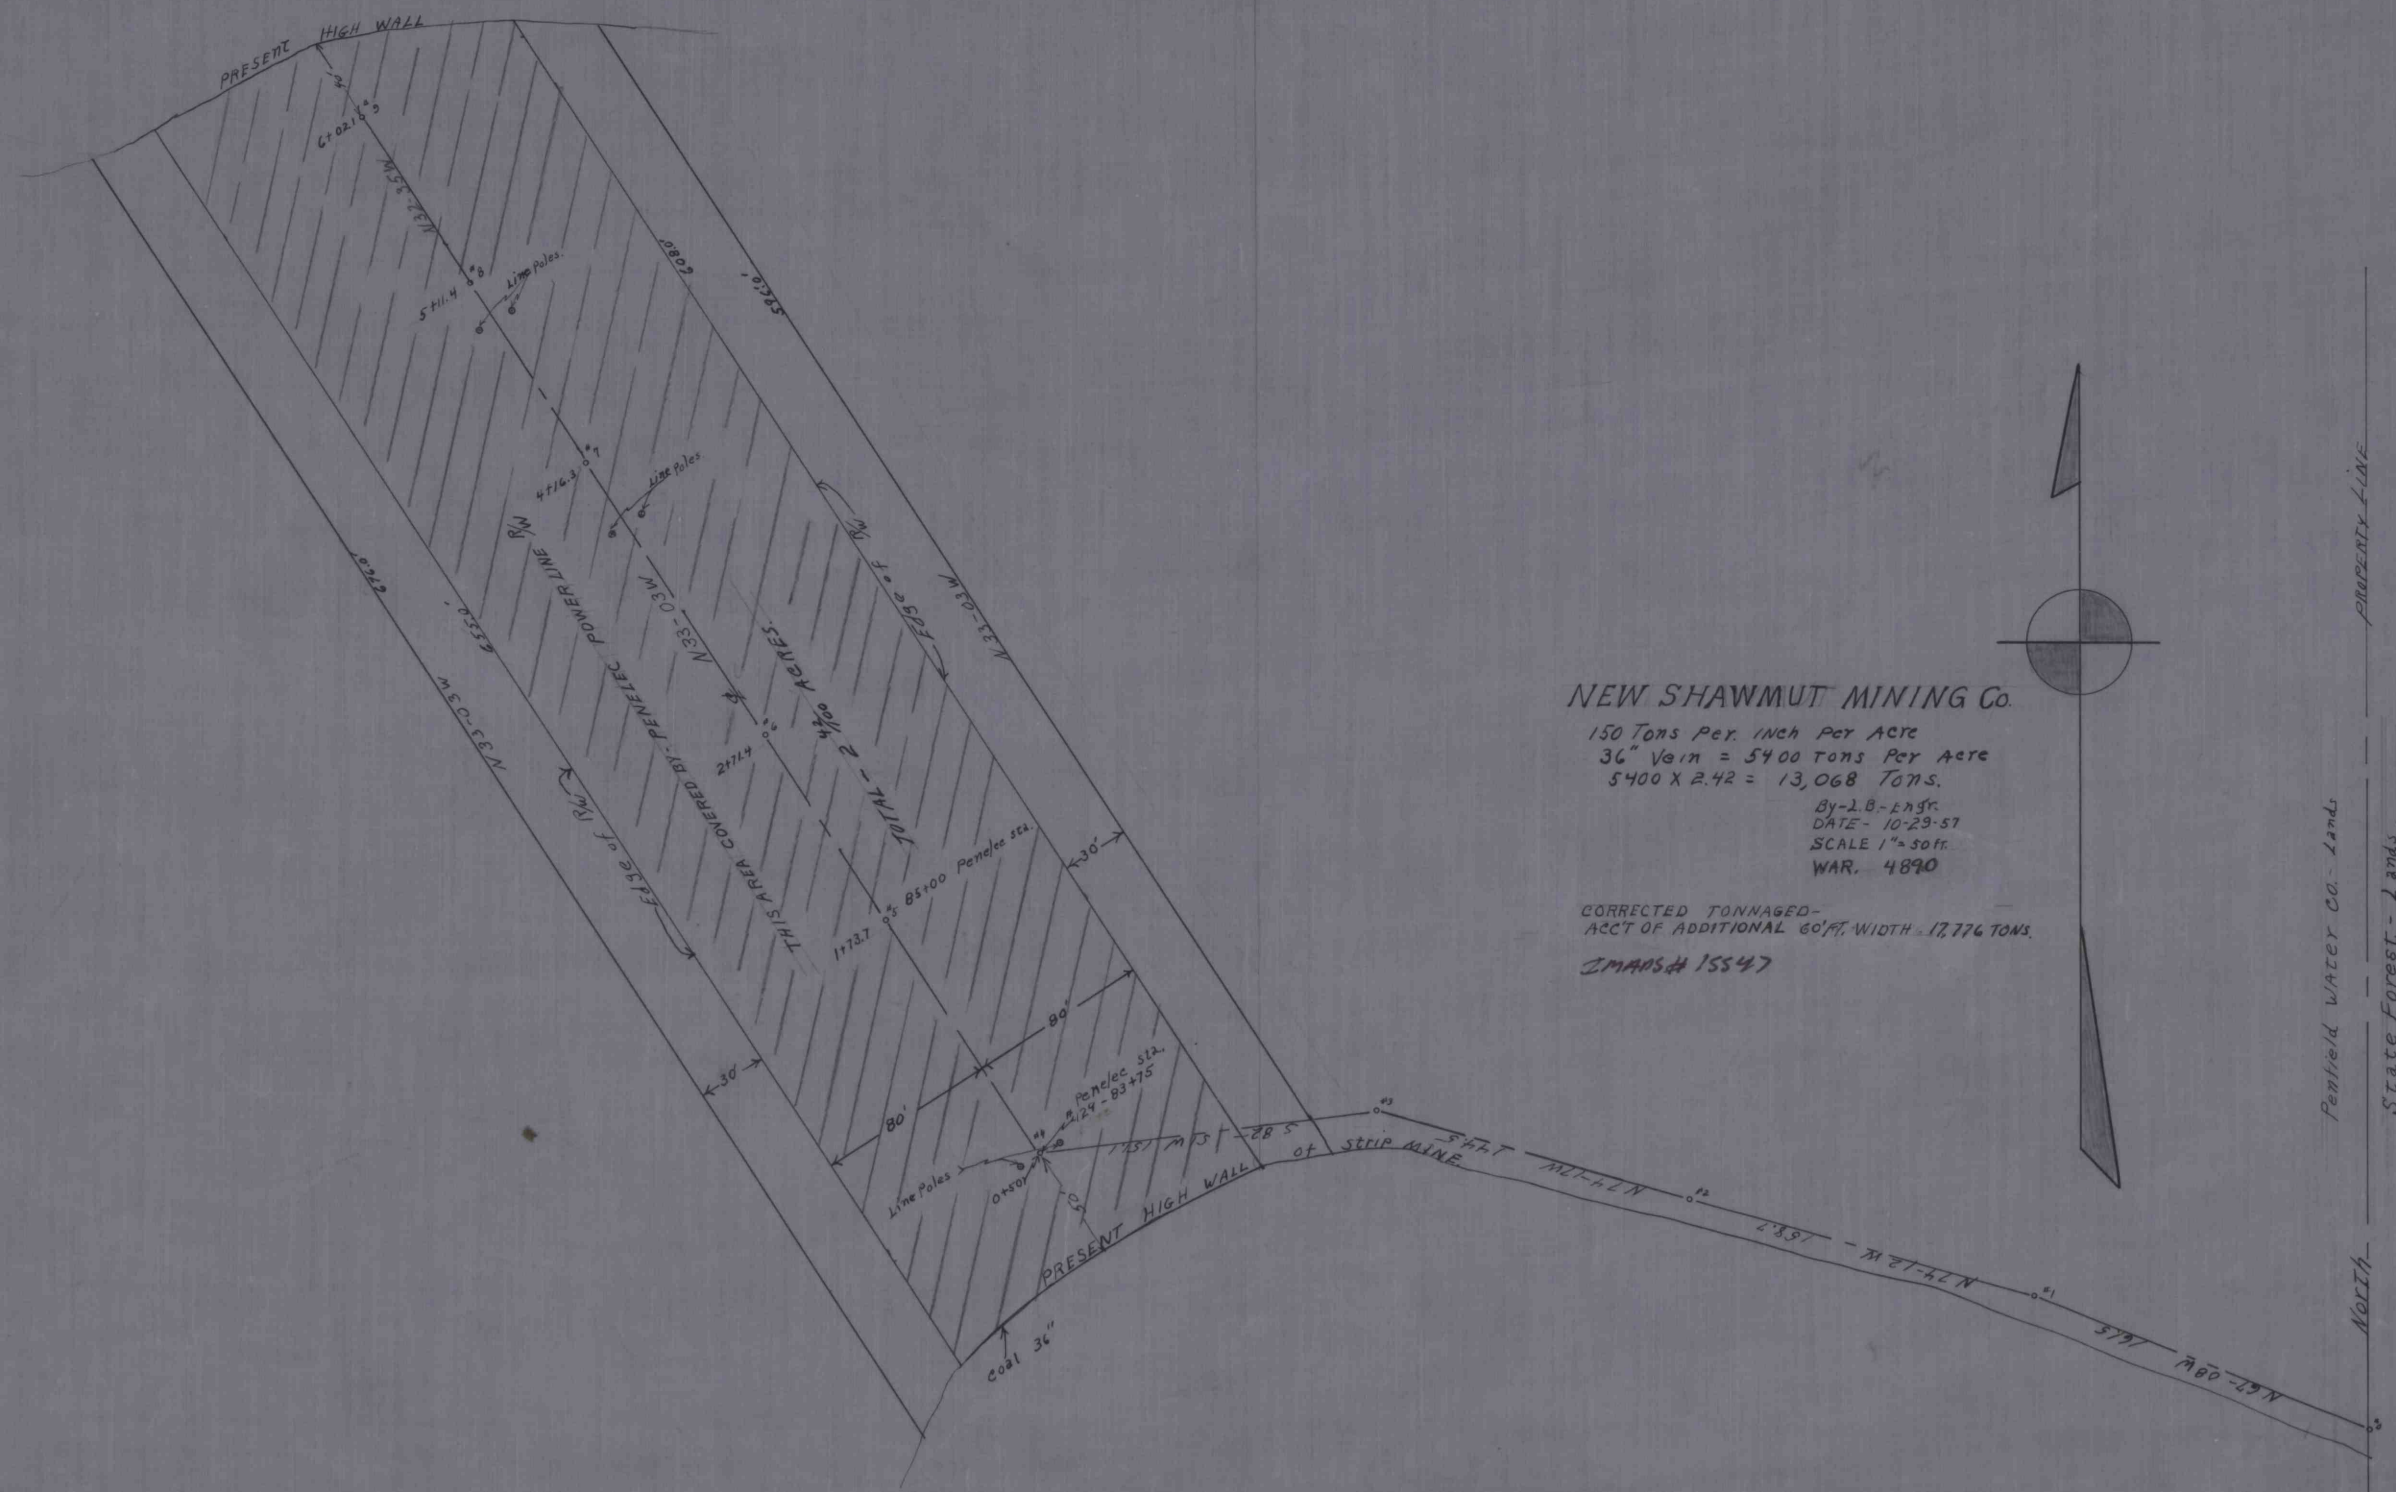

NEW SHAWMUT MINING Co.

150 Tons Per. inch Per Acre
36" Vein = 5400 tons Per Acre
5400 X 2.42 = 13,068 Tons.

By-L.B.-Engr.
DATE - 10-29-57
SCALE 1" = 50 ft.
WAR. 4890

CORRECTED TONNAGED-
ACC'T OF ADDITIONAL 60' FT. WIDTH = 17,776 TONS.

IMAPS # 15547

S-300' PRINT