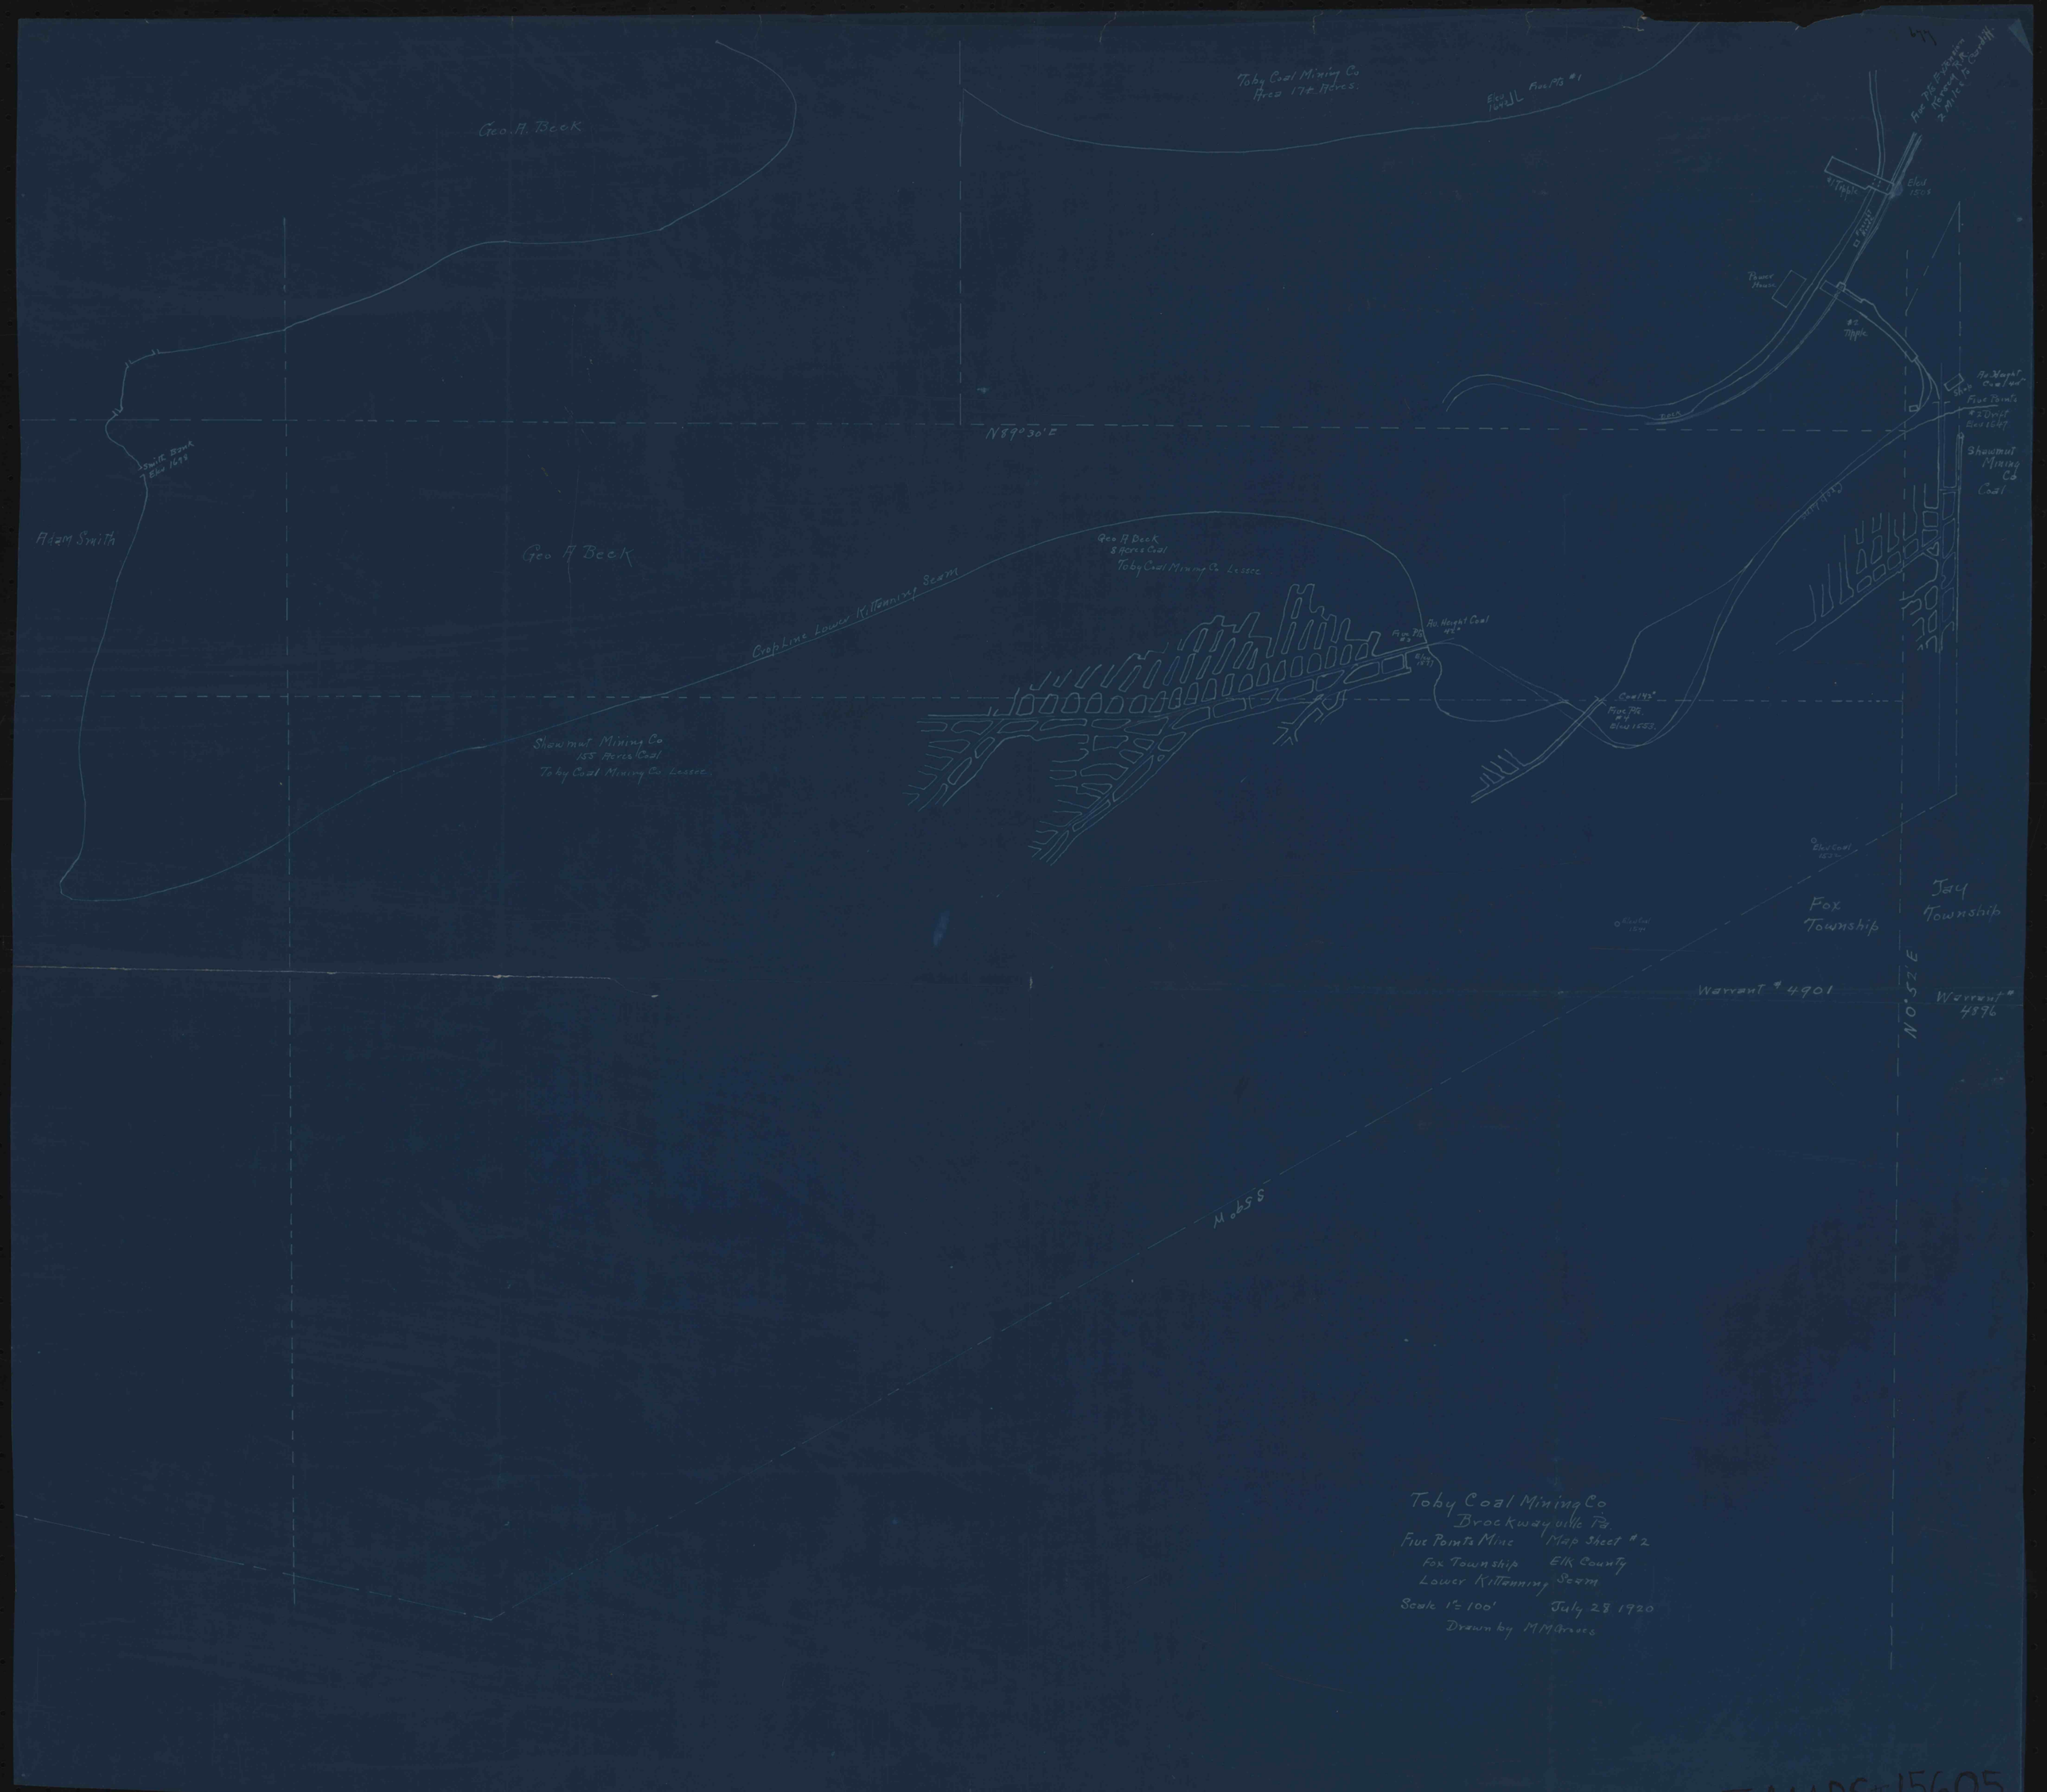

Toby Coal Mining Co
Brockwayville Pa.
Five Points Mine Map Sheet #2
Fox Township Elk County
Lower Kittanning Seam
Scale 1" = 100' July 28 1920
Drawn by M M Groves

IMAPS #15605