


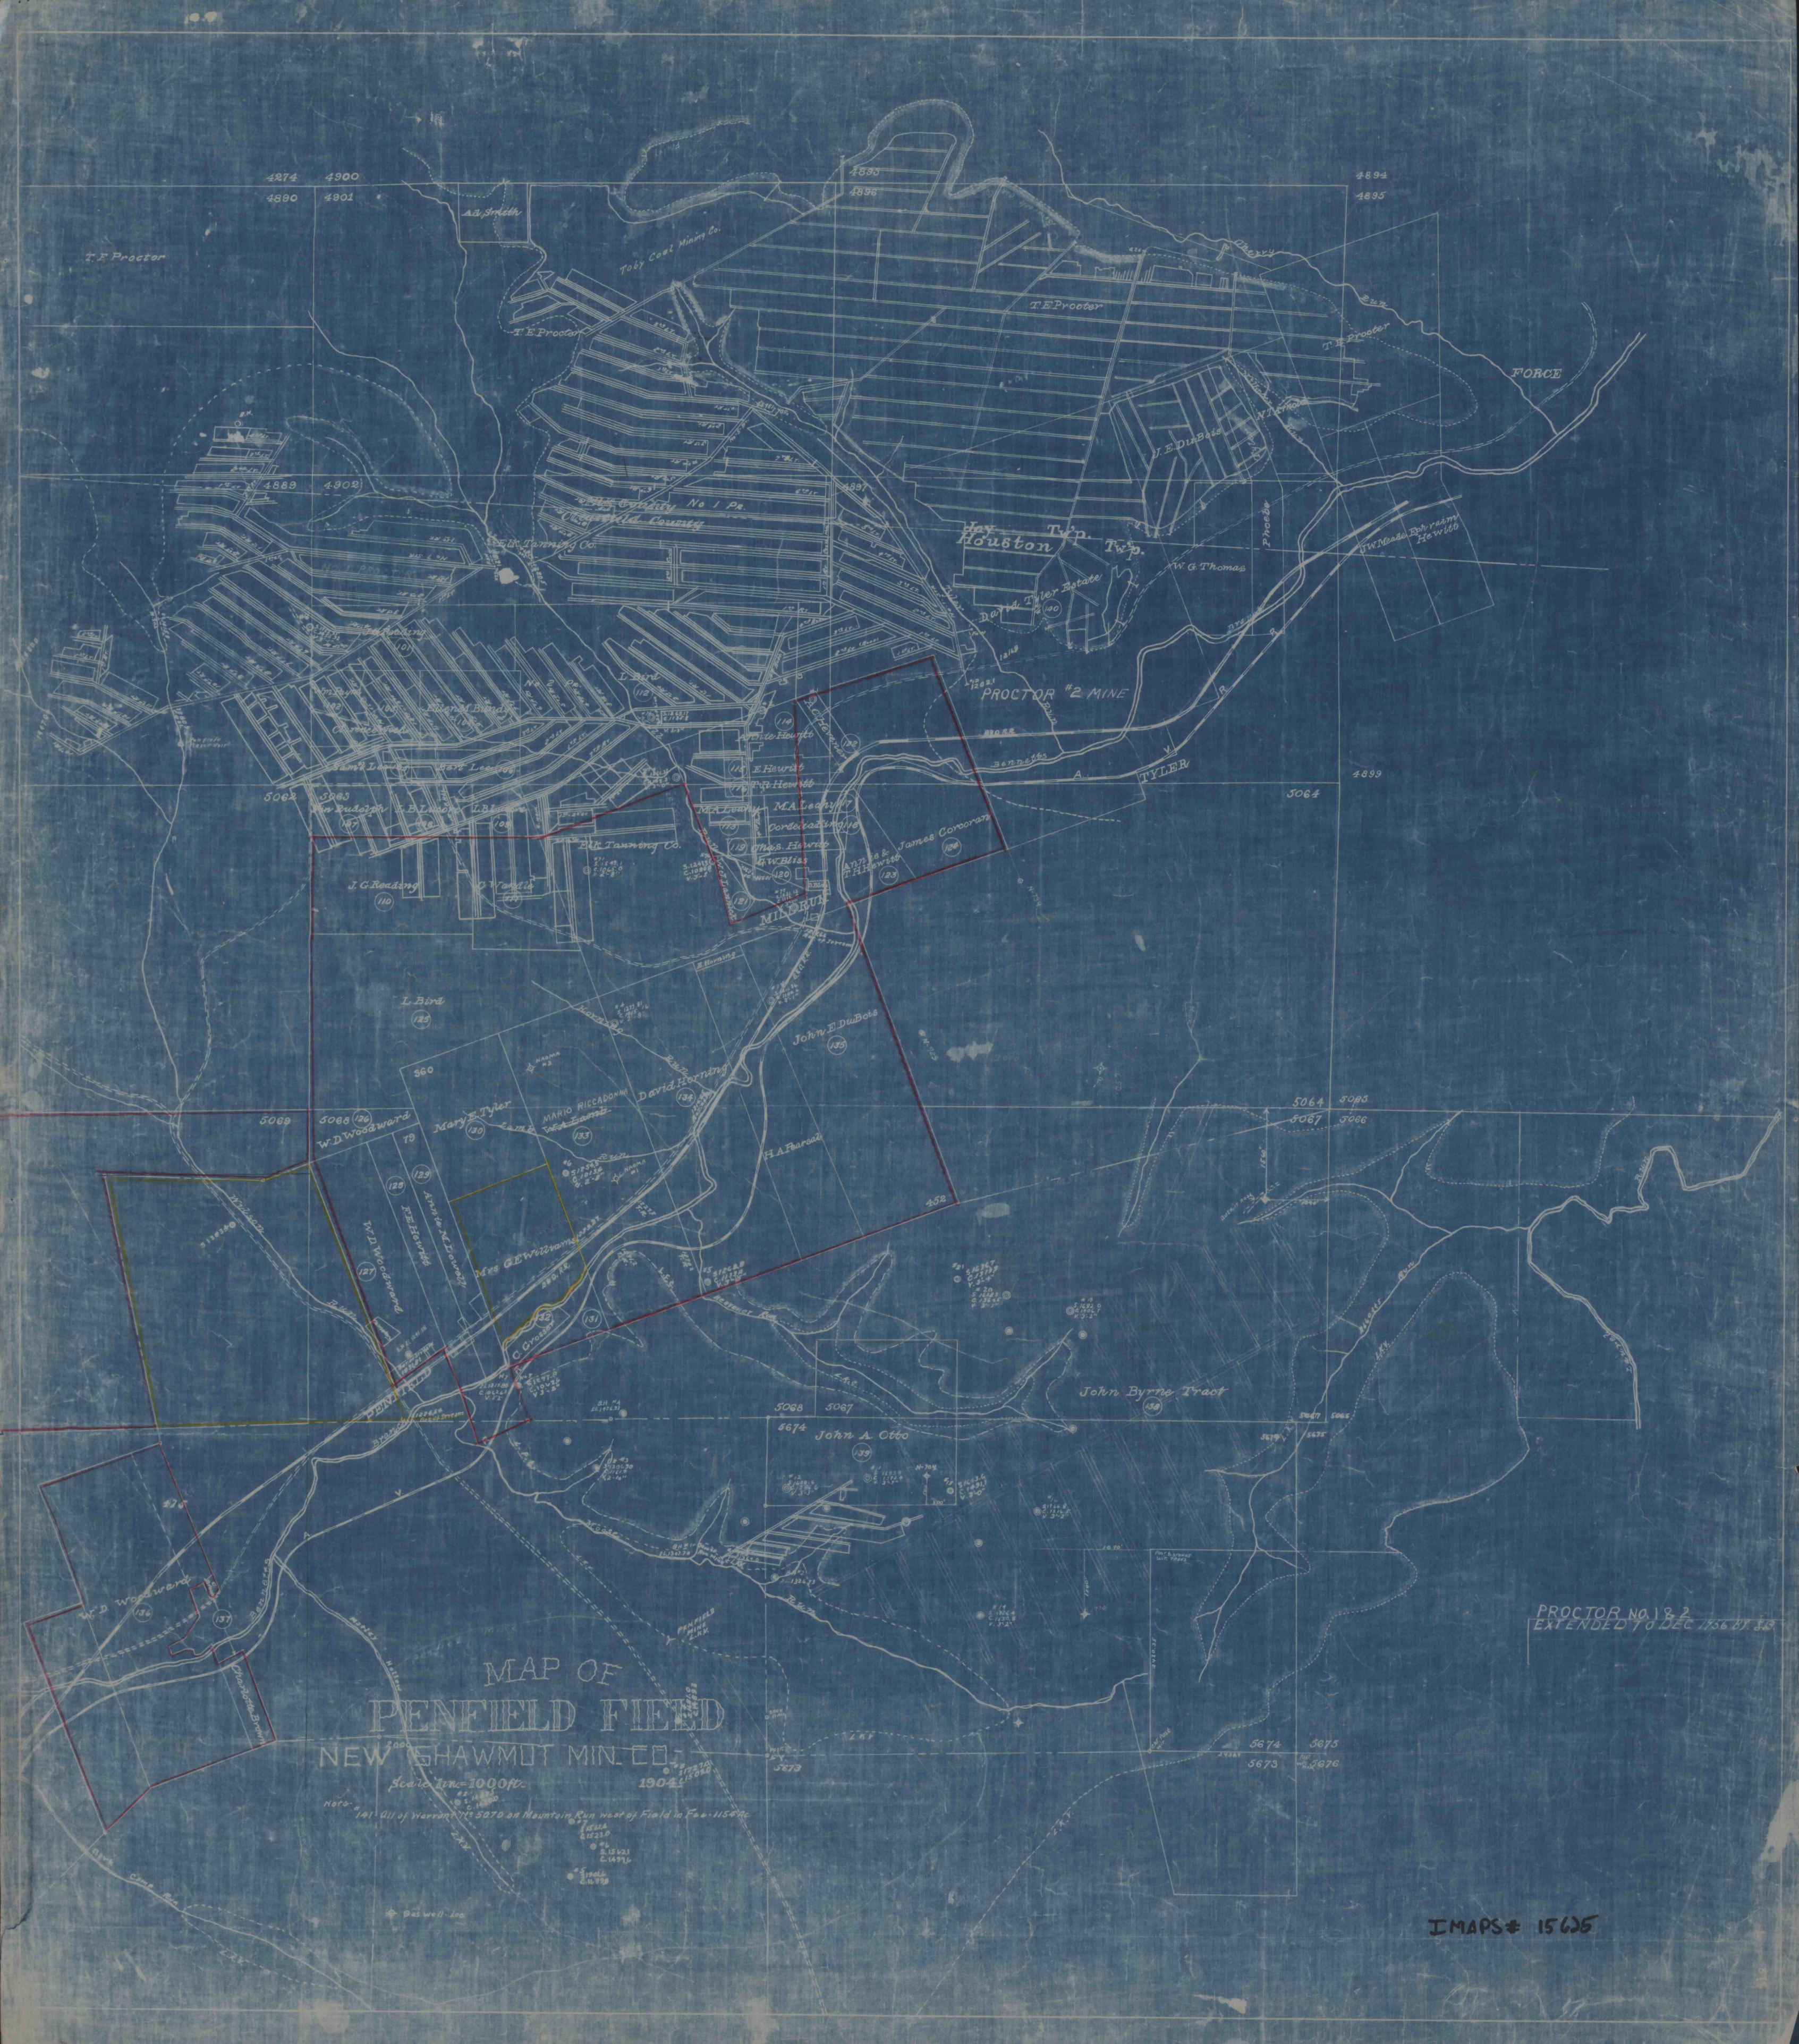

4874 4900
4890 4901

T.E. Procter

A.B. Smith

Toby Coal Mining Co.

4889
4896

4894
4895

T.E. Procter

T.E. Procter

FORCE

Houston Twp.
Twp.

David Tyler Estate

W. & Thomas

J.W. Meade, E. & W. Adams
Hewitt

PROCTOR #2 MINE

TYLER

5064

5062

5063

J.G. Reading

W.D. Woodward









L. Bird

Mary E. Tyler

MARIO RICCADONNA

David Horning

H.A. Burrell

John E. DuBois

John A. Otto

John Byrne Tract












MAP OF PENFIELD FIELD

NEW SHAWMUT MIN. CO.

Scale 1 in. = 1000 ft.

1904

Note: All of Warrant No. 5070 on Mountain Run west of Field in Feb. 1154 etc.

1856
21534
15521
14976
15529

PROCTOR No. 18.2
EXTENDED TO DEC. 1756 BY J.S.

IMAPS # 15625