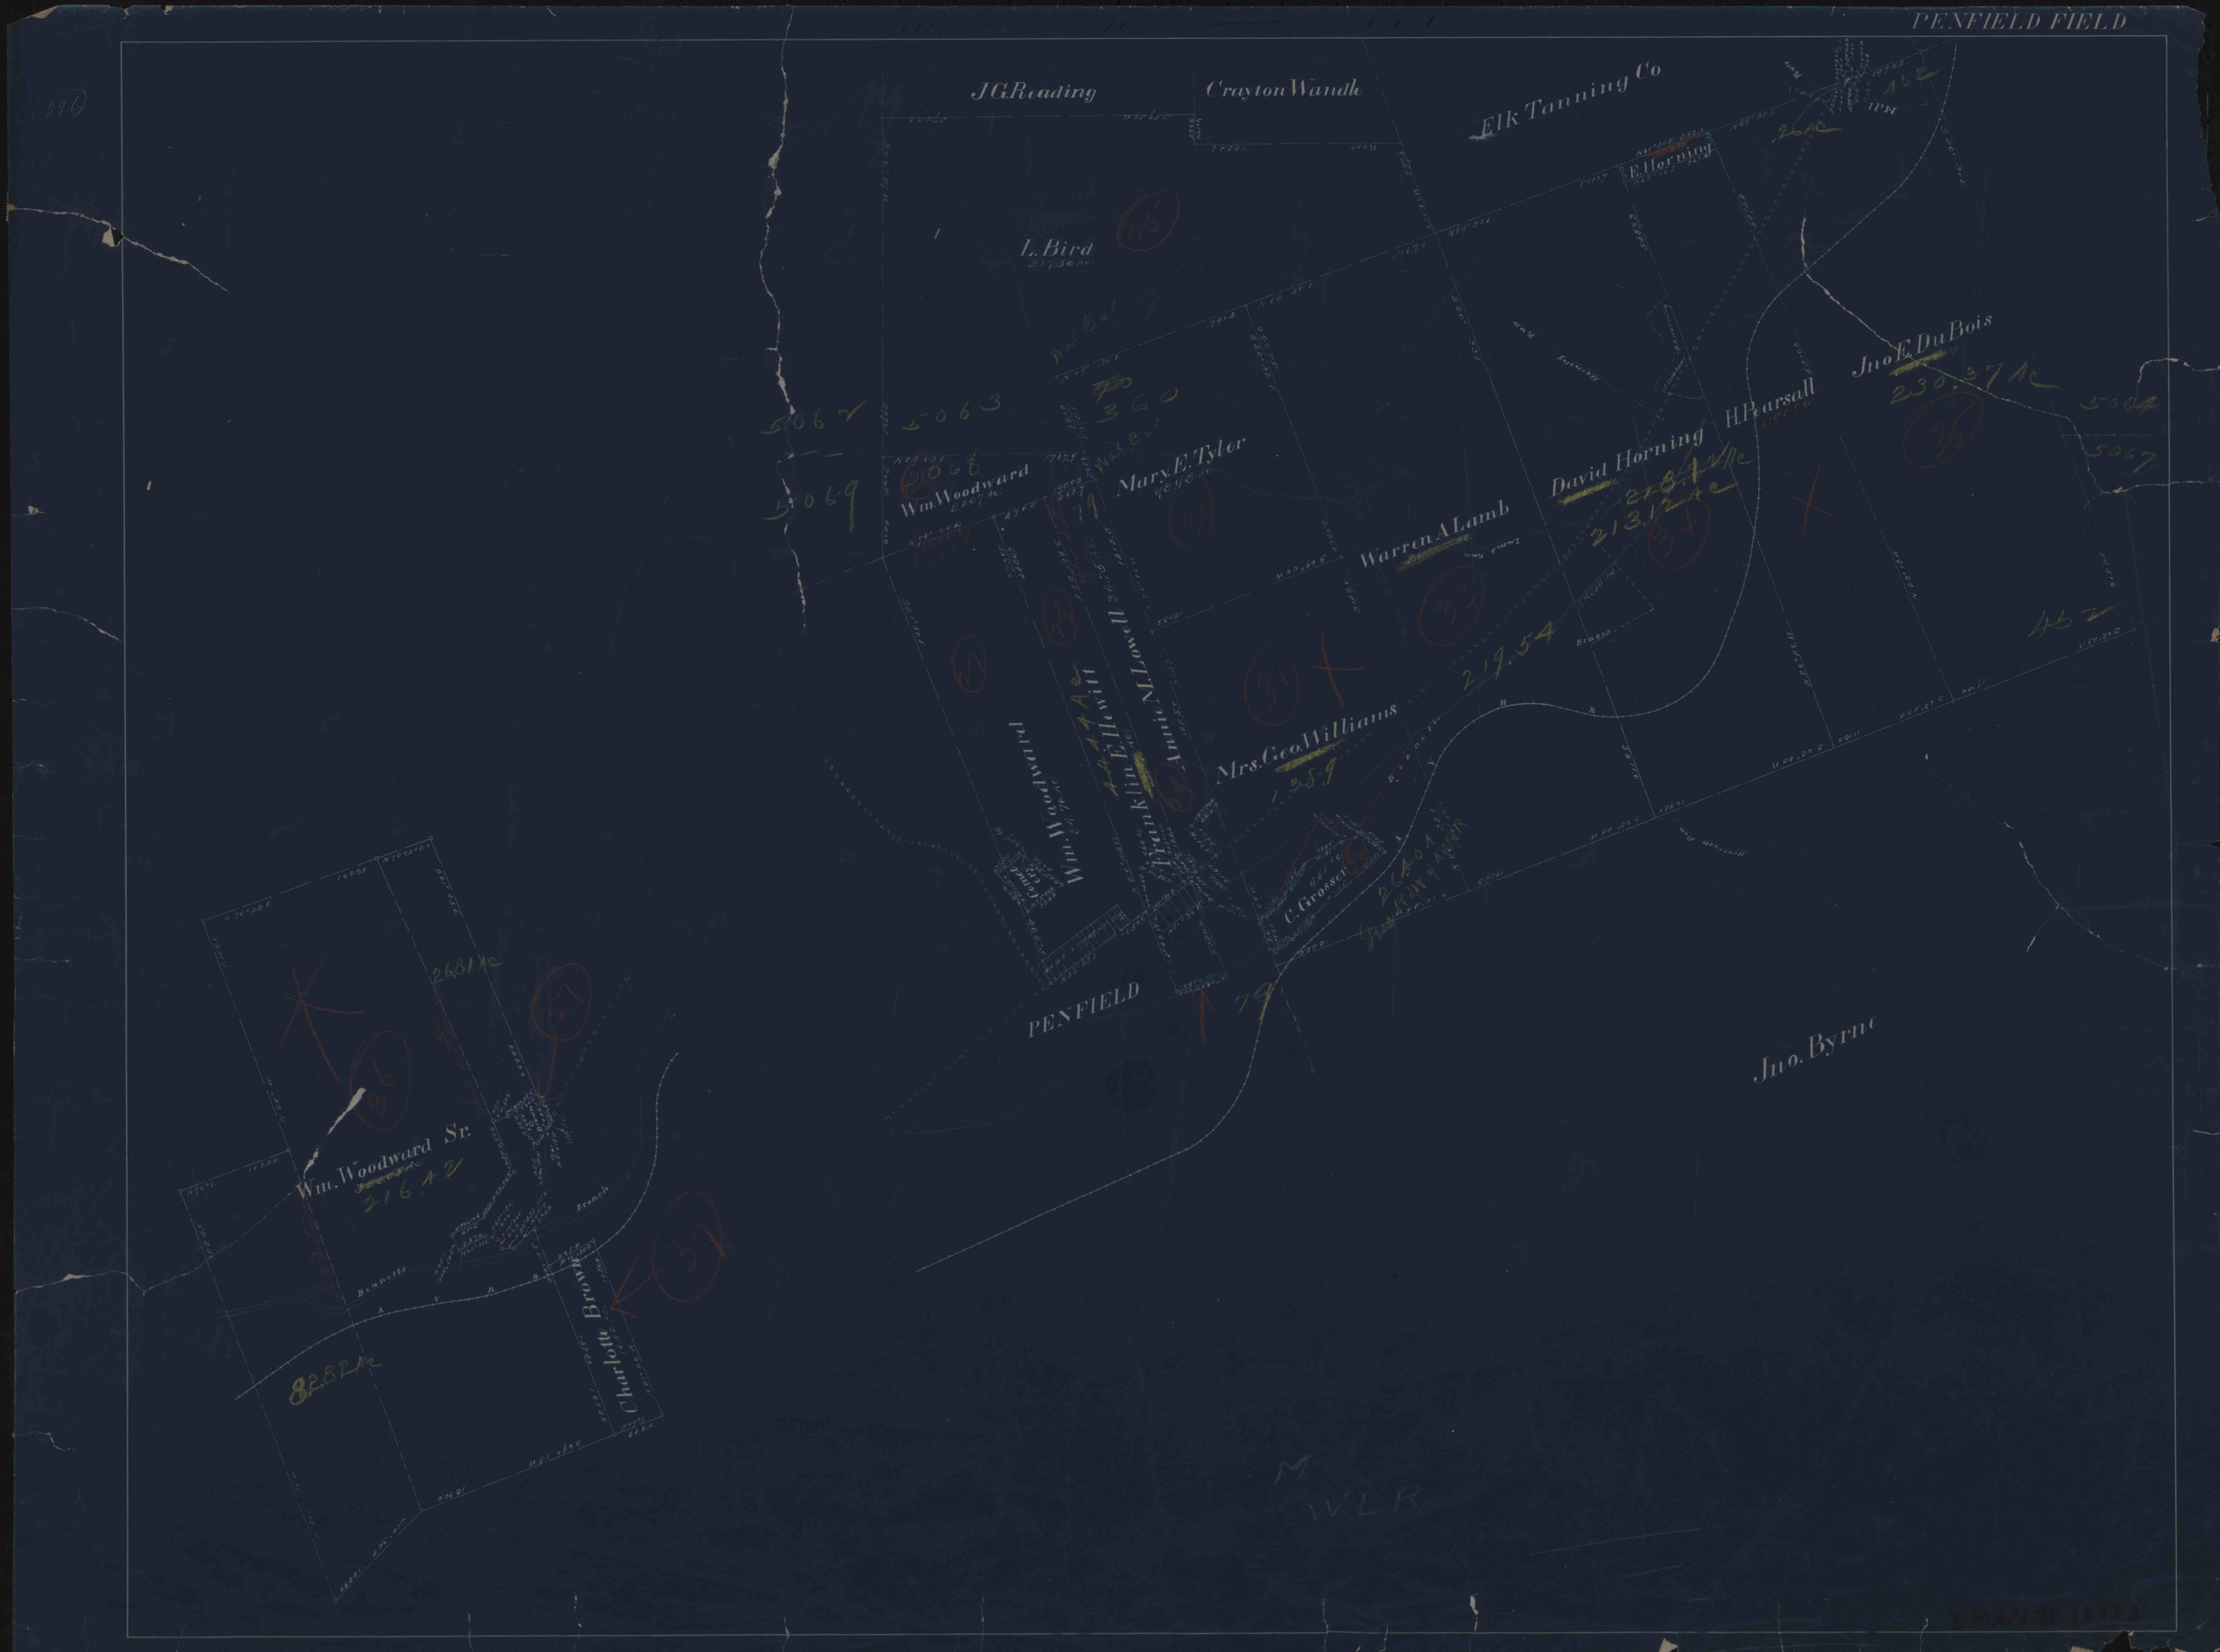
PENFIELD FIELD
J.G.Reading
Crayton Wandle
Elk Tanning Co
E.Horning
L.Bird
Wm Woodward
Mary E. Tyler
Warren A Lamb
David Horning
H.Pearsall
Jno E. Du Bois
Mrs. Geo. Williams
C. Grosser
PENFIELD
Jno. Byrne
Wm. Woodward Sr.
Charlotte Brown