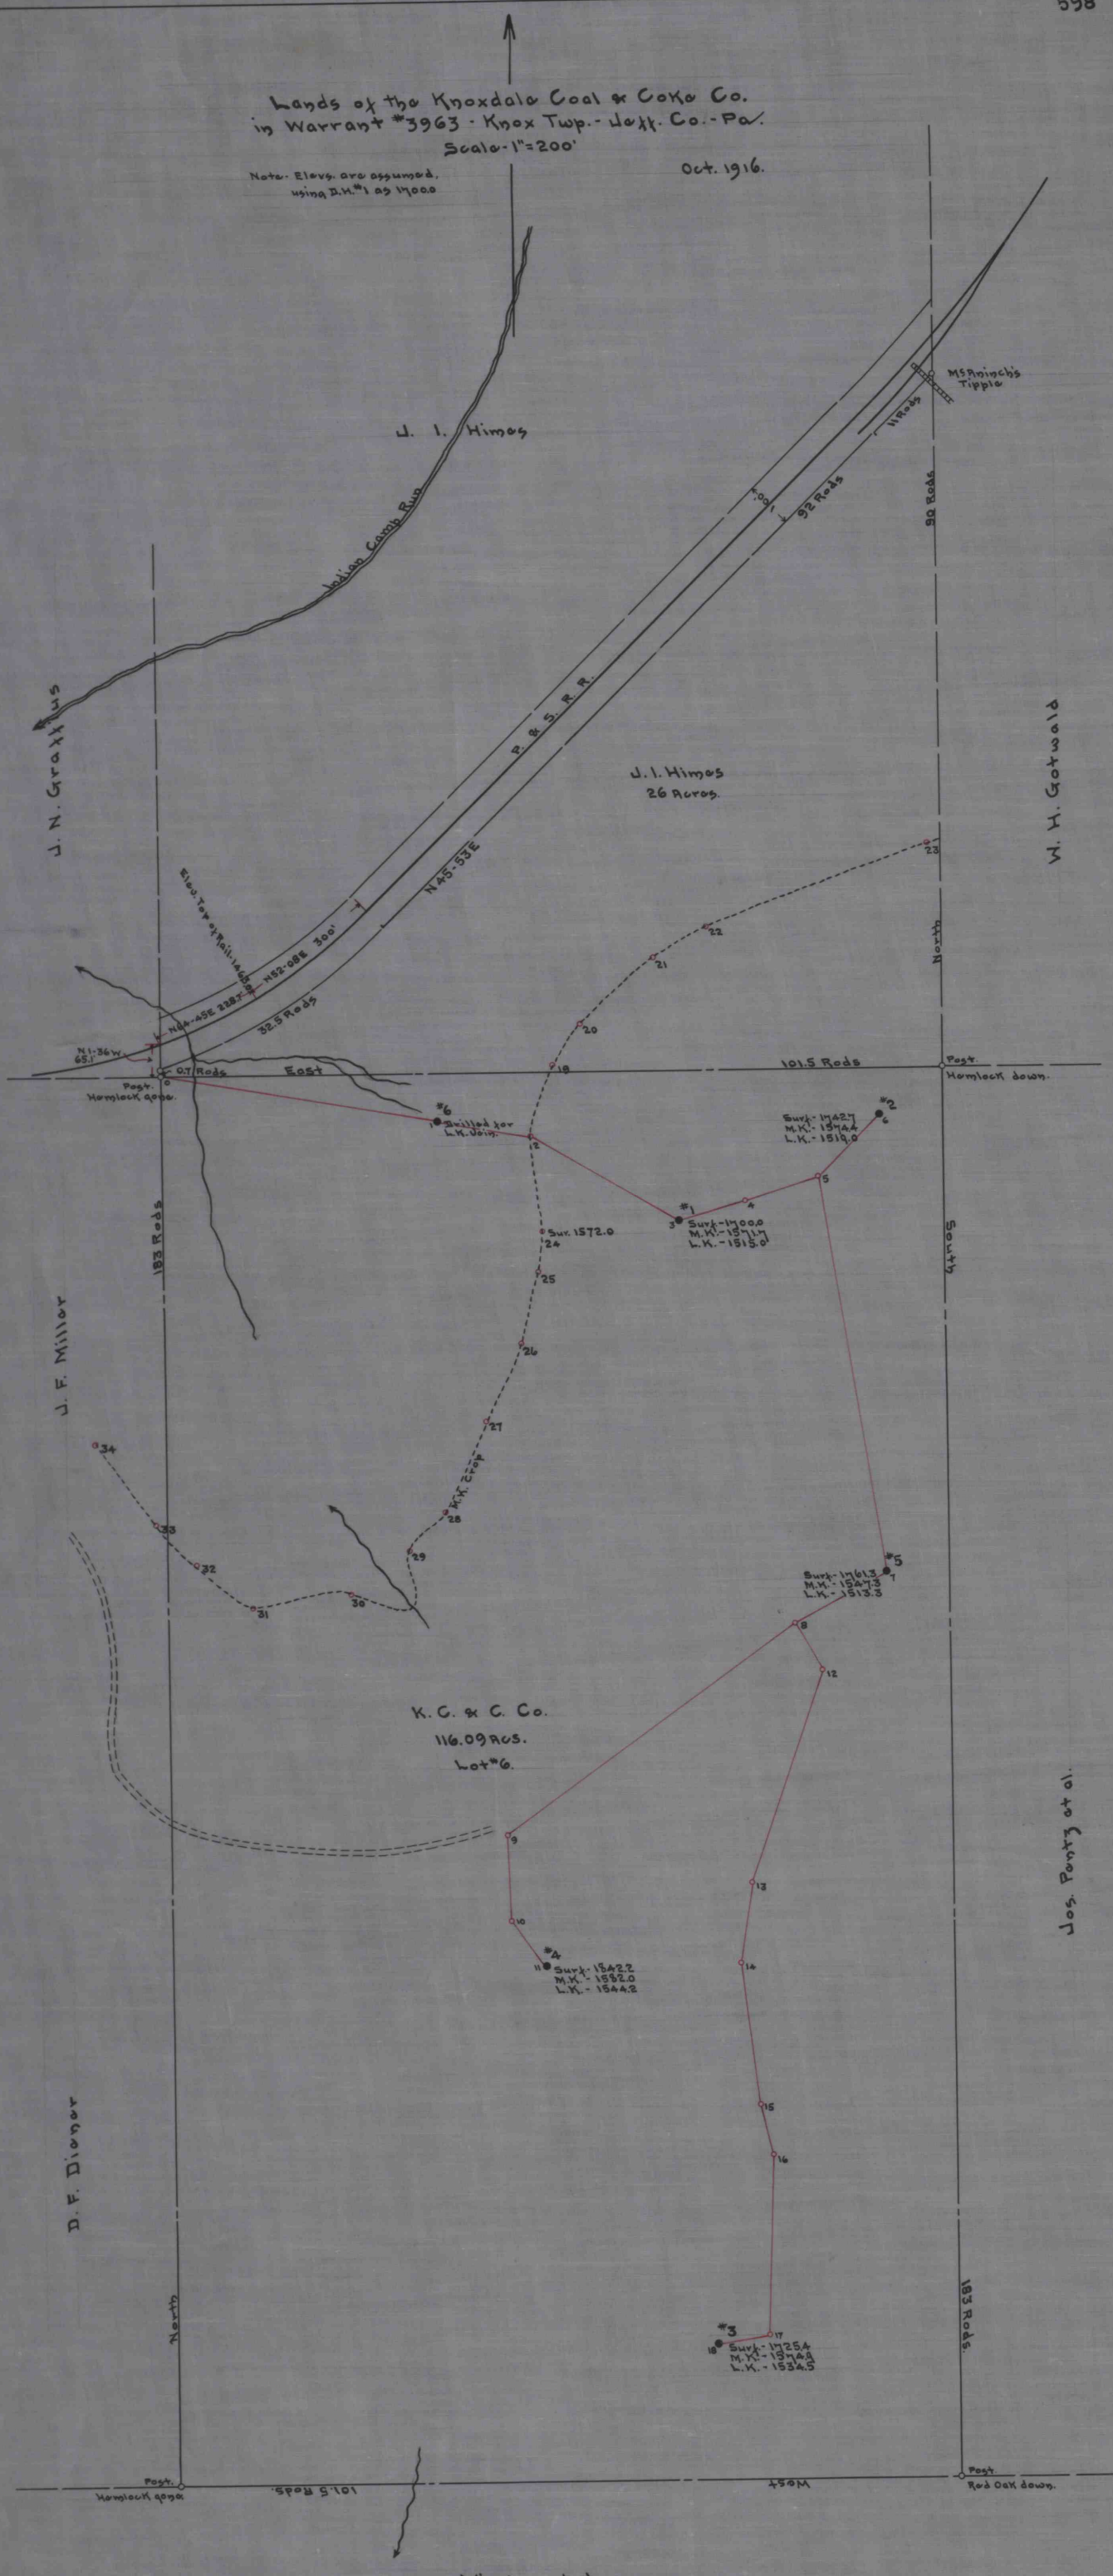

IMAP Sh 15638