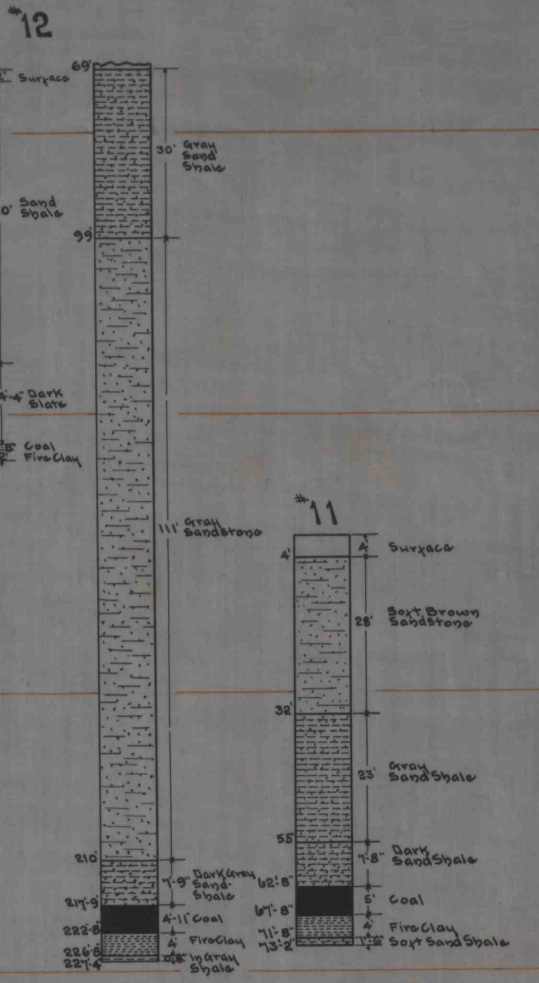
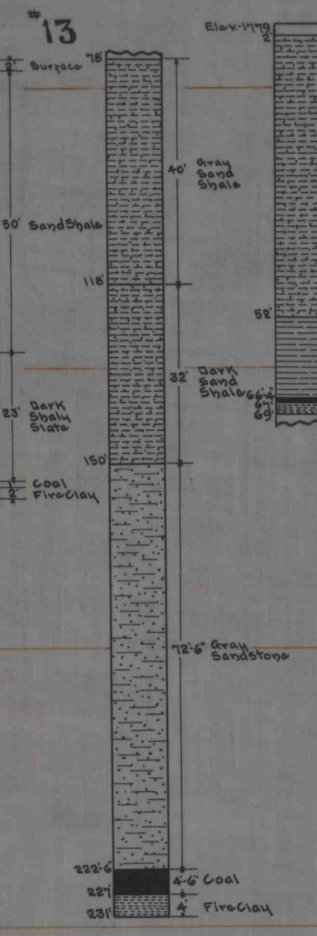
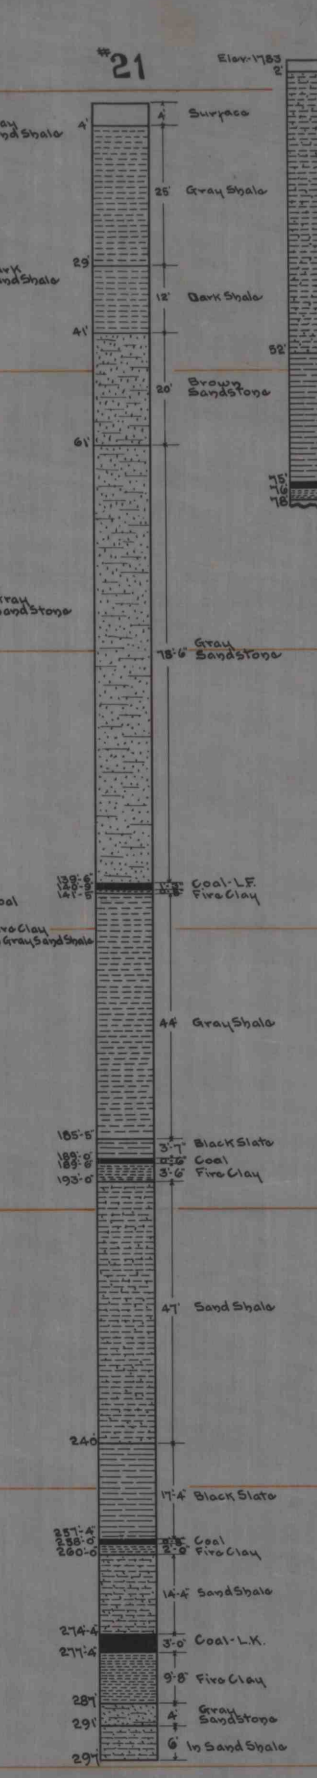
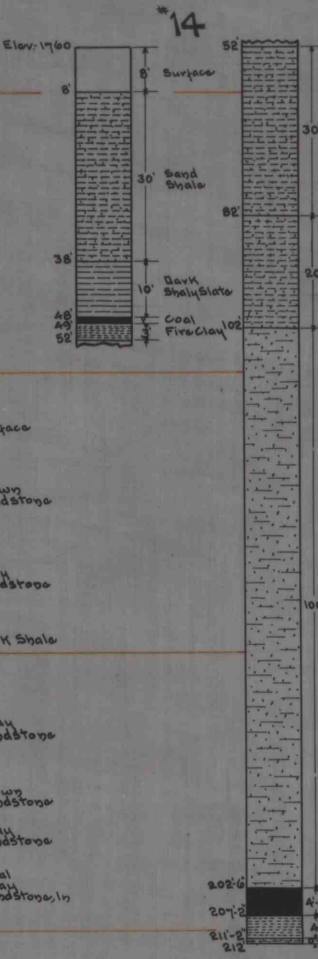
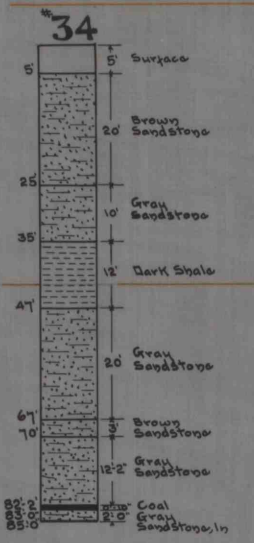
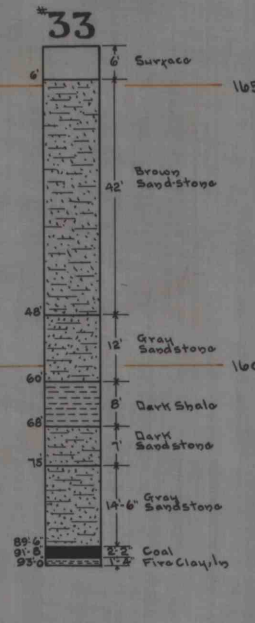
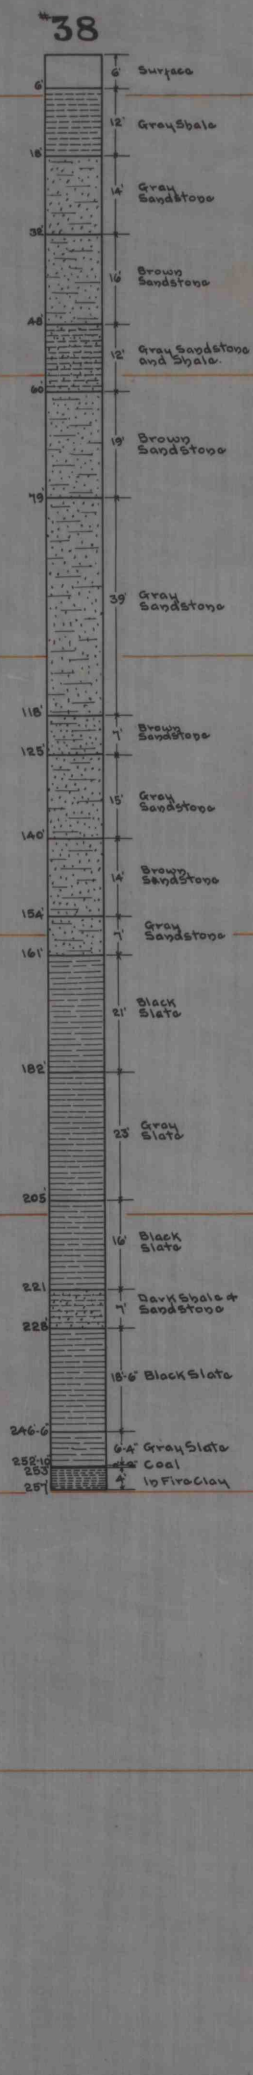
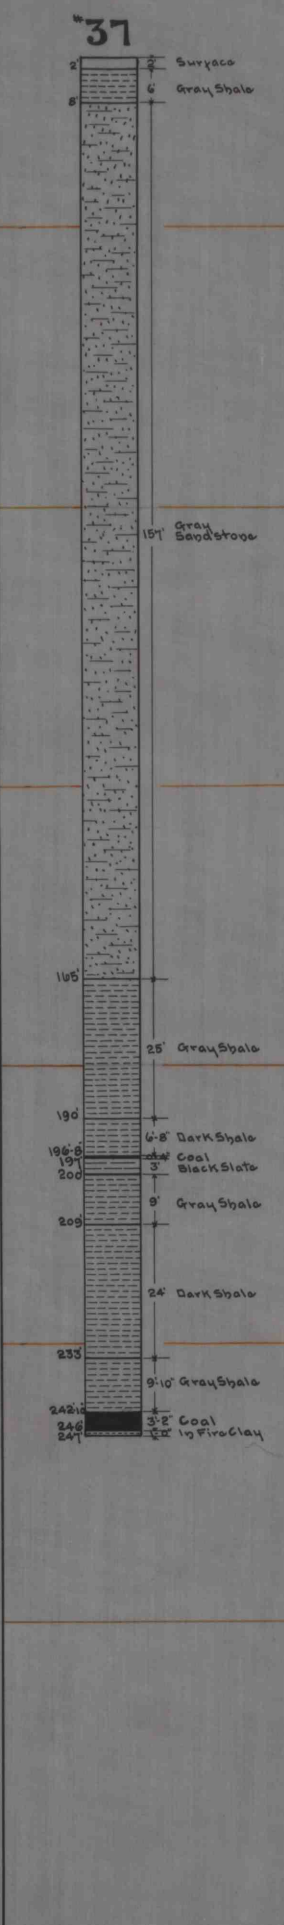
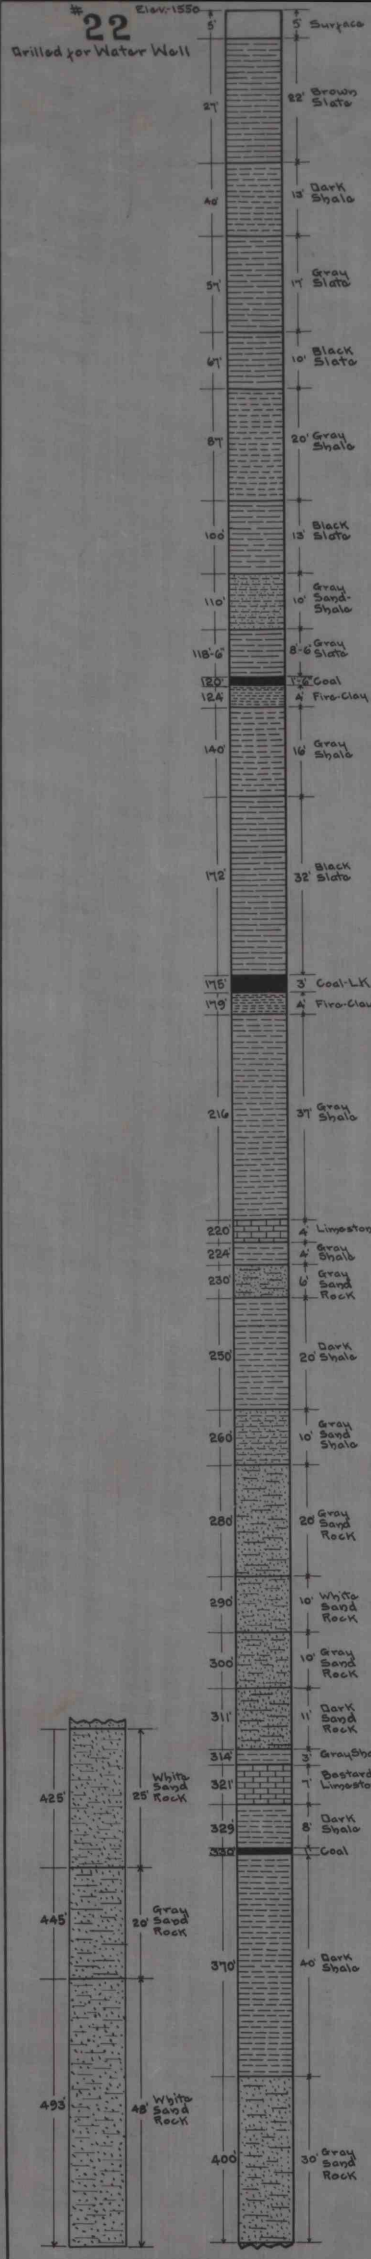


SHAWMUT MINING CO
DRILL-HOLE SECTIONS
IN
THE KNOXDALE FIELD

Date - May 23-1911
Scale - Ver. 1"=20'
Drawn by - P.O.O.
Approved -
Chief Eng.