


588-36E 228.8'
N 00-52 W
N 00-19 W 233.5'
M 81-00 S
589.5'

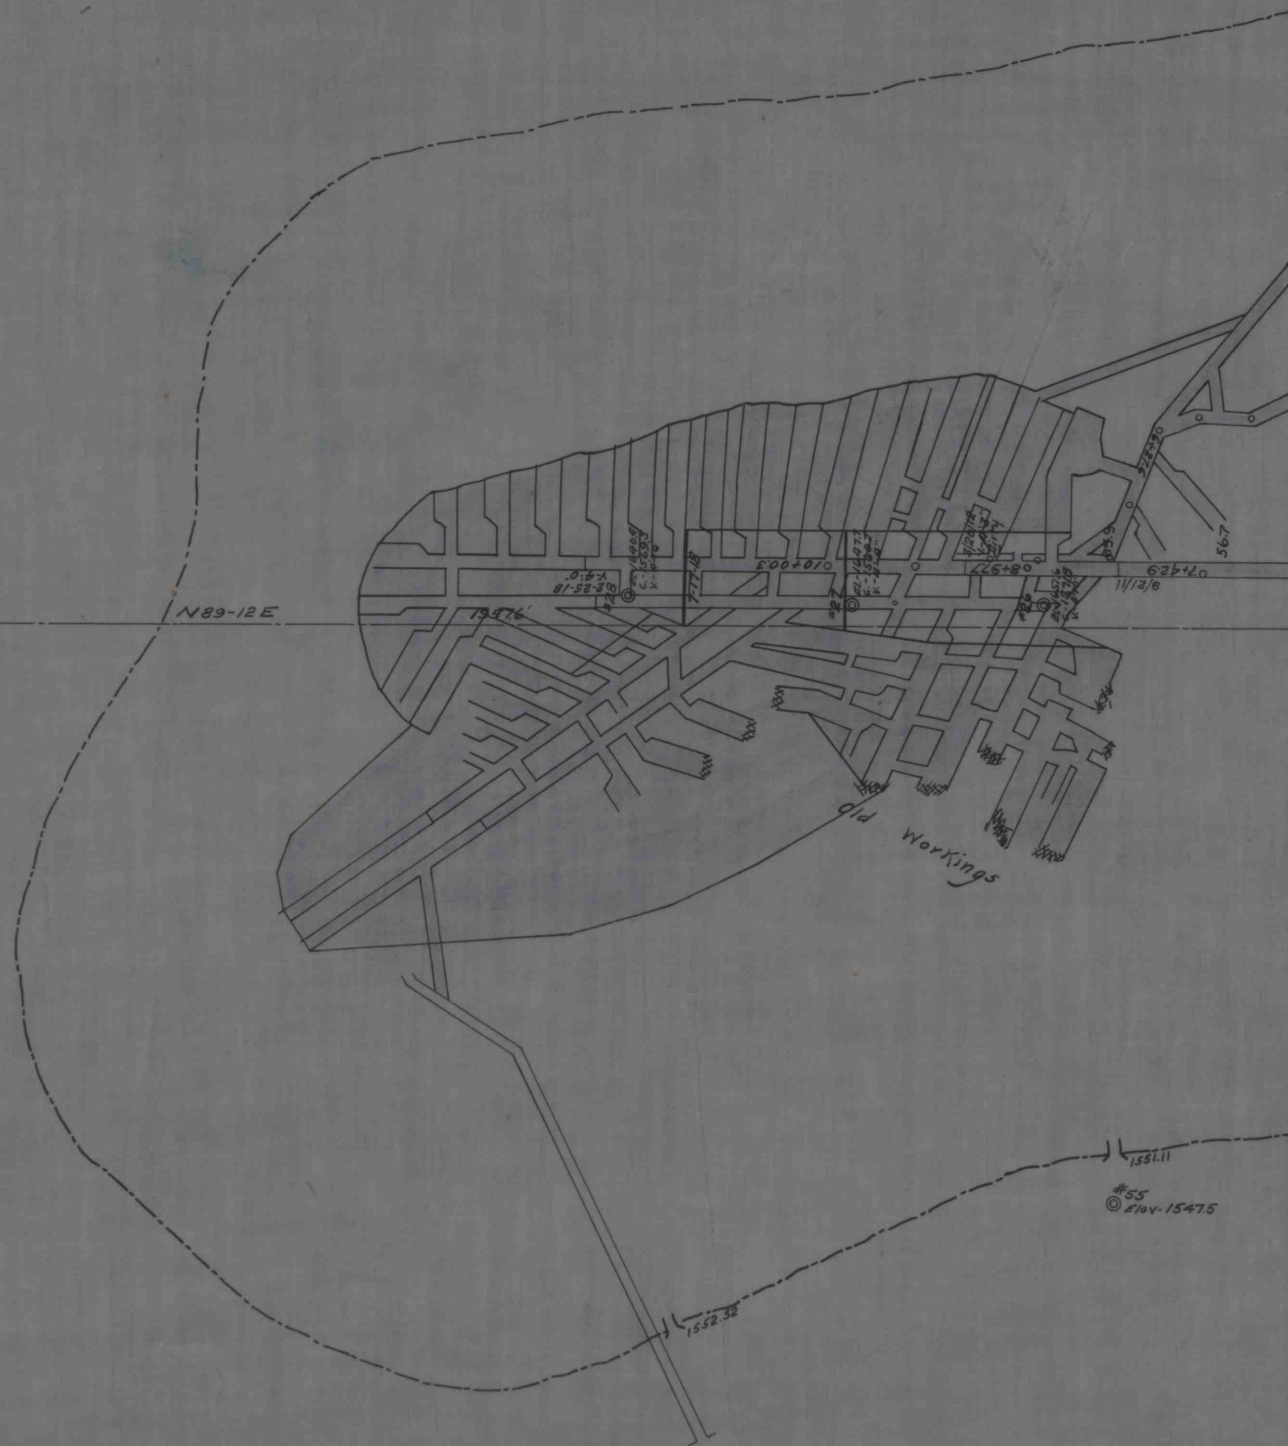

IMAPS # 15680