Abandoned. June 30. 1928.

The undersigned hereby certify that this map is a true and correct copy of the Original Map of Ramsay Town, No. 4. Mine, and that said Original Map is a true, complete and correct Map, and survey of all the excavations made in said abandoned mine, to the best of my knowledge, and belief.

P. H. Thorn.
Mine Surveyor.

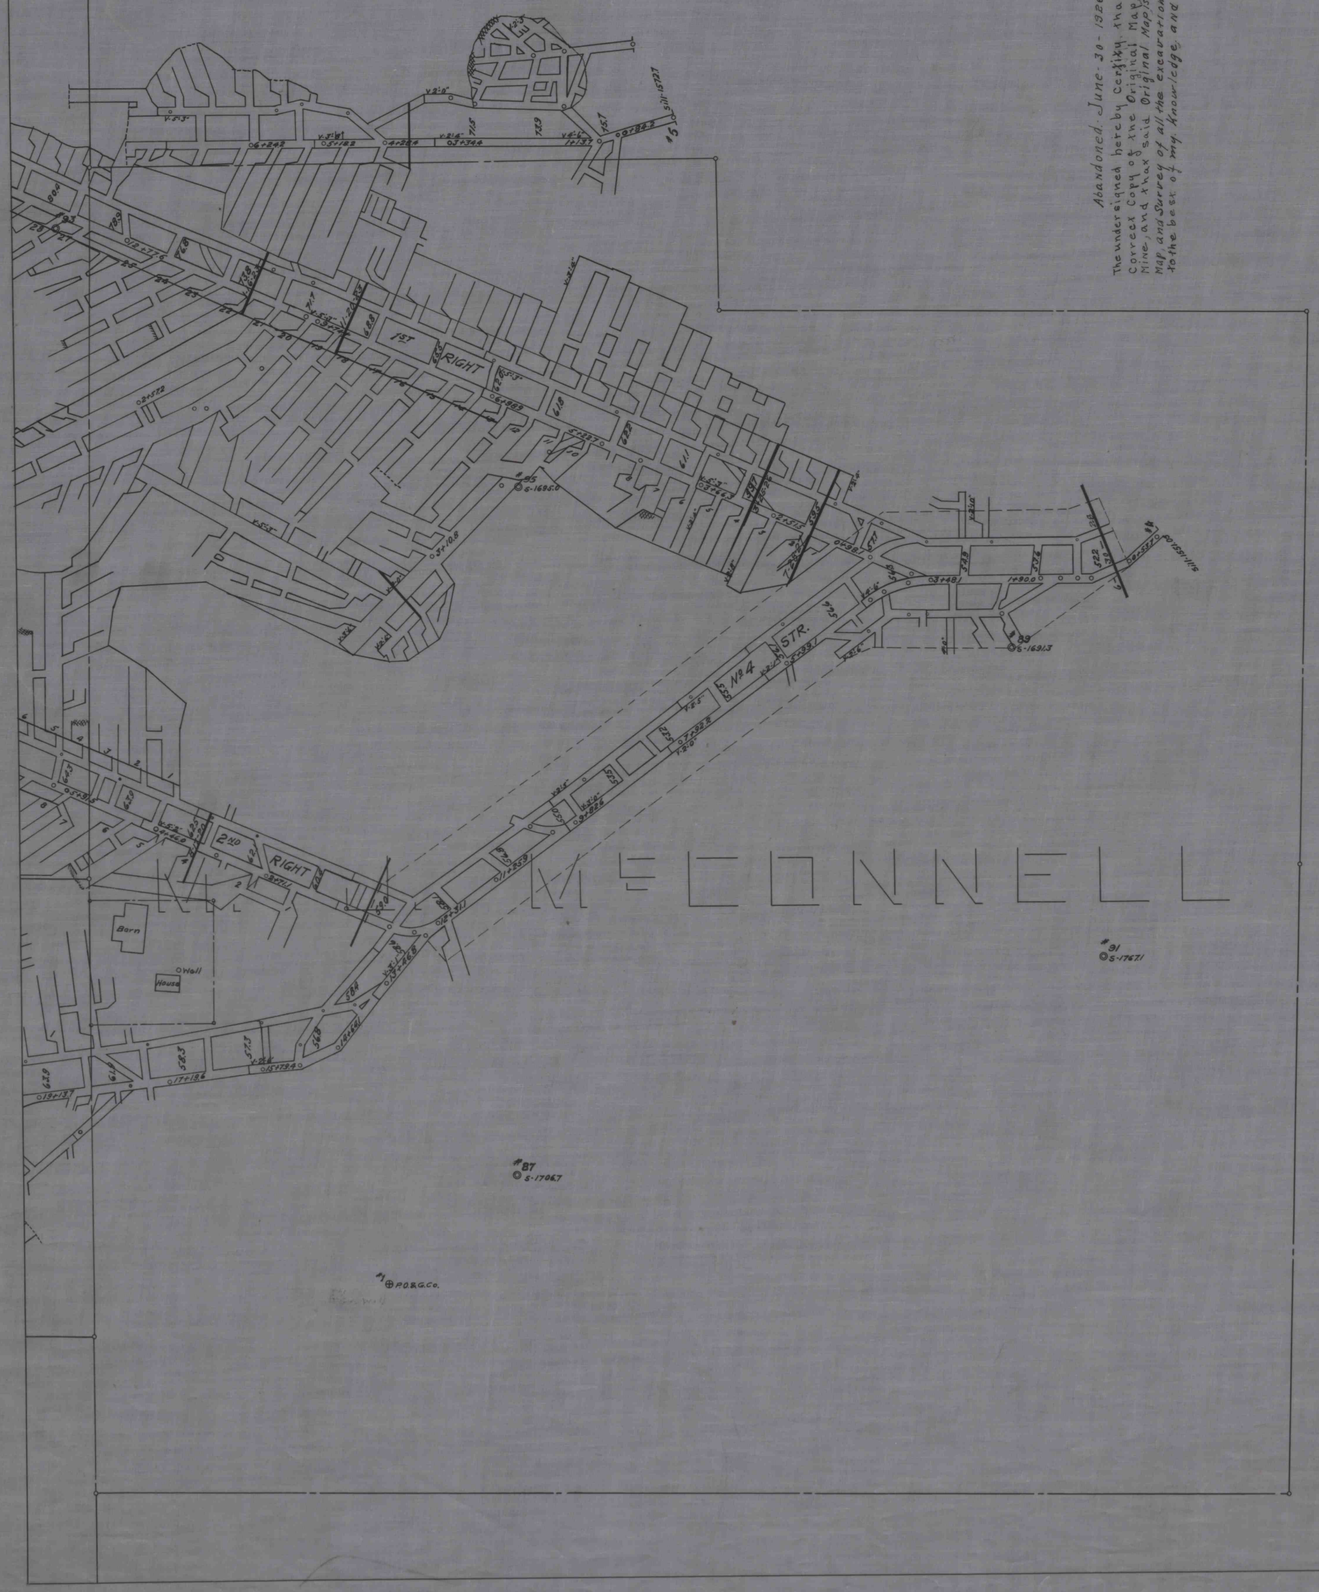

IMAPS # 15686