RAMSAY MINE

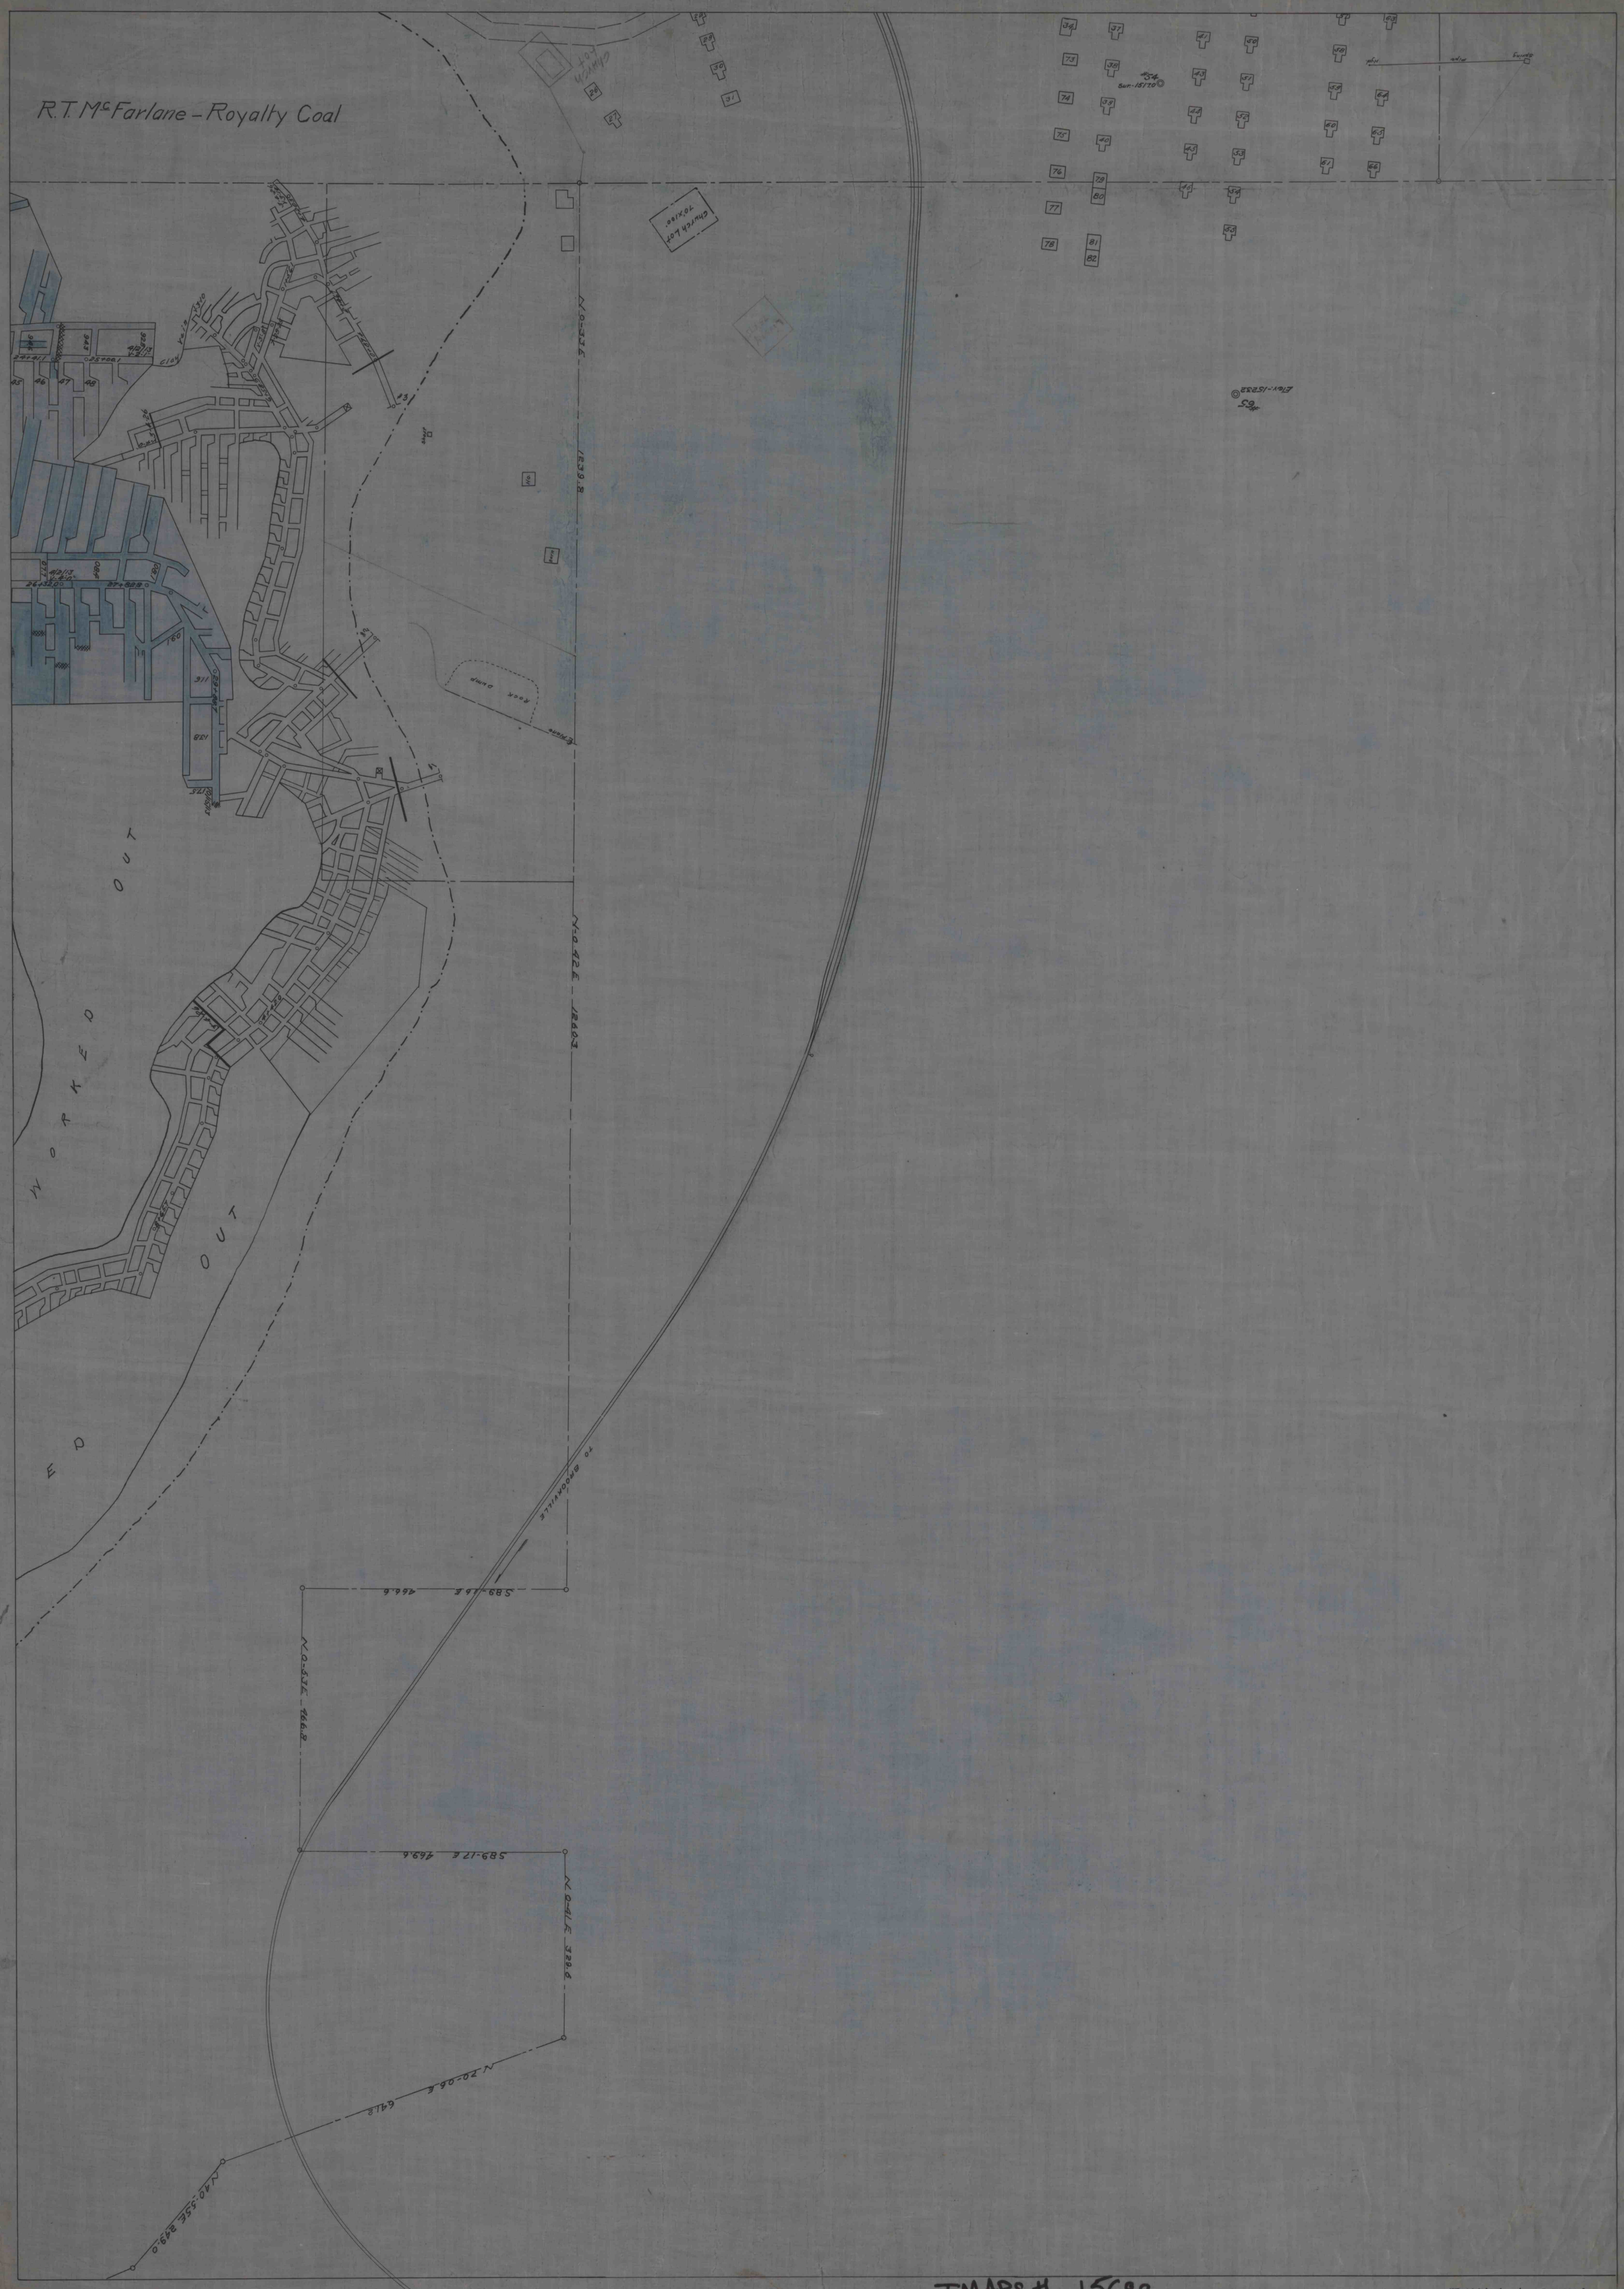

RAMSAY MINE

IMAPS # 15689