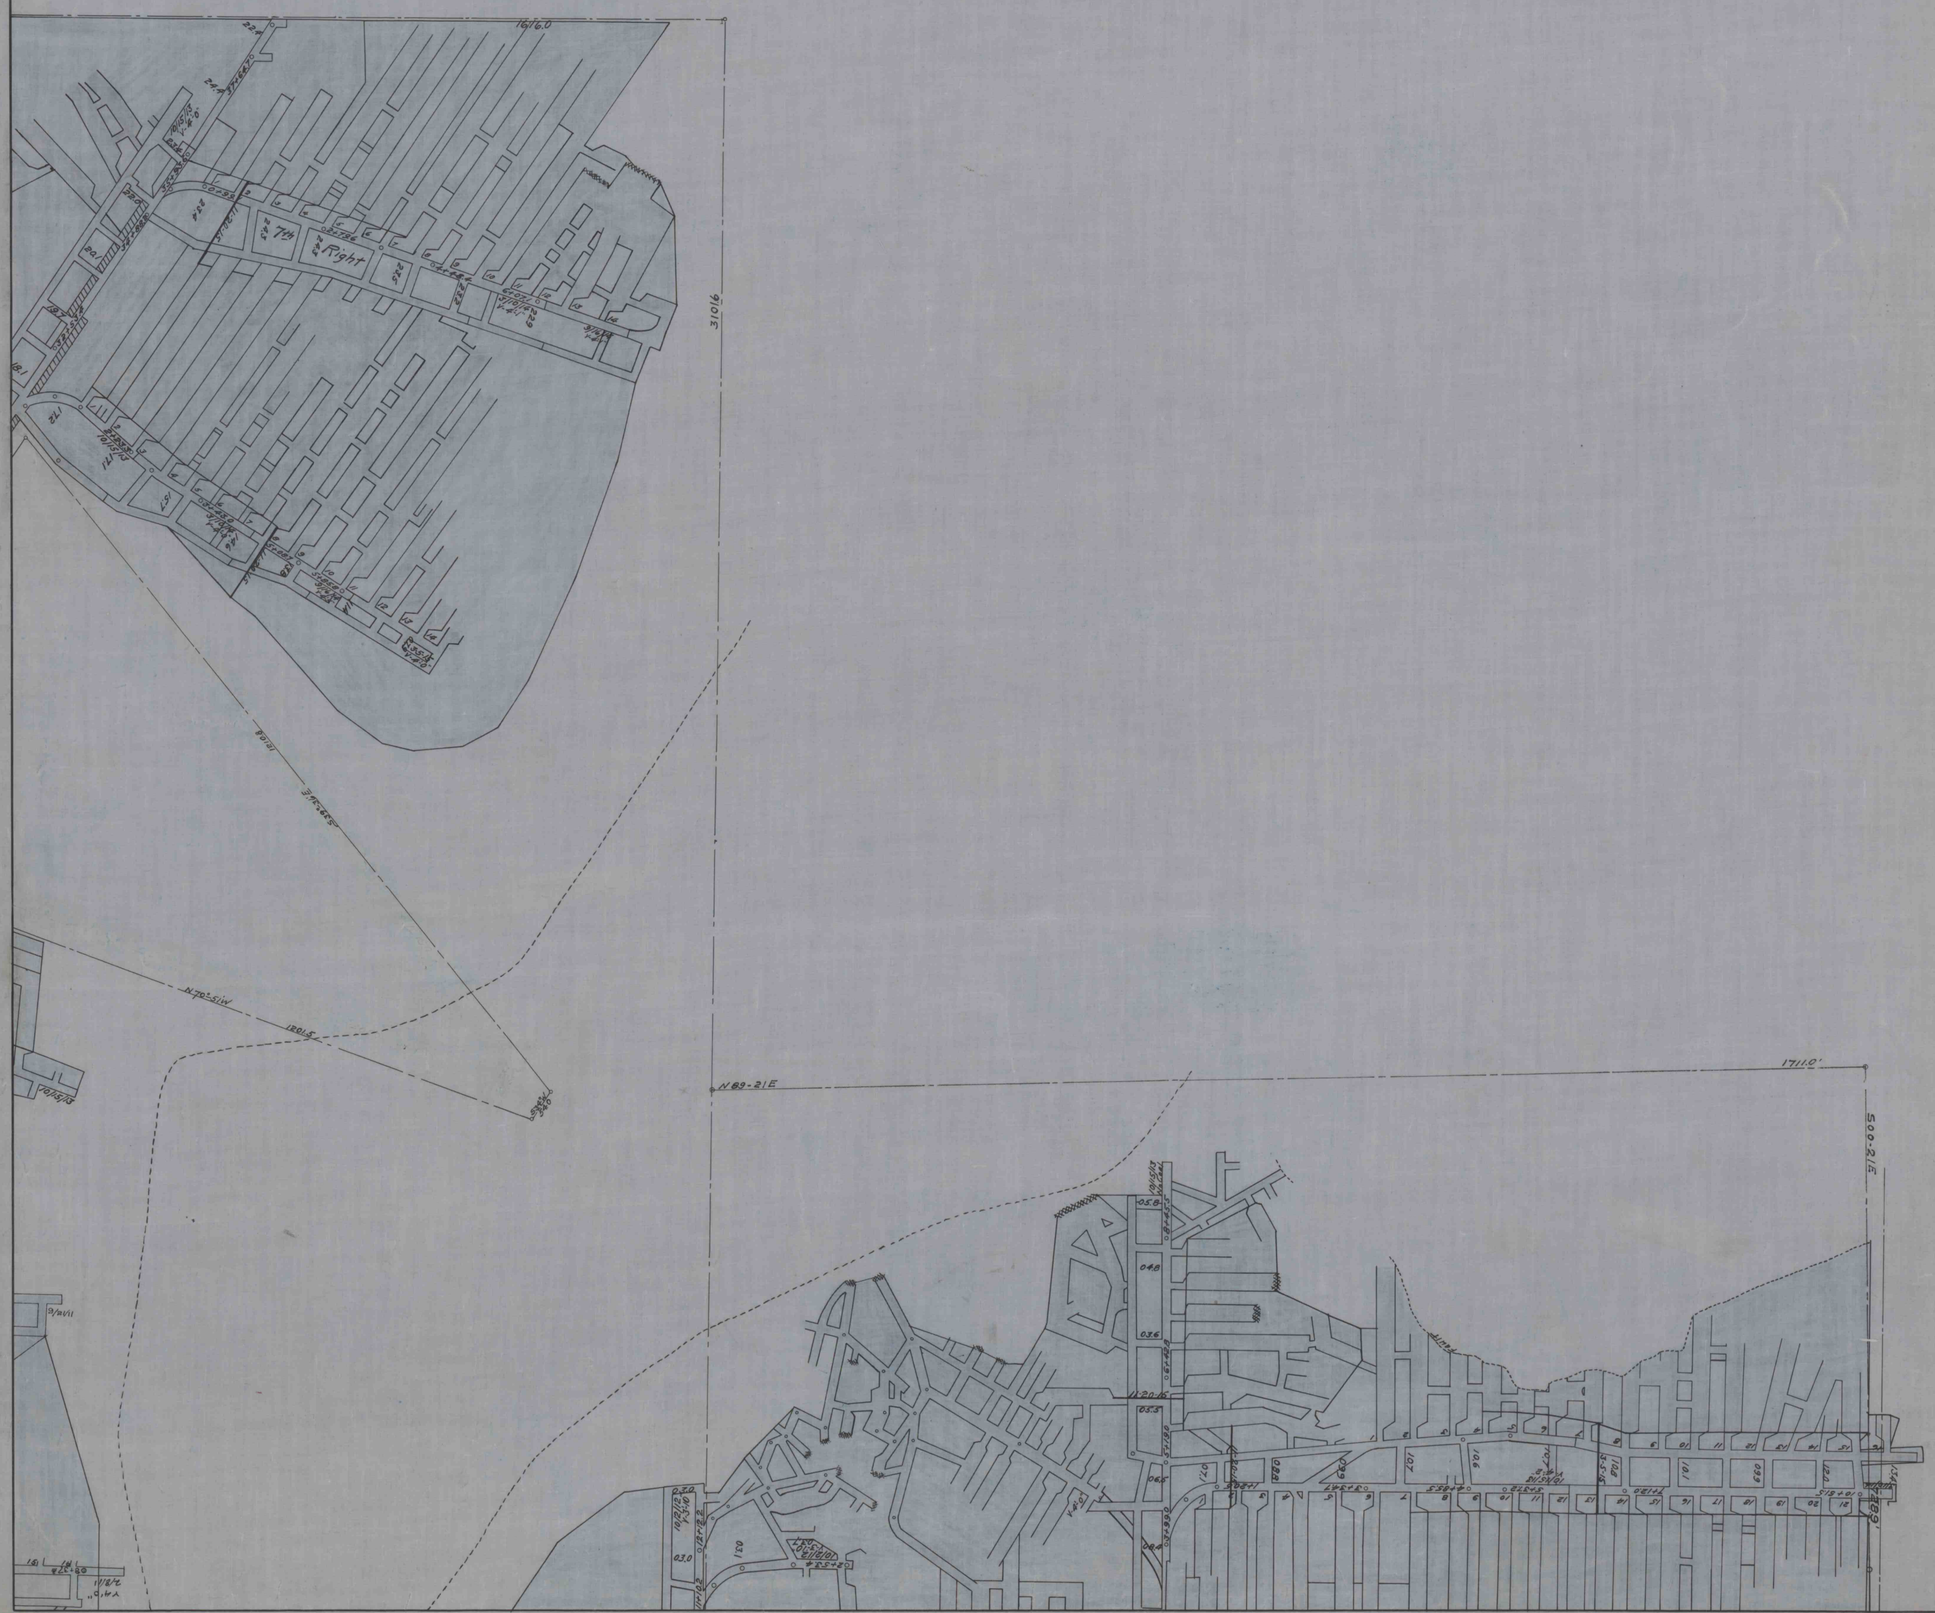

IMMRS # 15690