


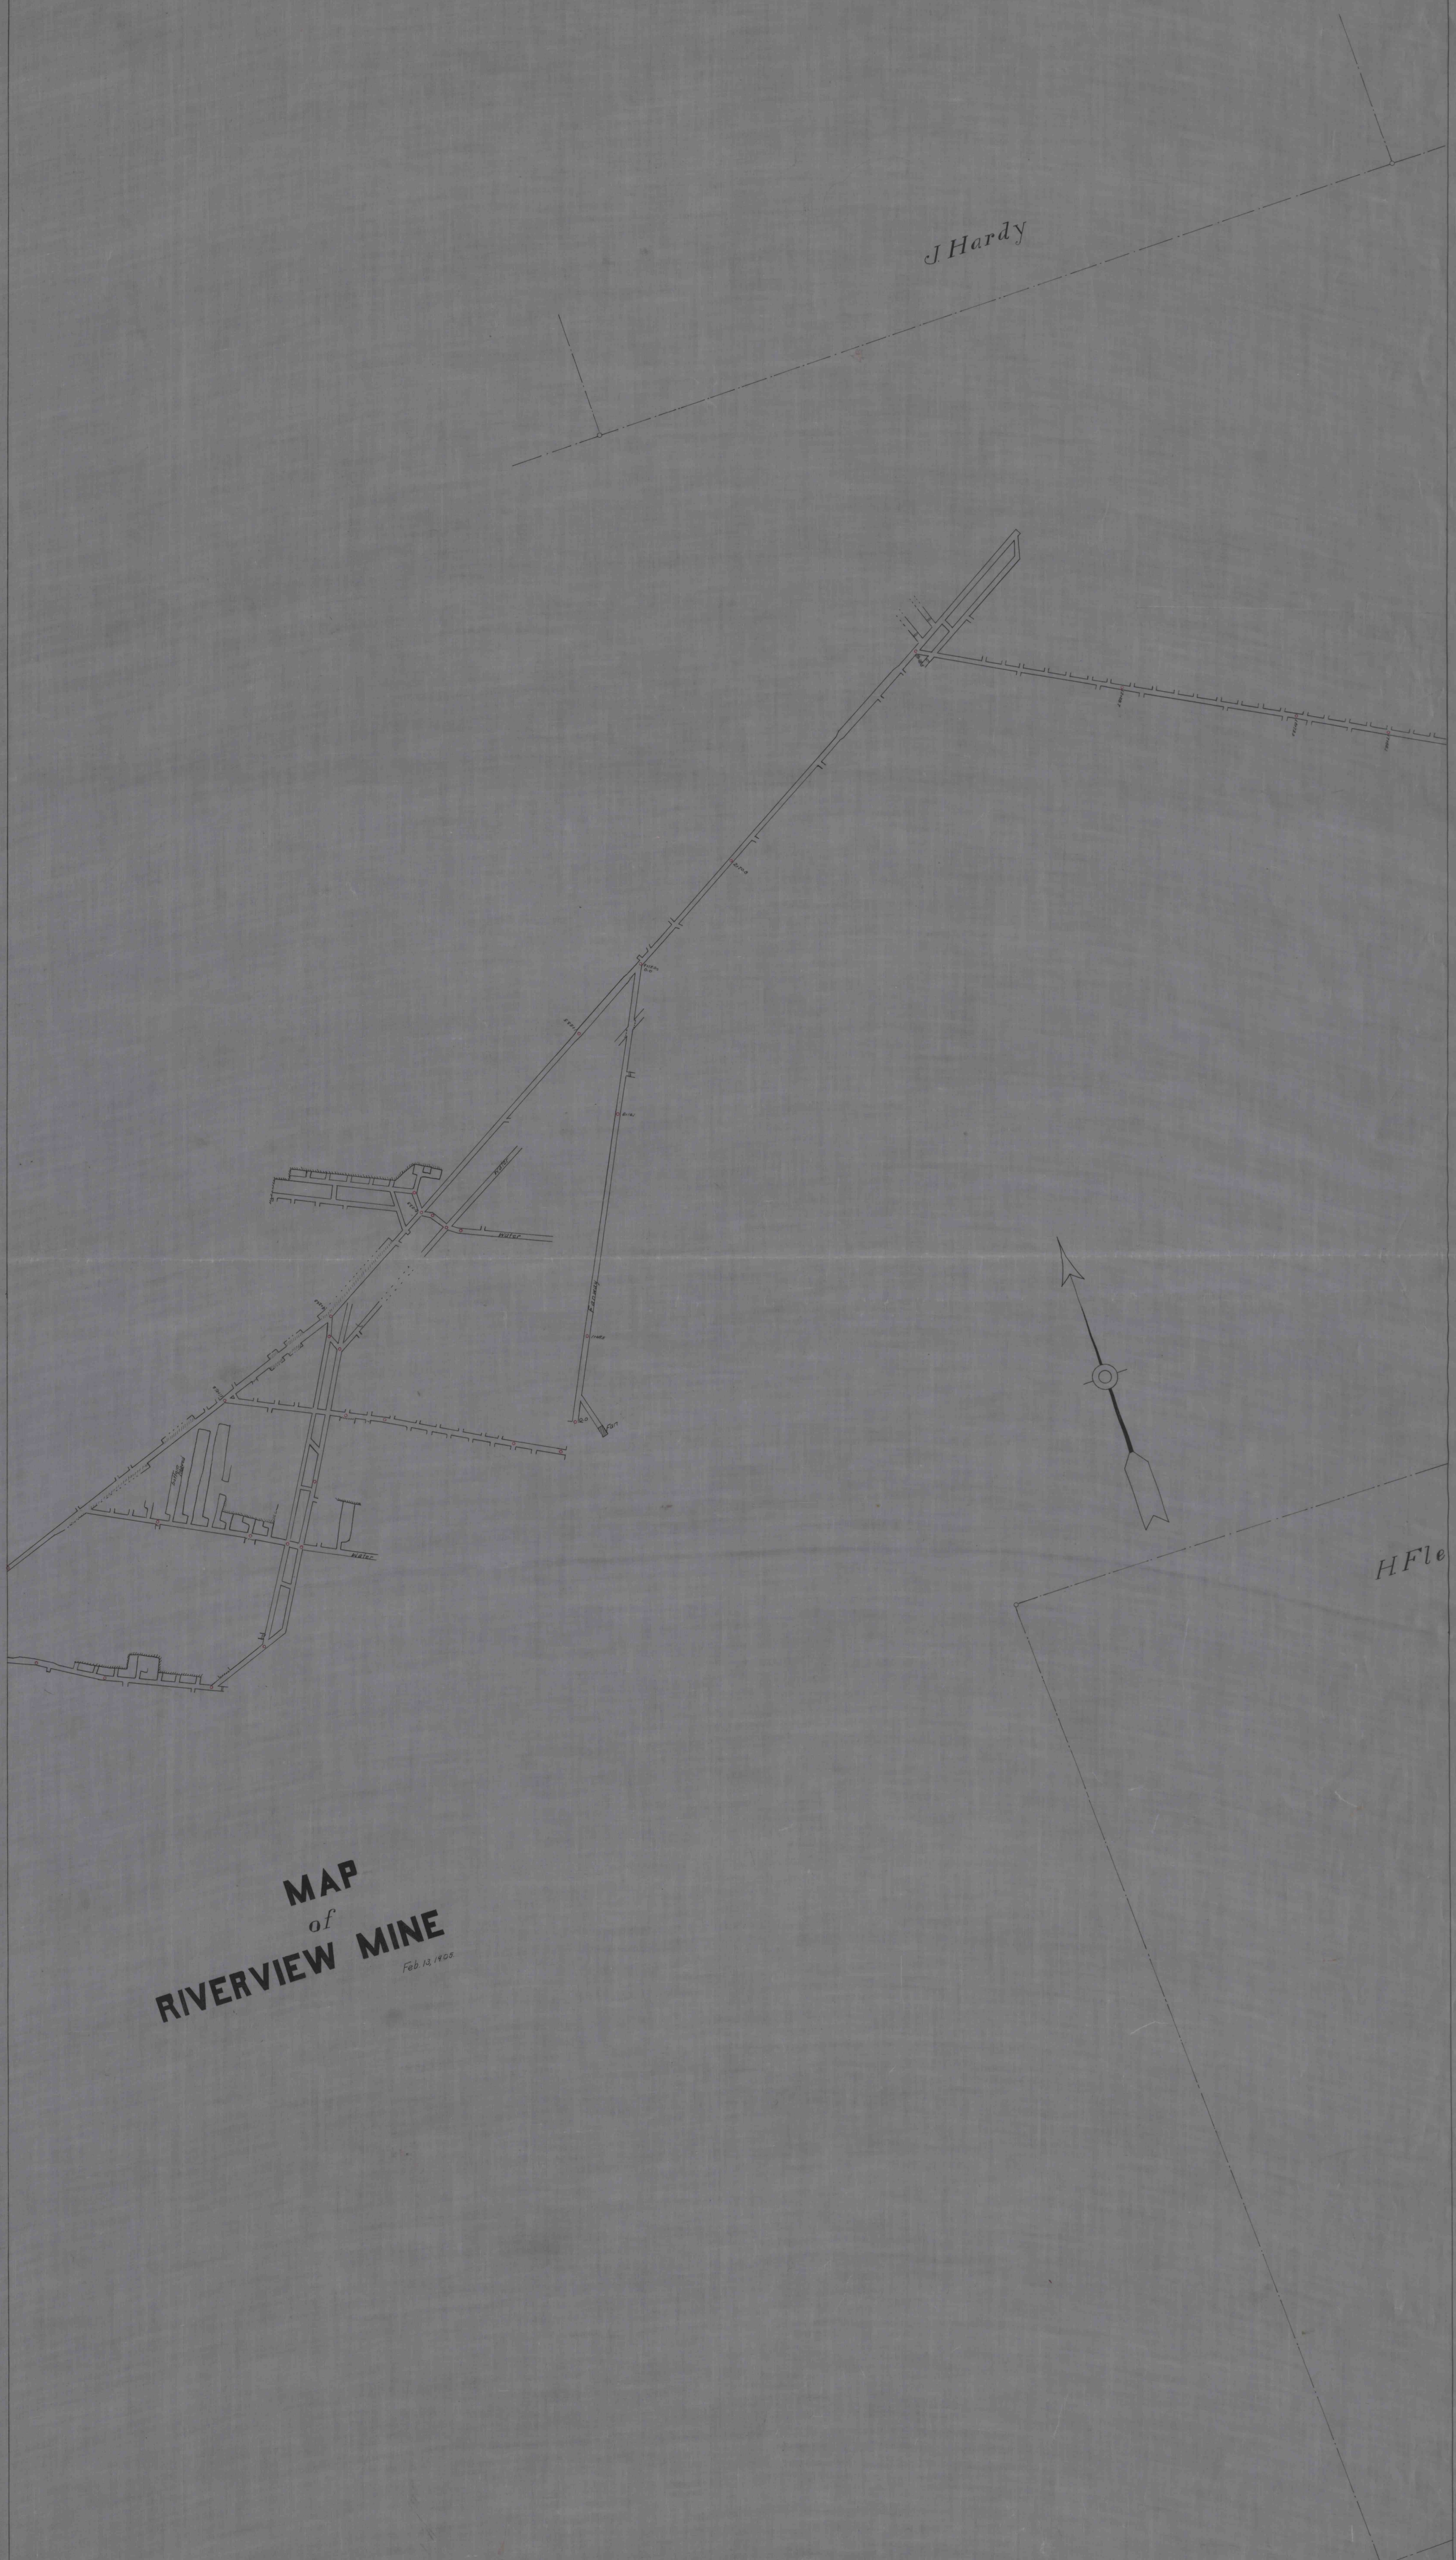

MAP
of
RIVERVIEW MINE
Feb. 13, 1908