


- PROFILE -
 TRAMROAD FOR BRICKWORKS
 - SHAWMUT, PA. -

Scale { Hor. = 200' = 1"
 Vert. = 20' = 1" 3-20-09

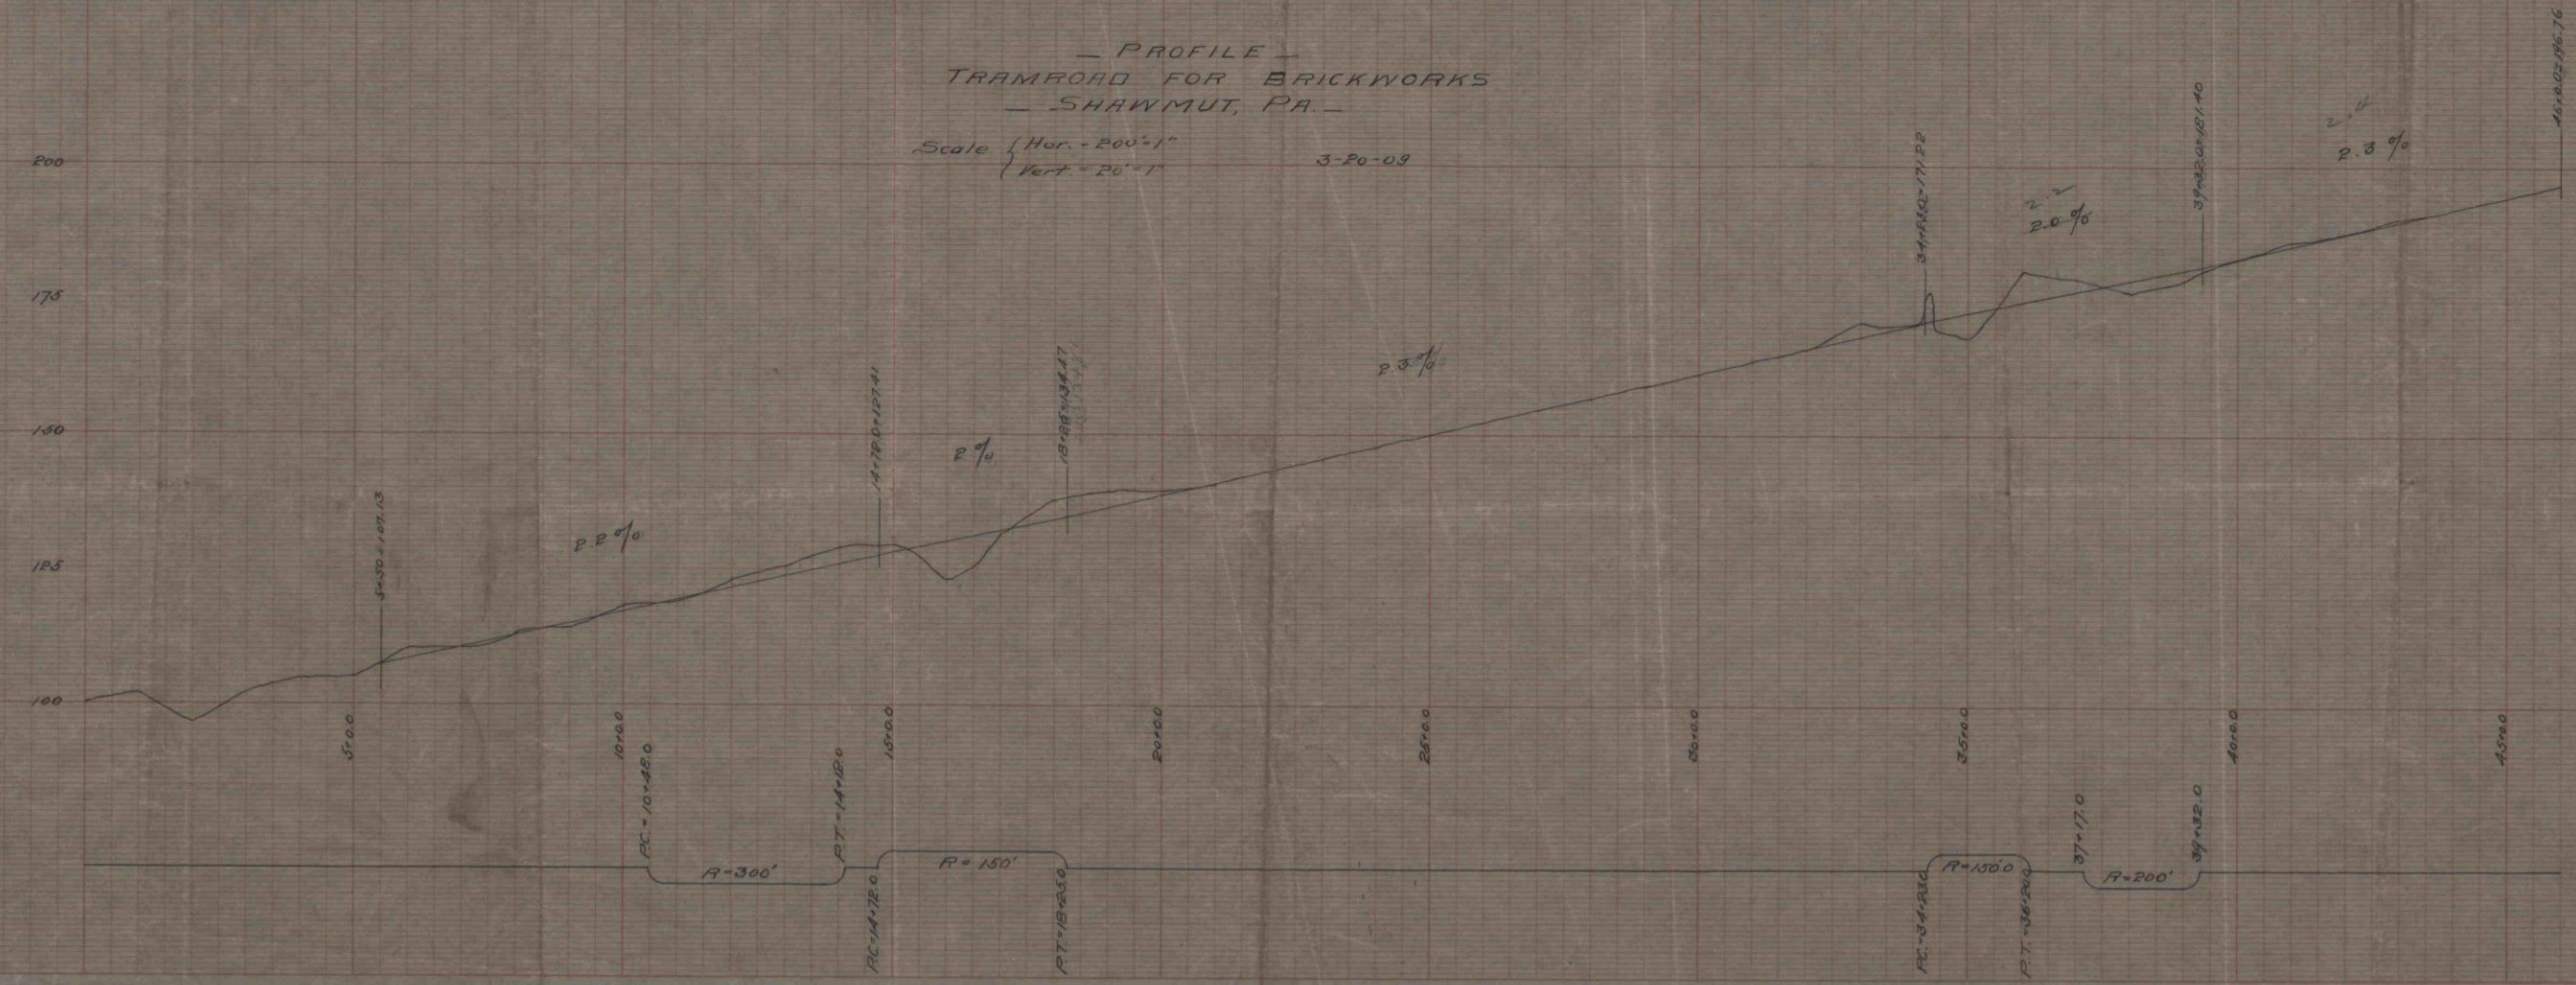

IMAPS# 15743