SHEET NO. 4

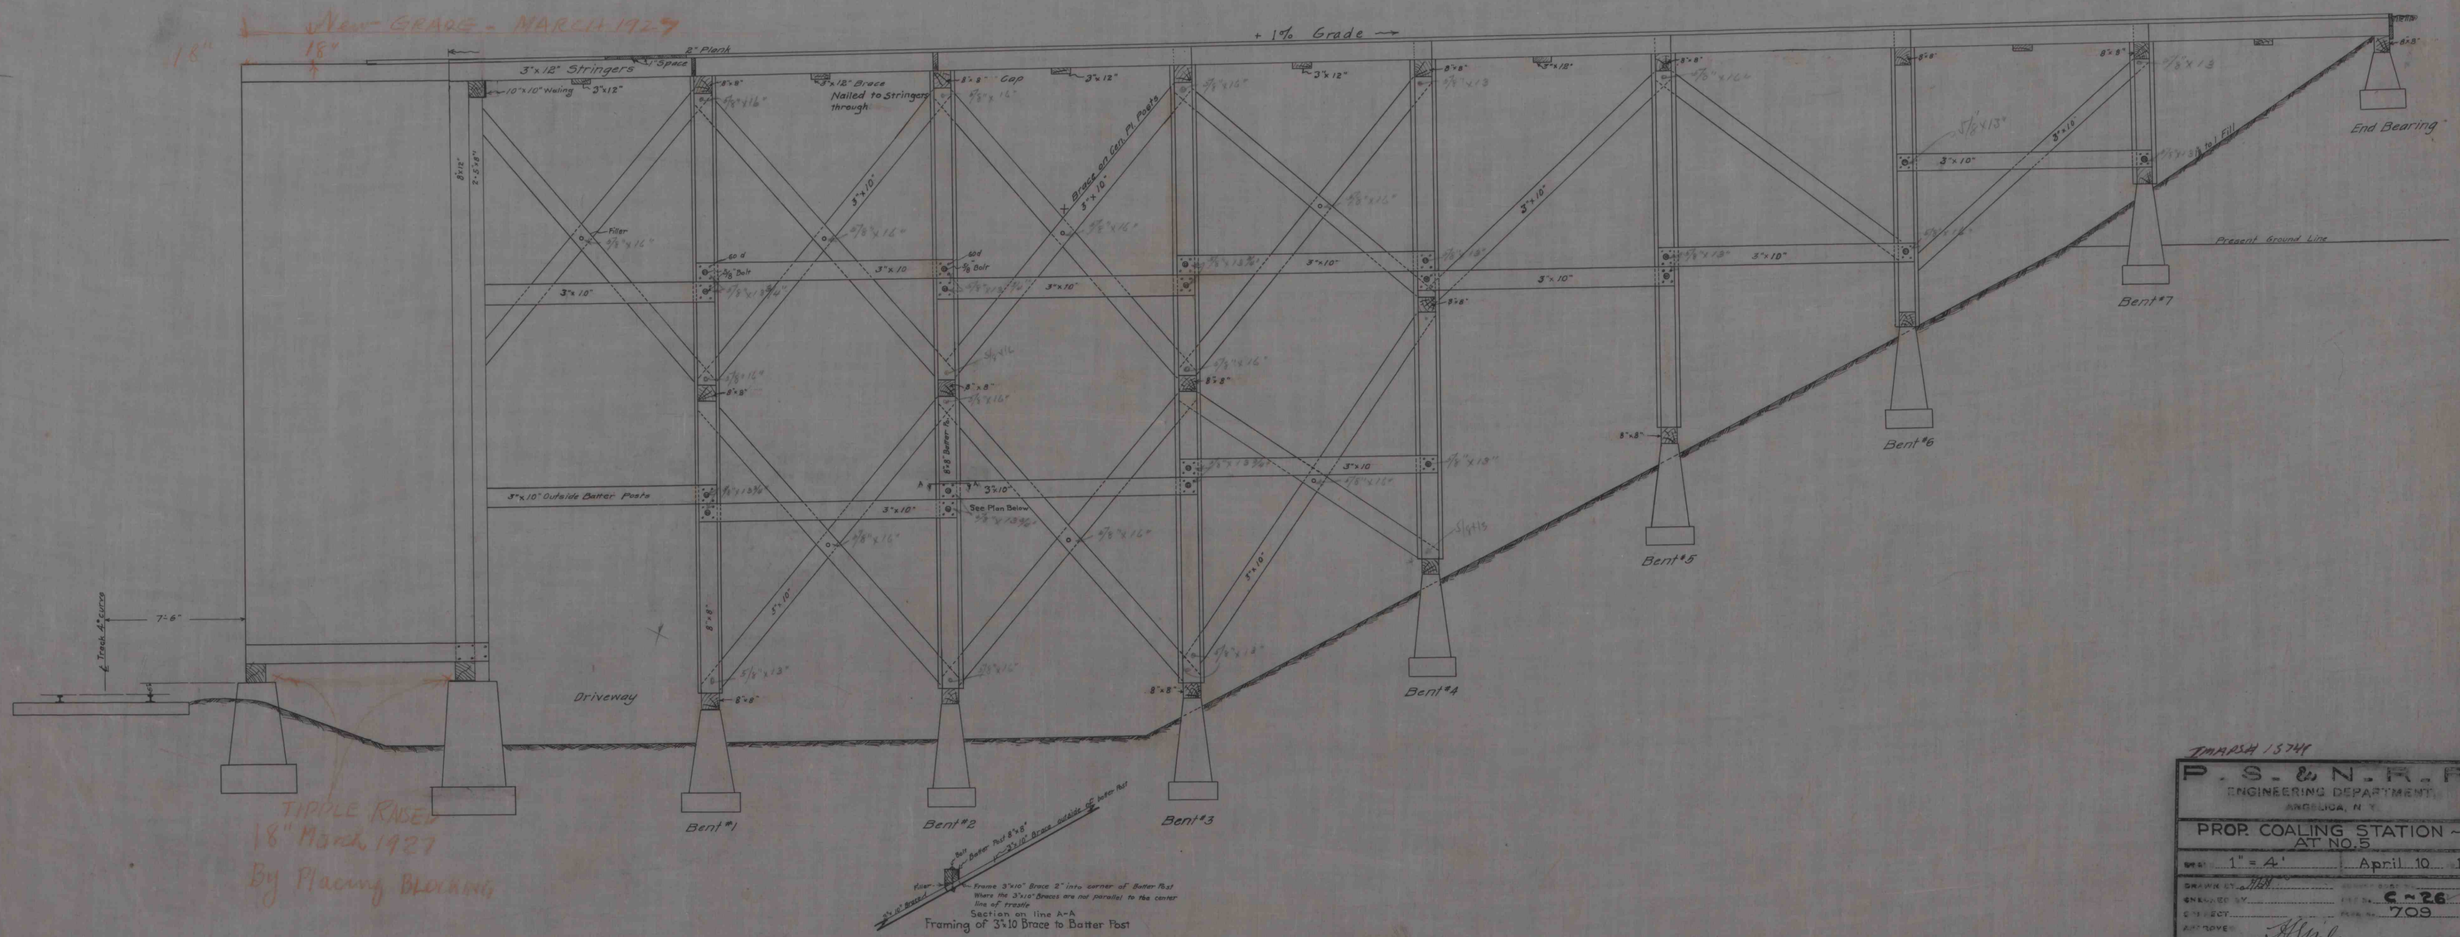

TMARSH 15741

P. S. & N. R. R.
ENGINEERING DEPARTMENT
ANGELICA, N. Y.

PROP. COALING STATION — AT NO. 5

SCALE 1" = 4' | April 10 12

DRAWN BY MGH

ENGINEER BY

CHECKED BY

APPROVED

FILE NO. C-26

PLAN NO. 709