


IMAPS #15754

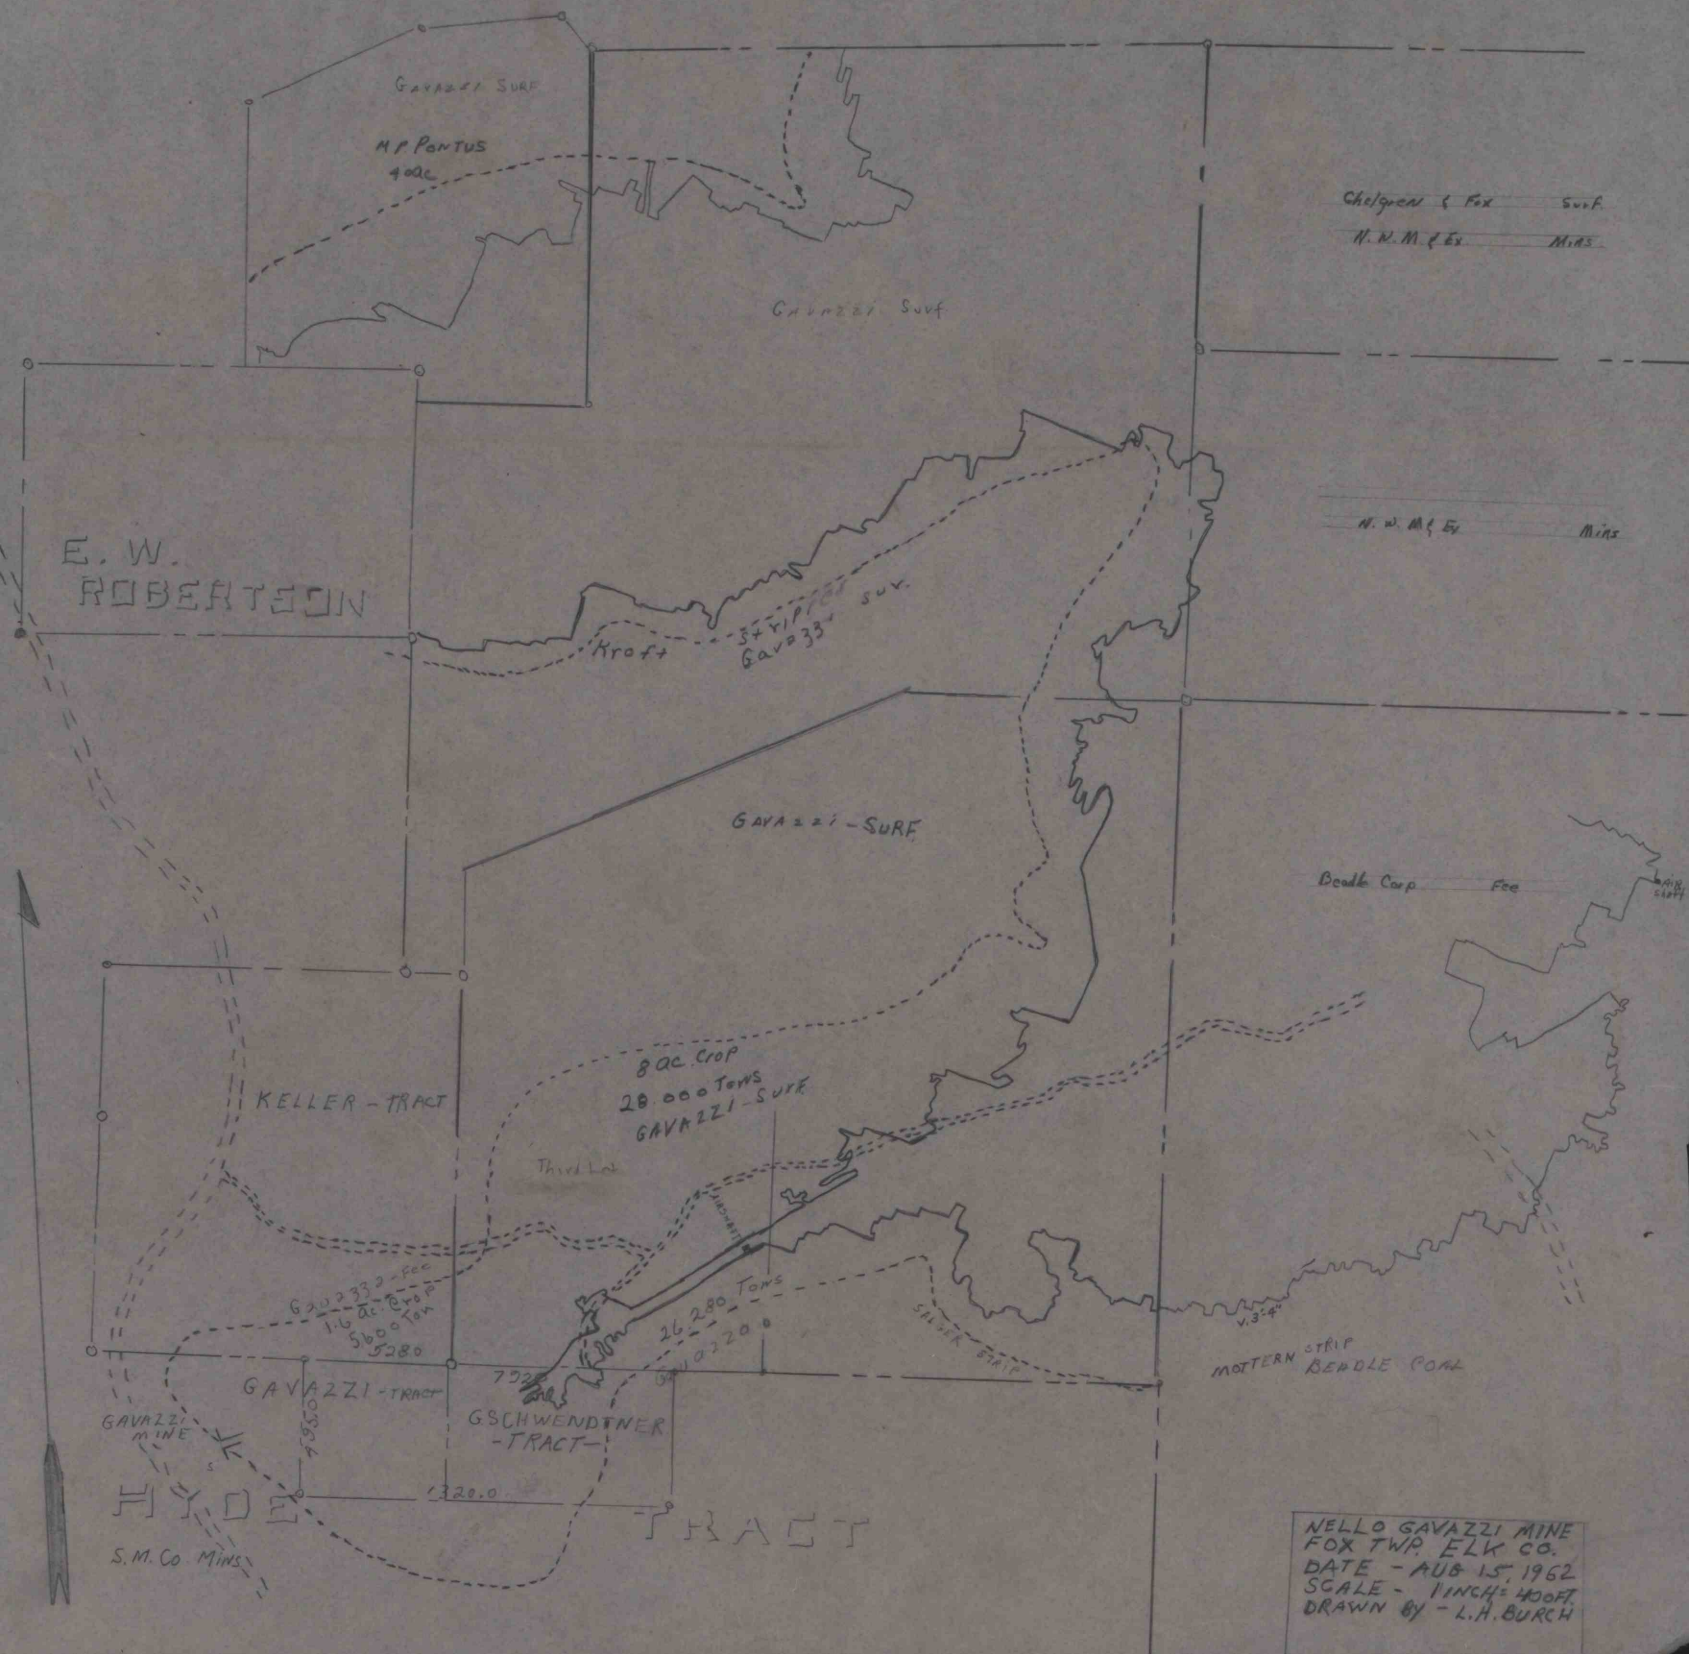

NELLO GAVAZZI MINE
 FOX TWP. ELK CO.
 DATE - AUG 15, 1962
 SCALE - 1 INCH = 400 FT.
 DRAWN BY - L.H. BURCH