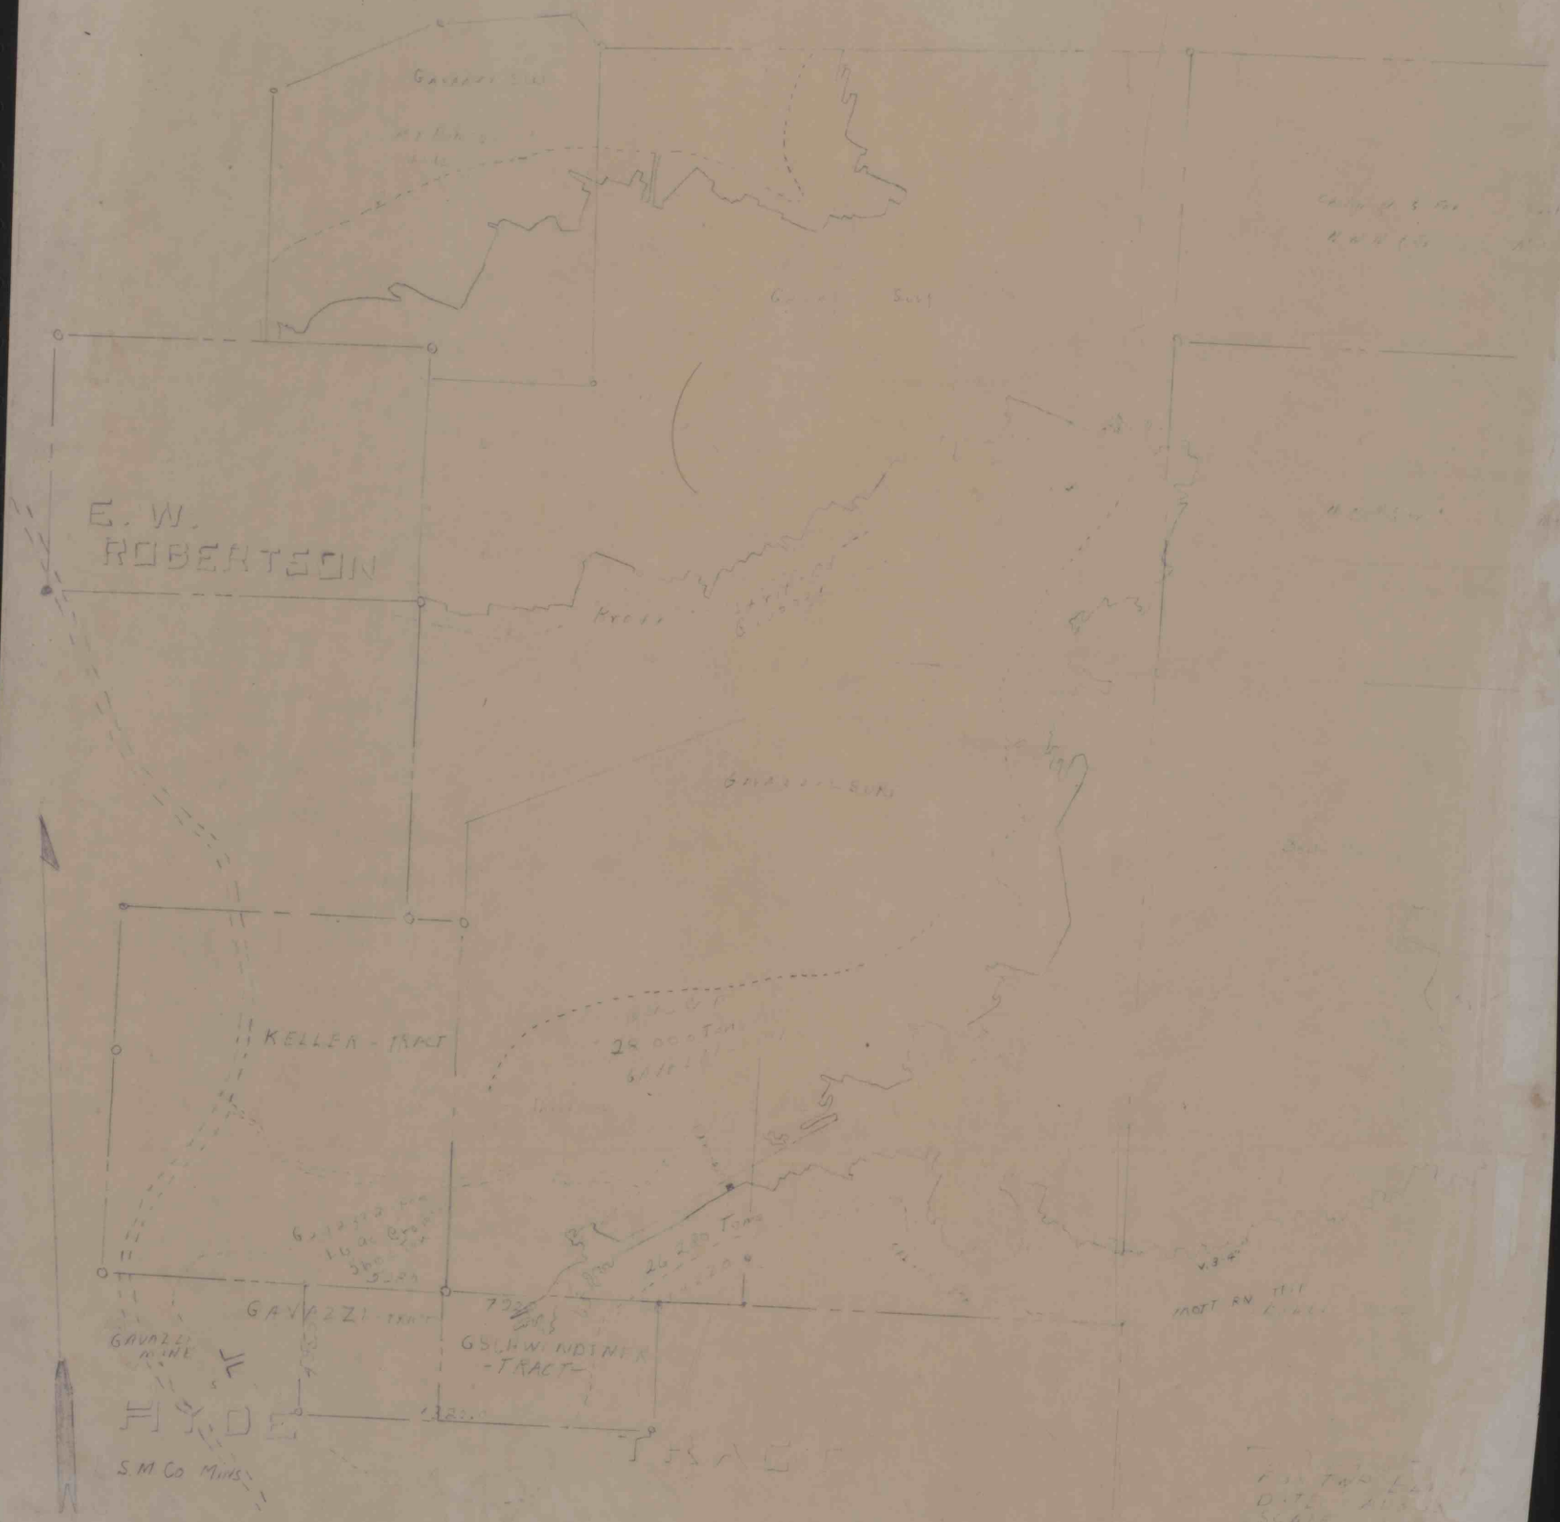
E. W.
ROBERTSON
KELLER - TRACT
GAVAZZI TRACT
GAVAZZI MINE
-TRACT-
HYDE
S.M. Co Mines

IMAPS#15756