


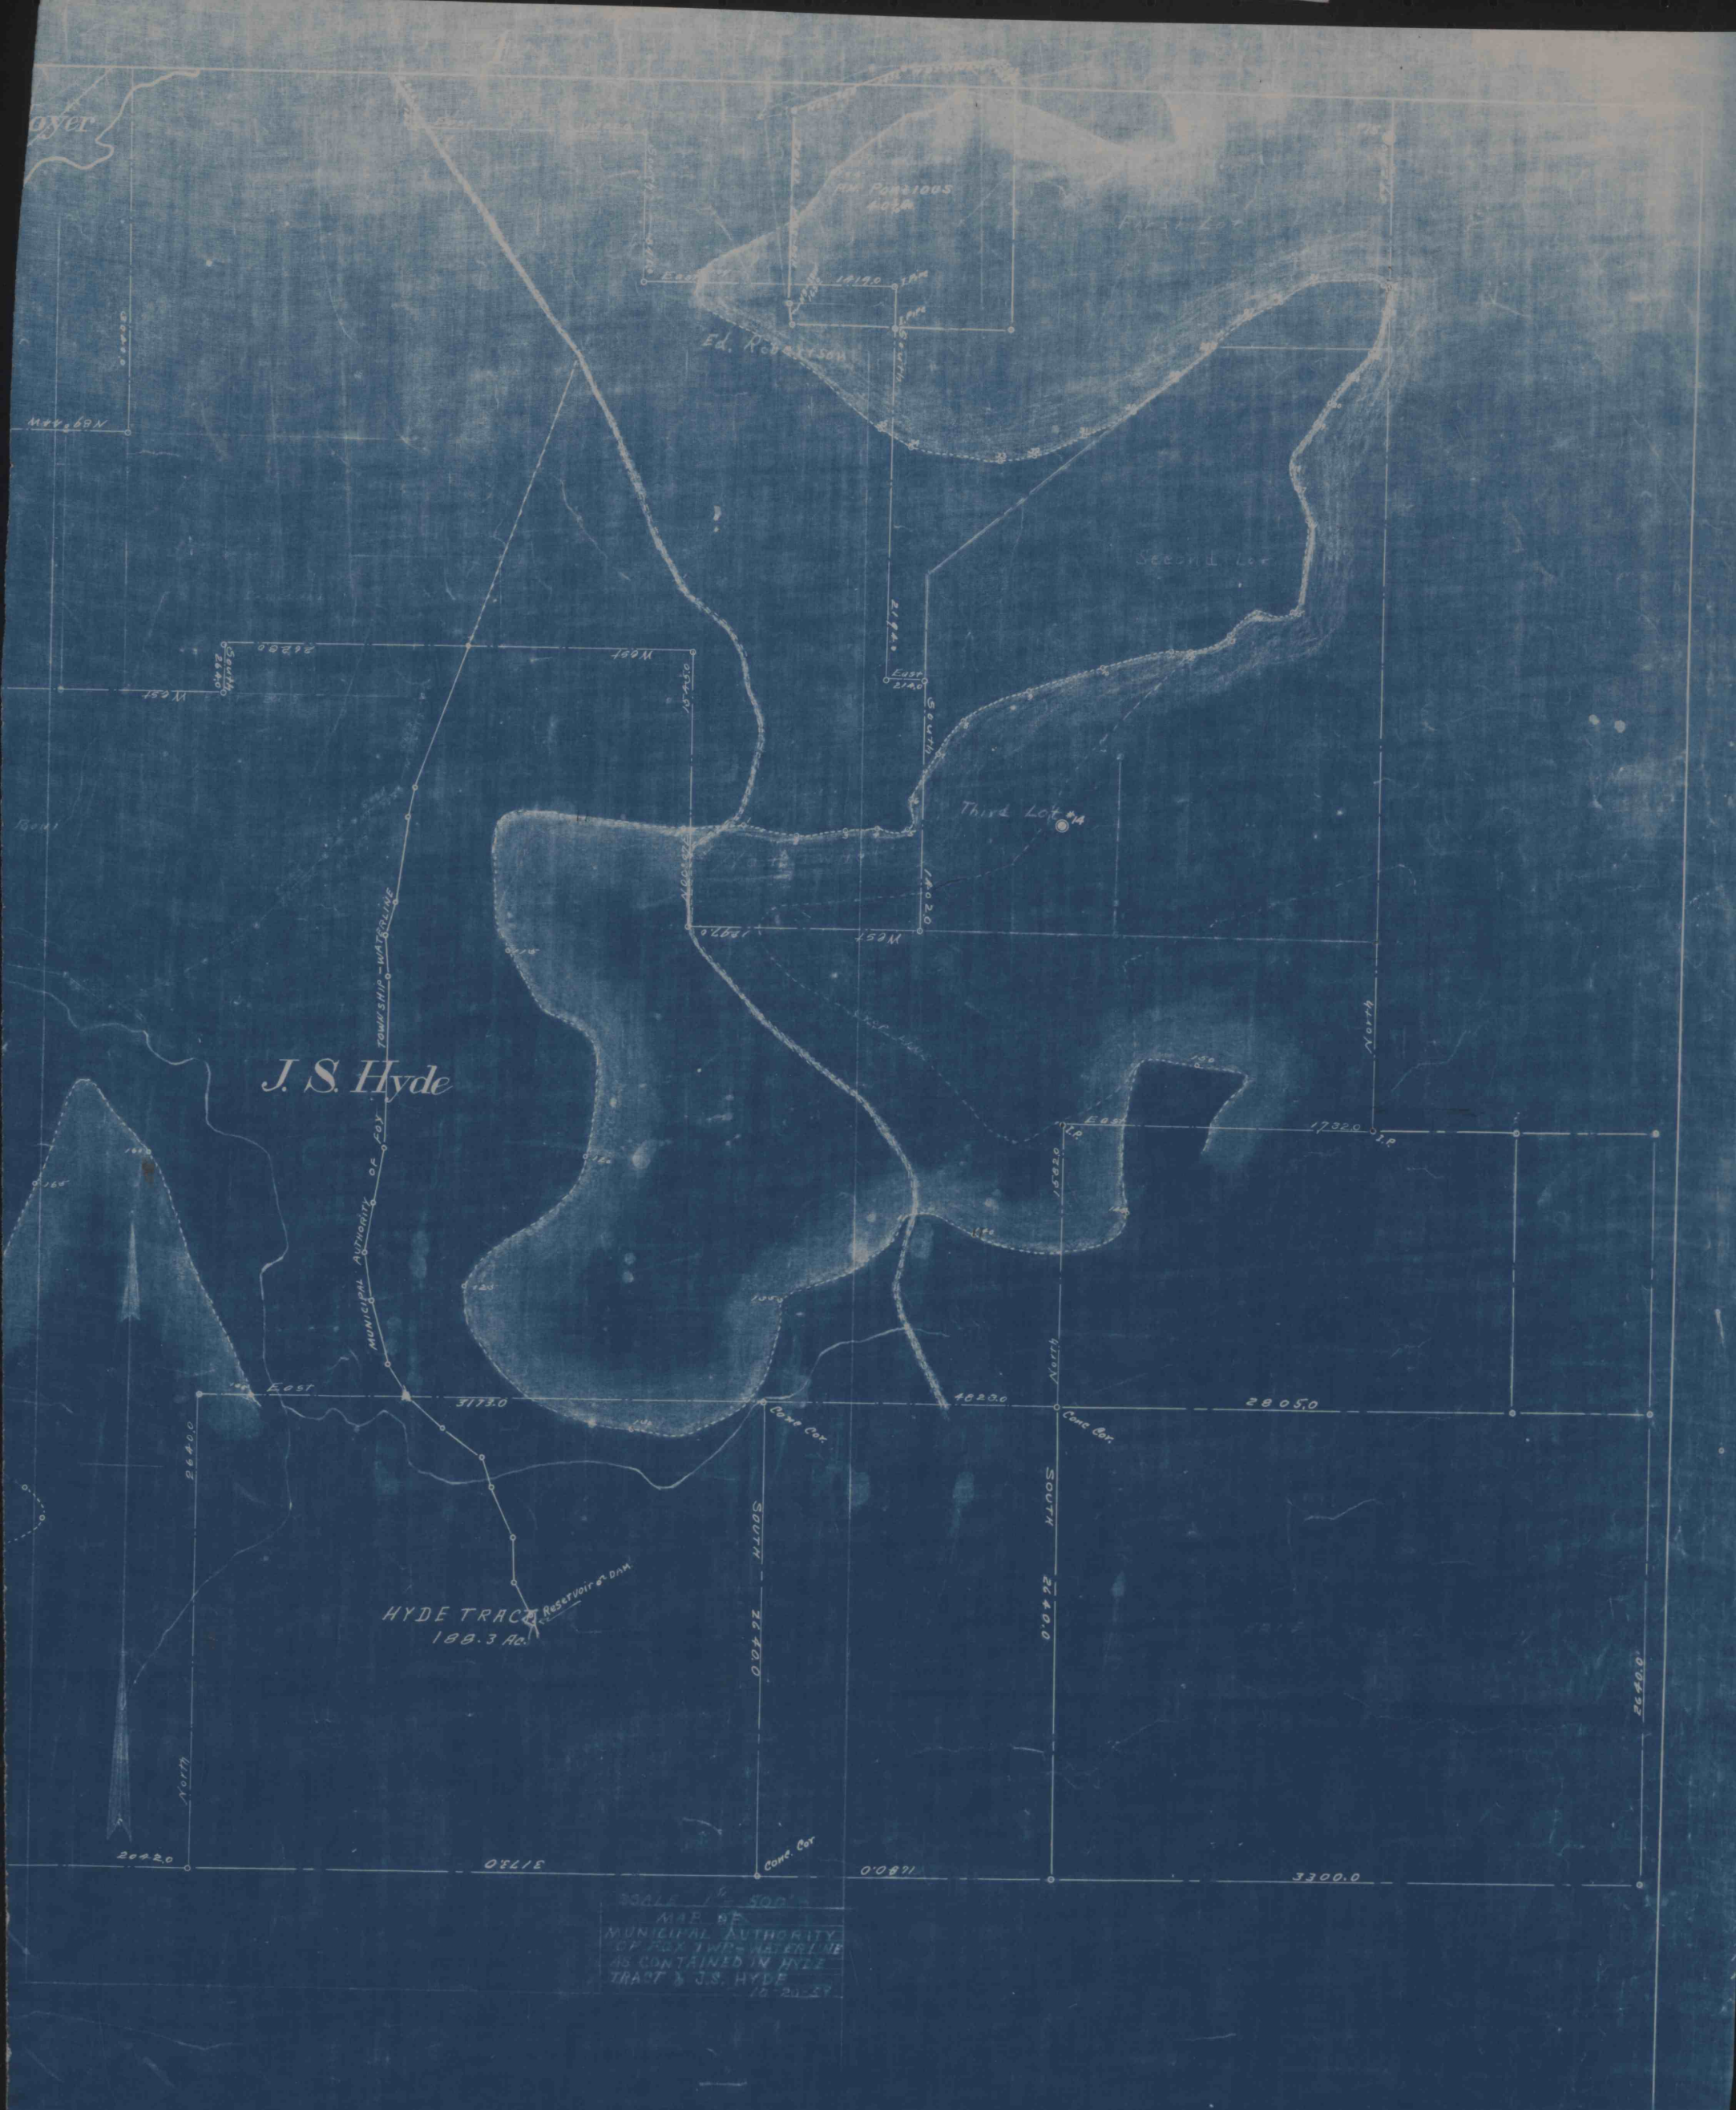






IMAPS#15761