


J. T. A.

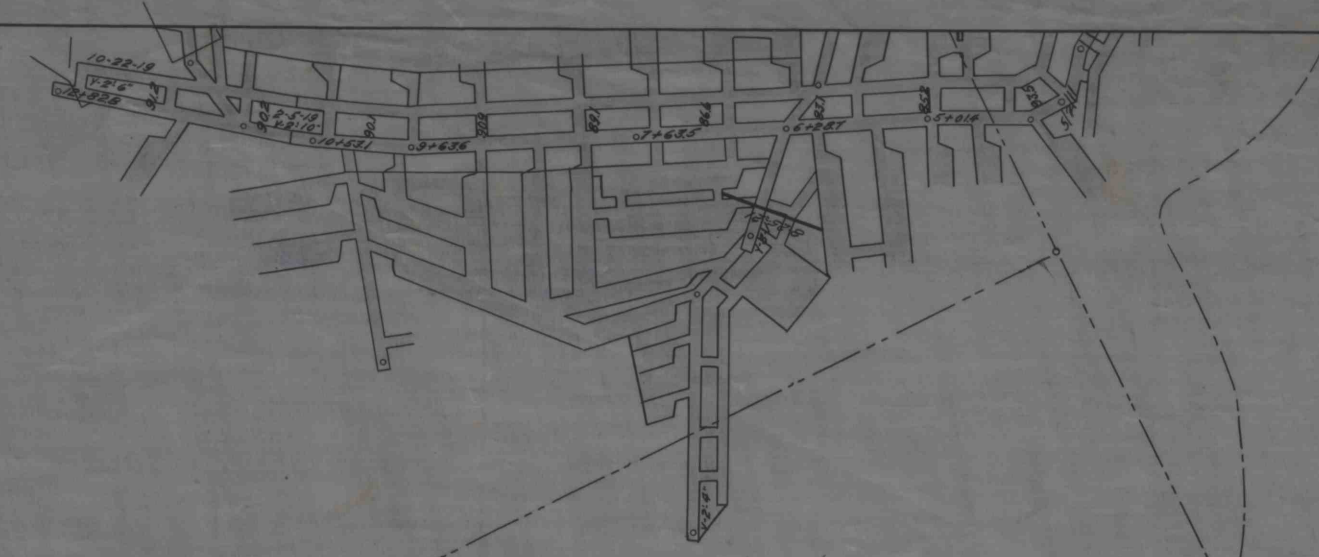

Charlotte Taylor surface only