


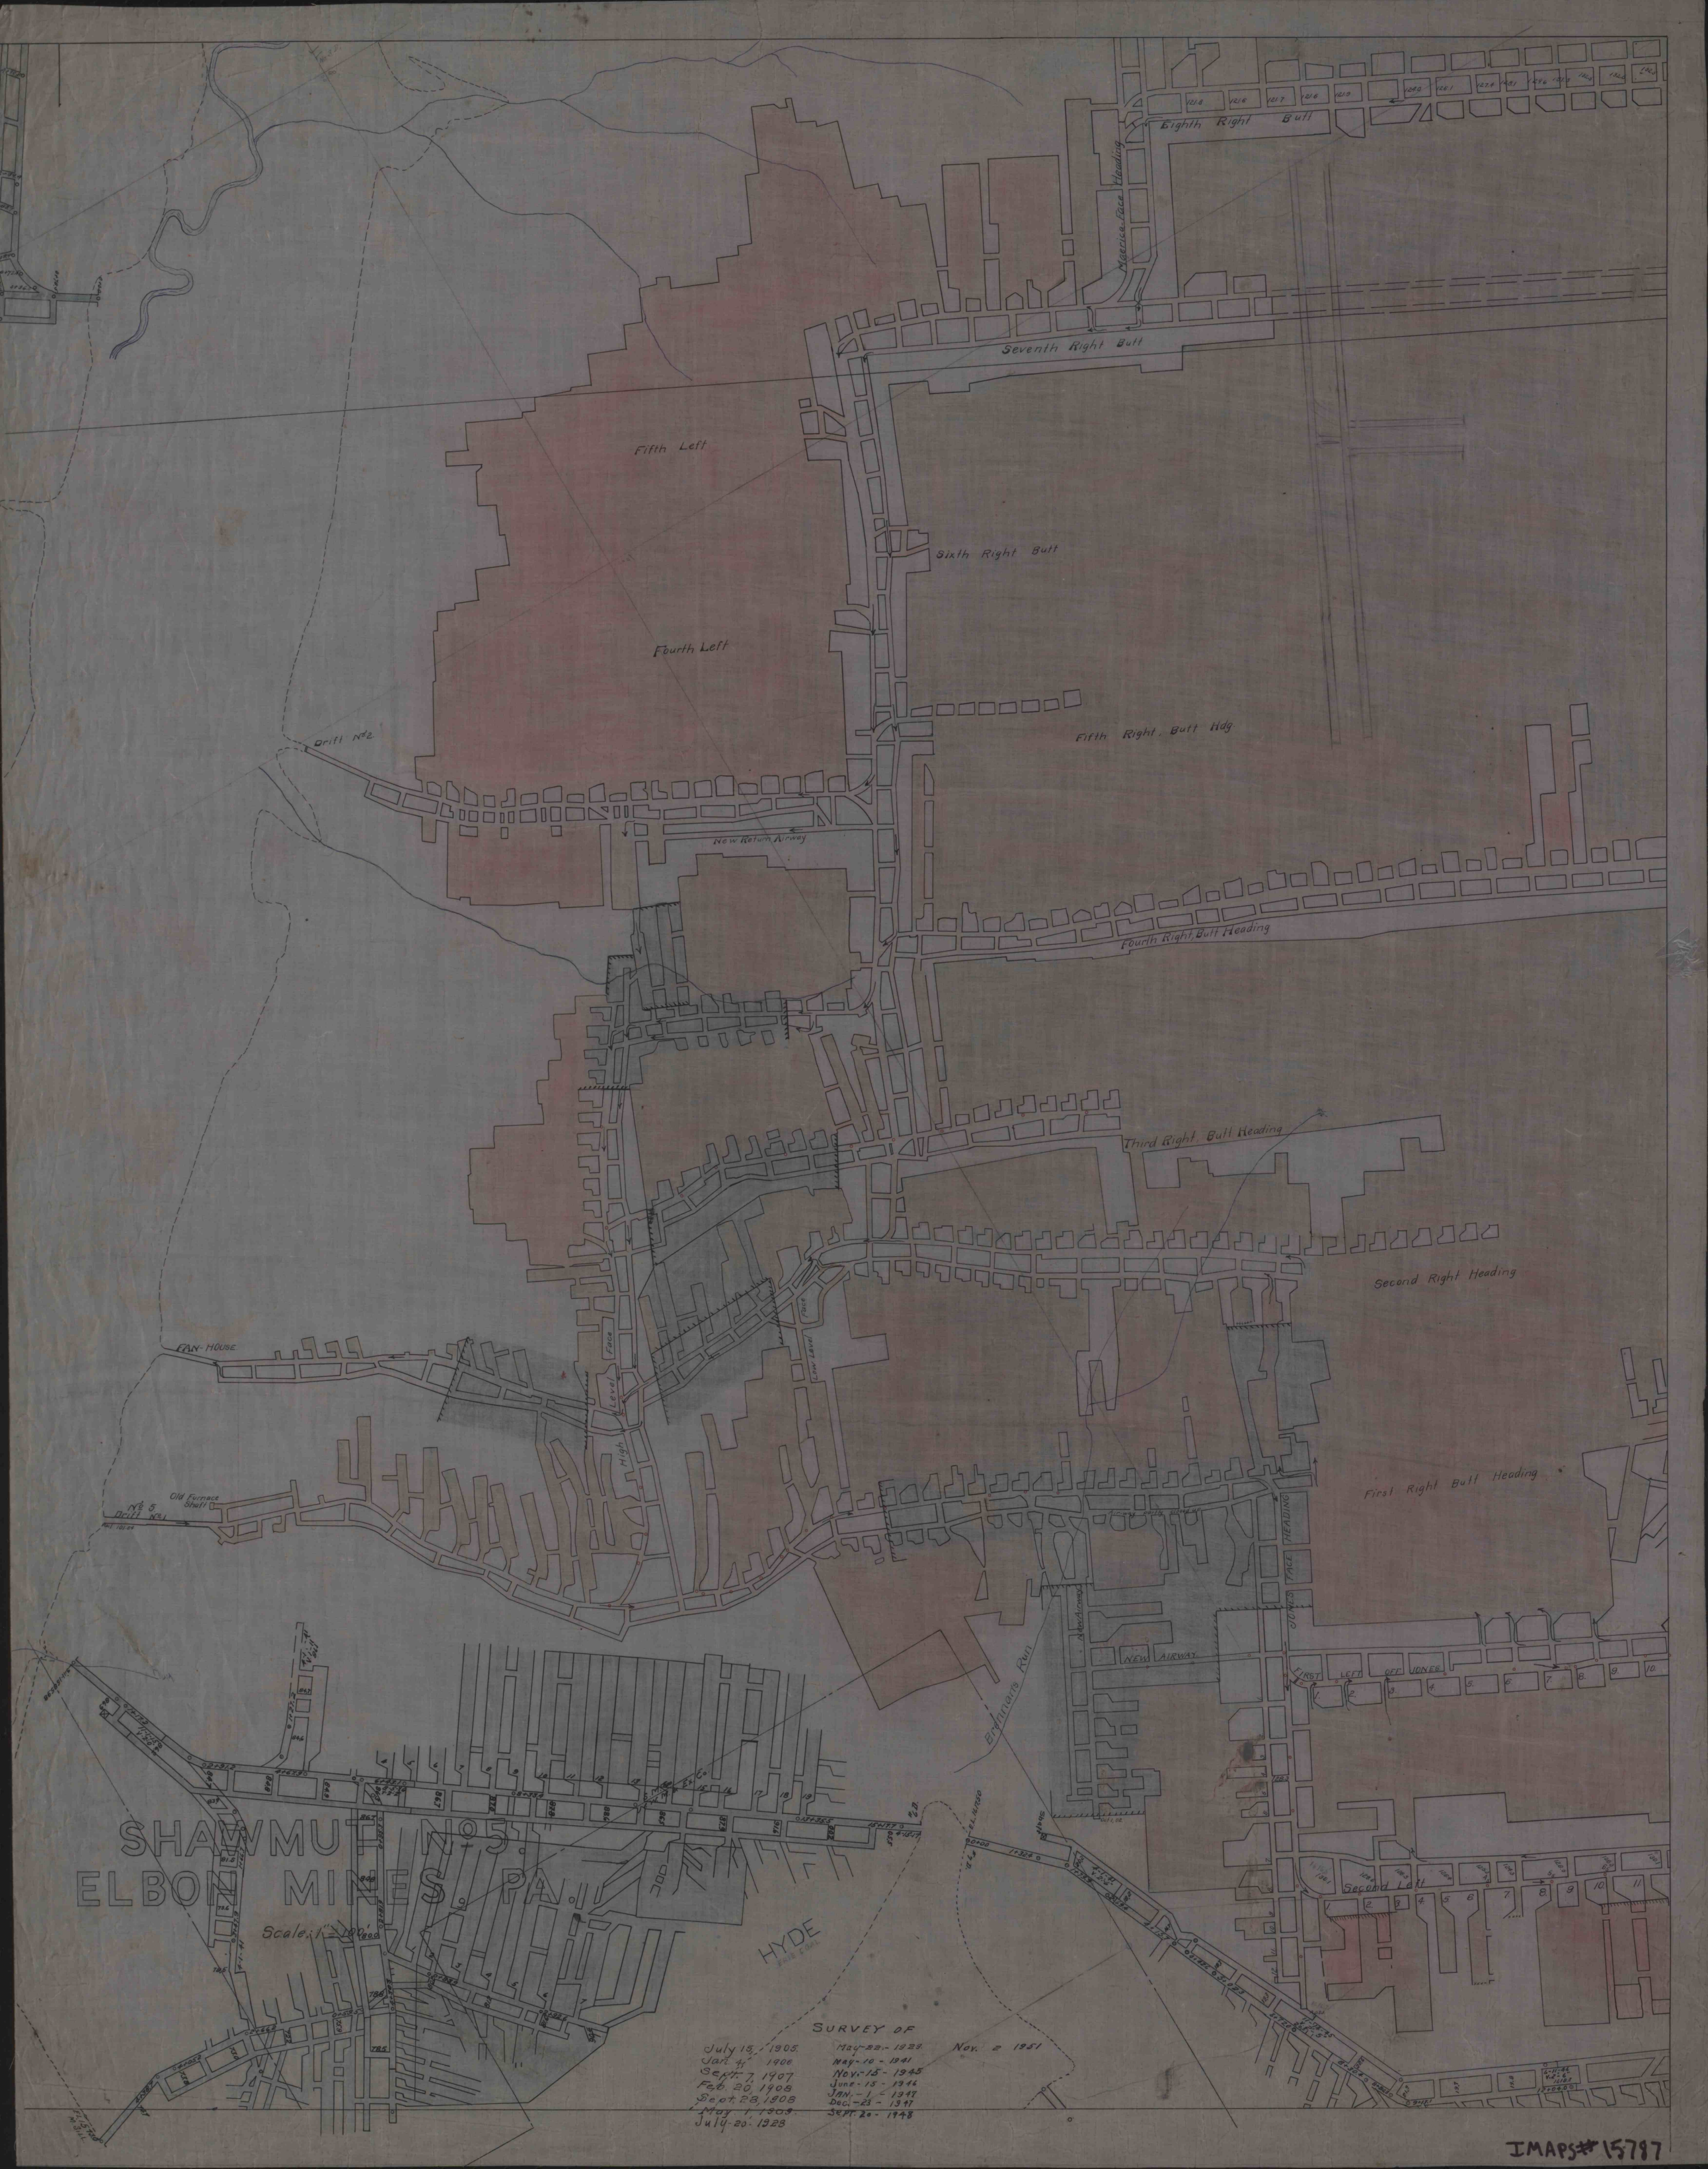

SHAWMUT ELBOW MINES, PA.

Scale: 1" = 200'

HYDE

SURVEY OF
July 13, 1905
Jan. 4, 1906
Sept. 7, 1907
Feb. 20, 1908
Sept. 28, 1908
May 1, 1909
July 20, 1923
May 22 - 1929
Nov. 10 - 1941
Nov. 15 - 1945
June 15 - 1946
Jan. - 1 - 1947
Dec. - 23 - 1947
Sept. 20 - 1948
Nov. 2 1951