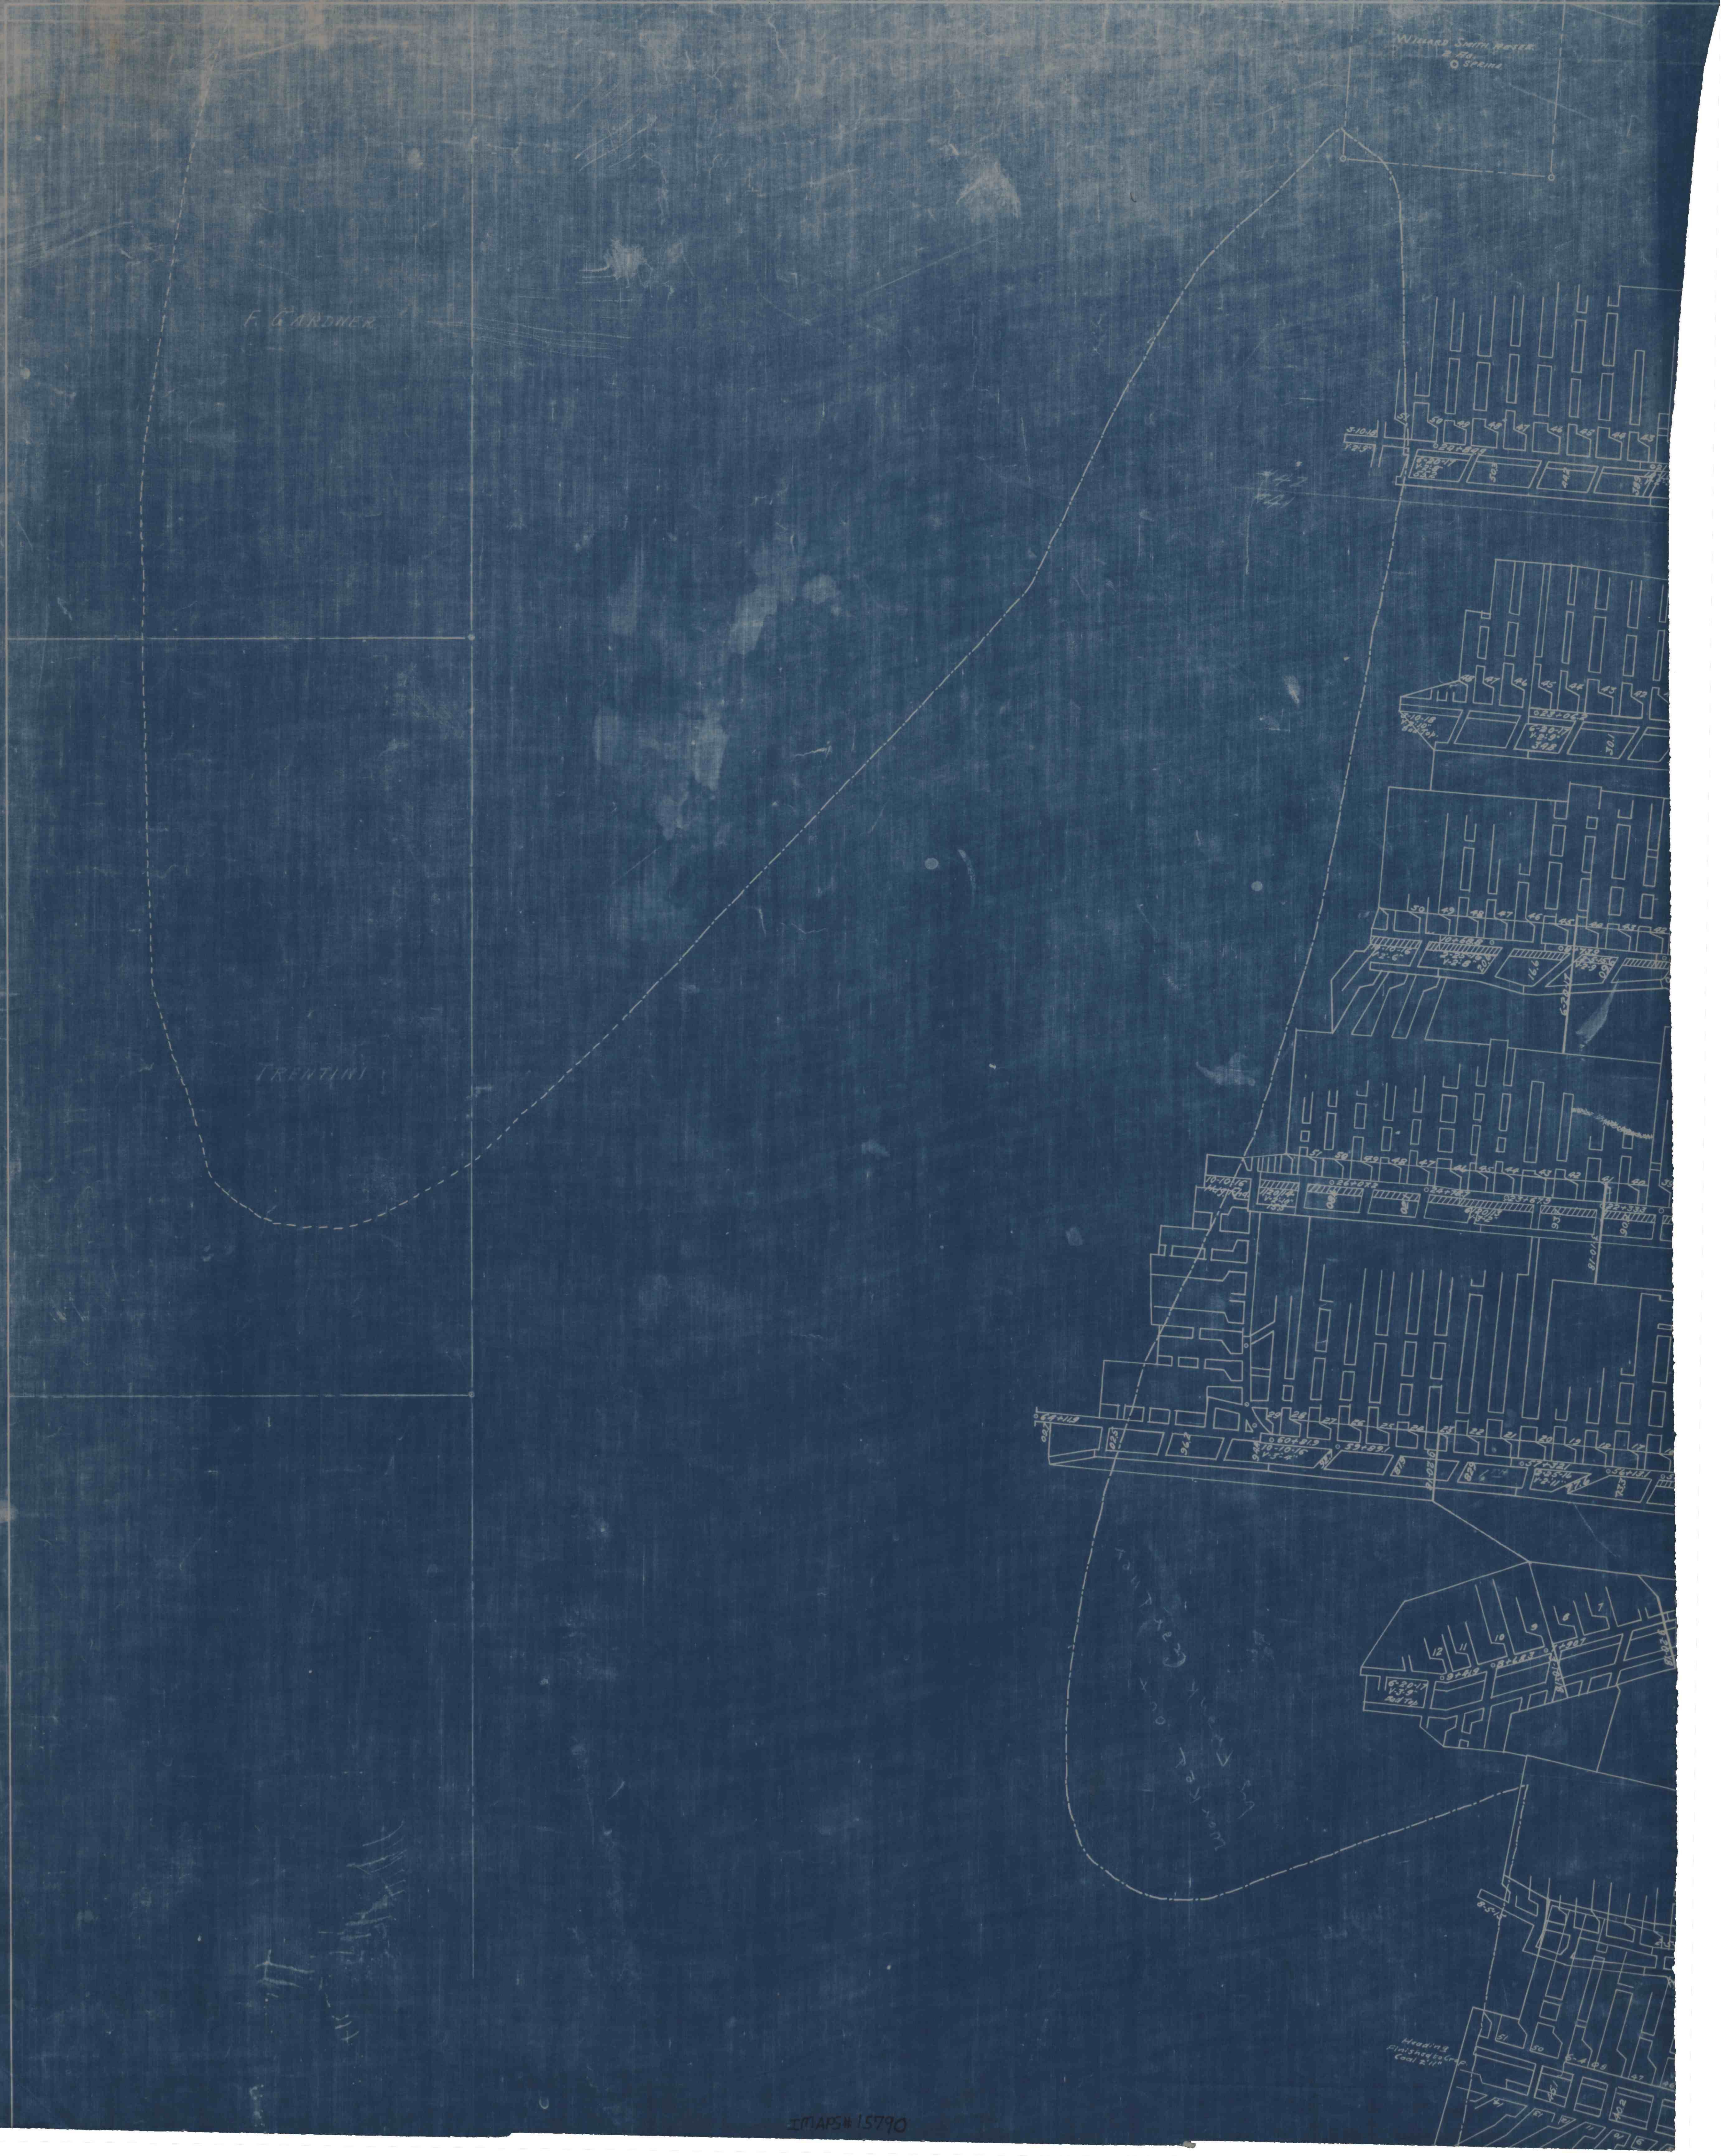
WILLARD SMITH RESER
2 AB.
SPRING
F. GARDNER
TRENTINI
51
Heading
Finished to Crop.
Coal 2'11"

IMAPS#15790