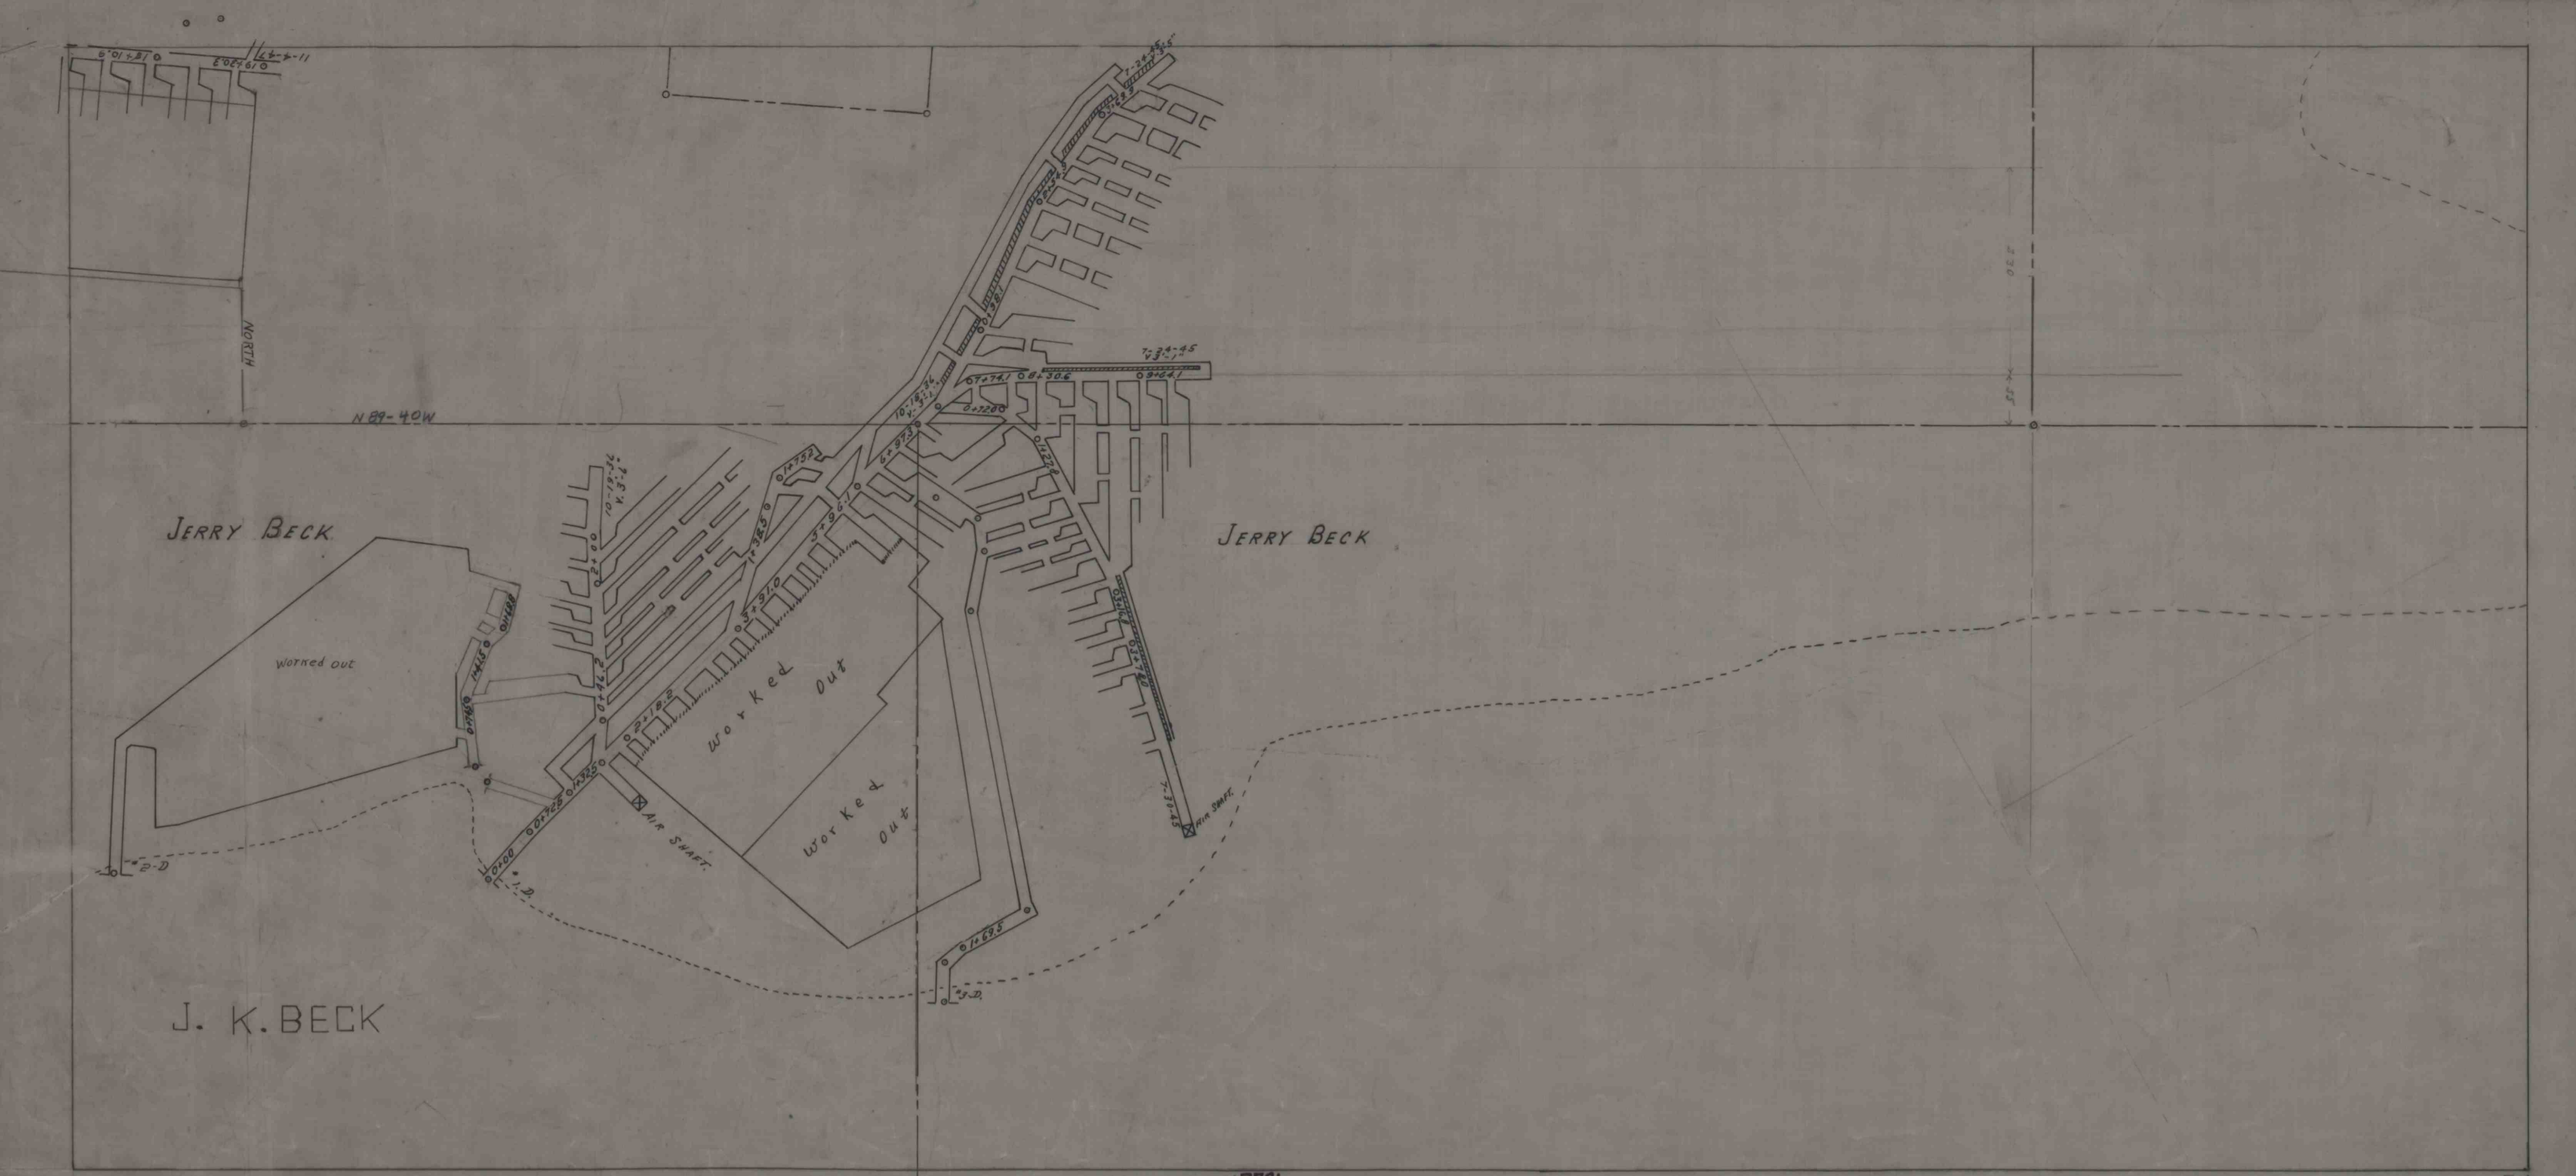
JERRY BECK
Worned out
N 89-40W
NORTH
worked out
worked out
AIR SHAFT
AIR SHAFT
JERRY BECK
J. K. BECK

IMAPS#15791