


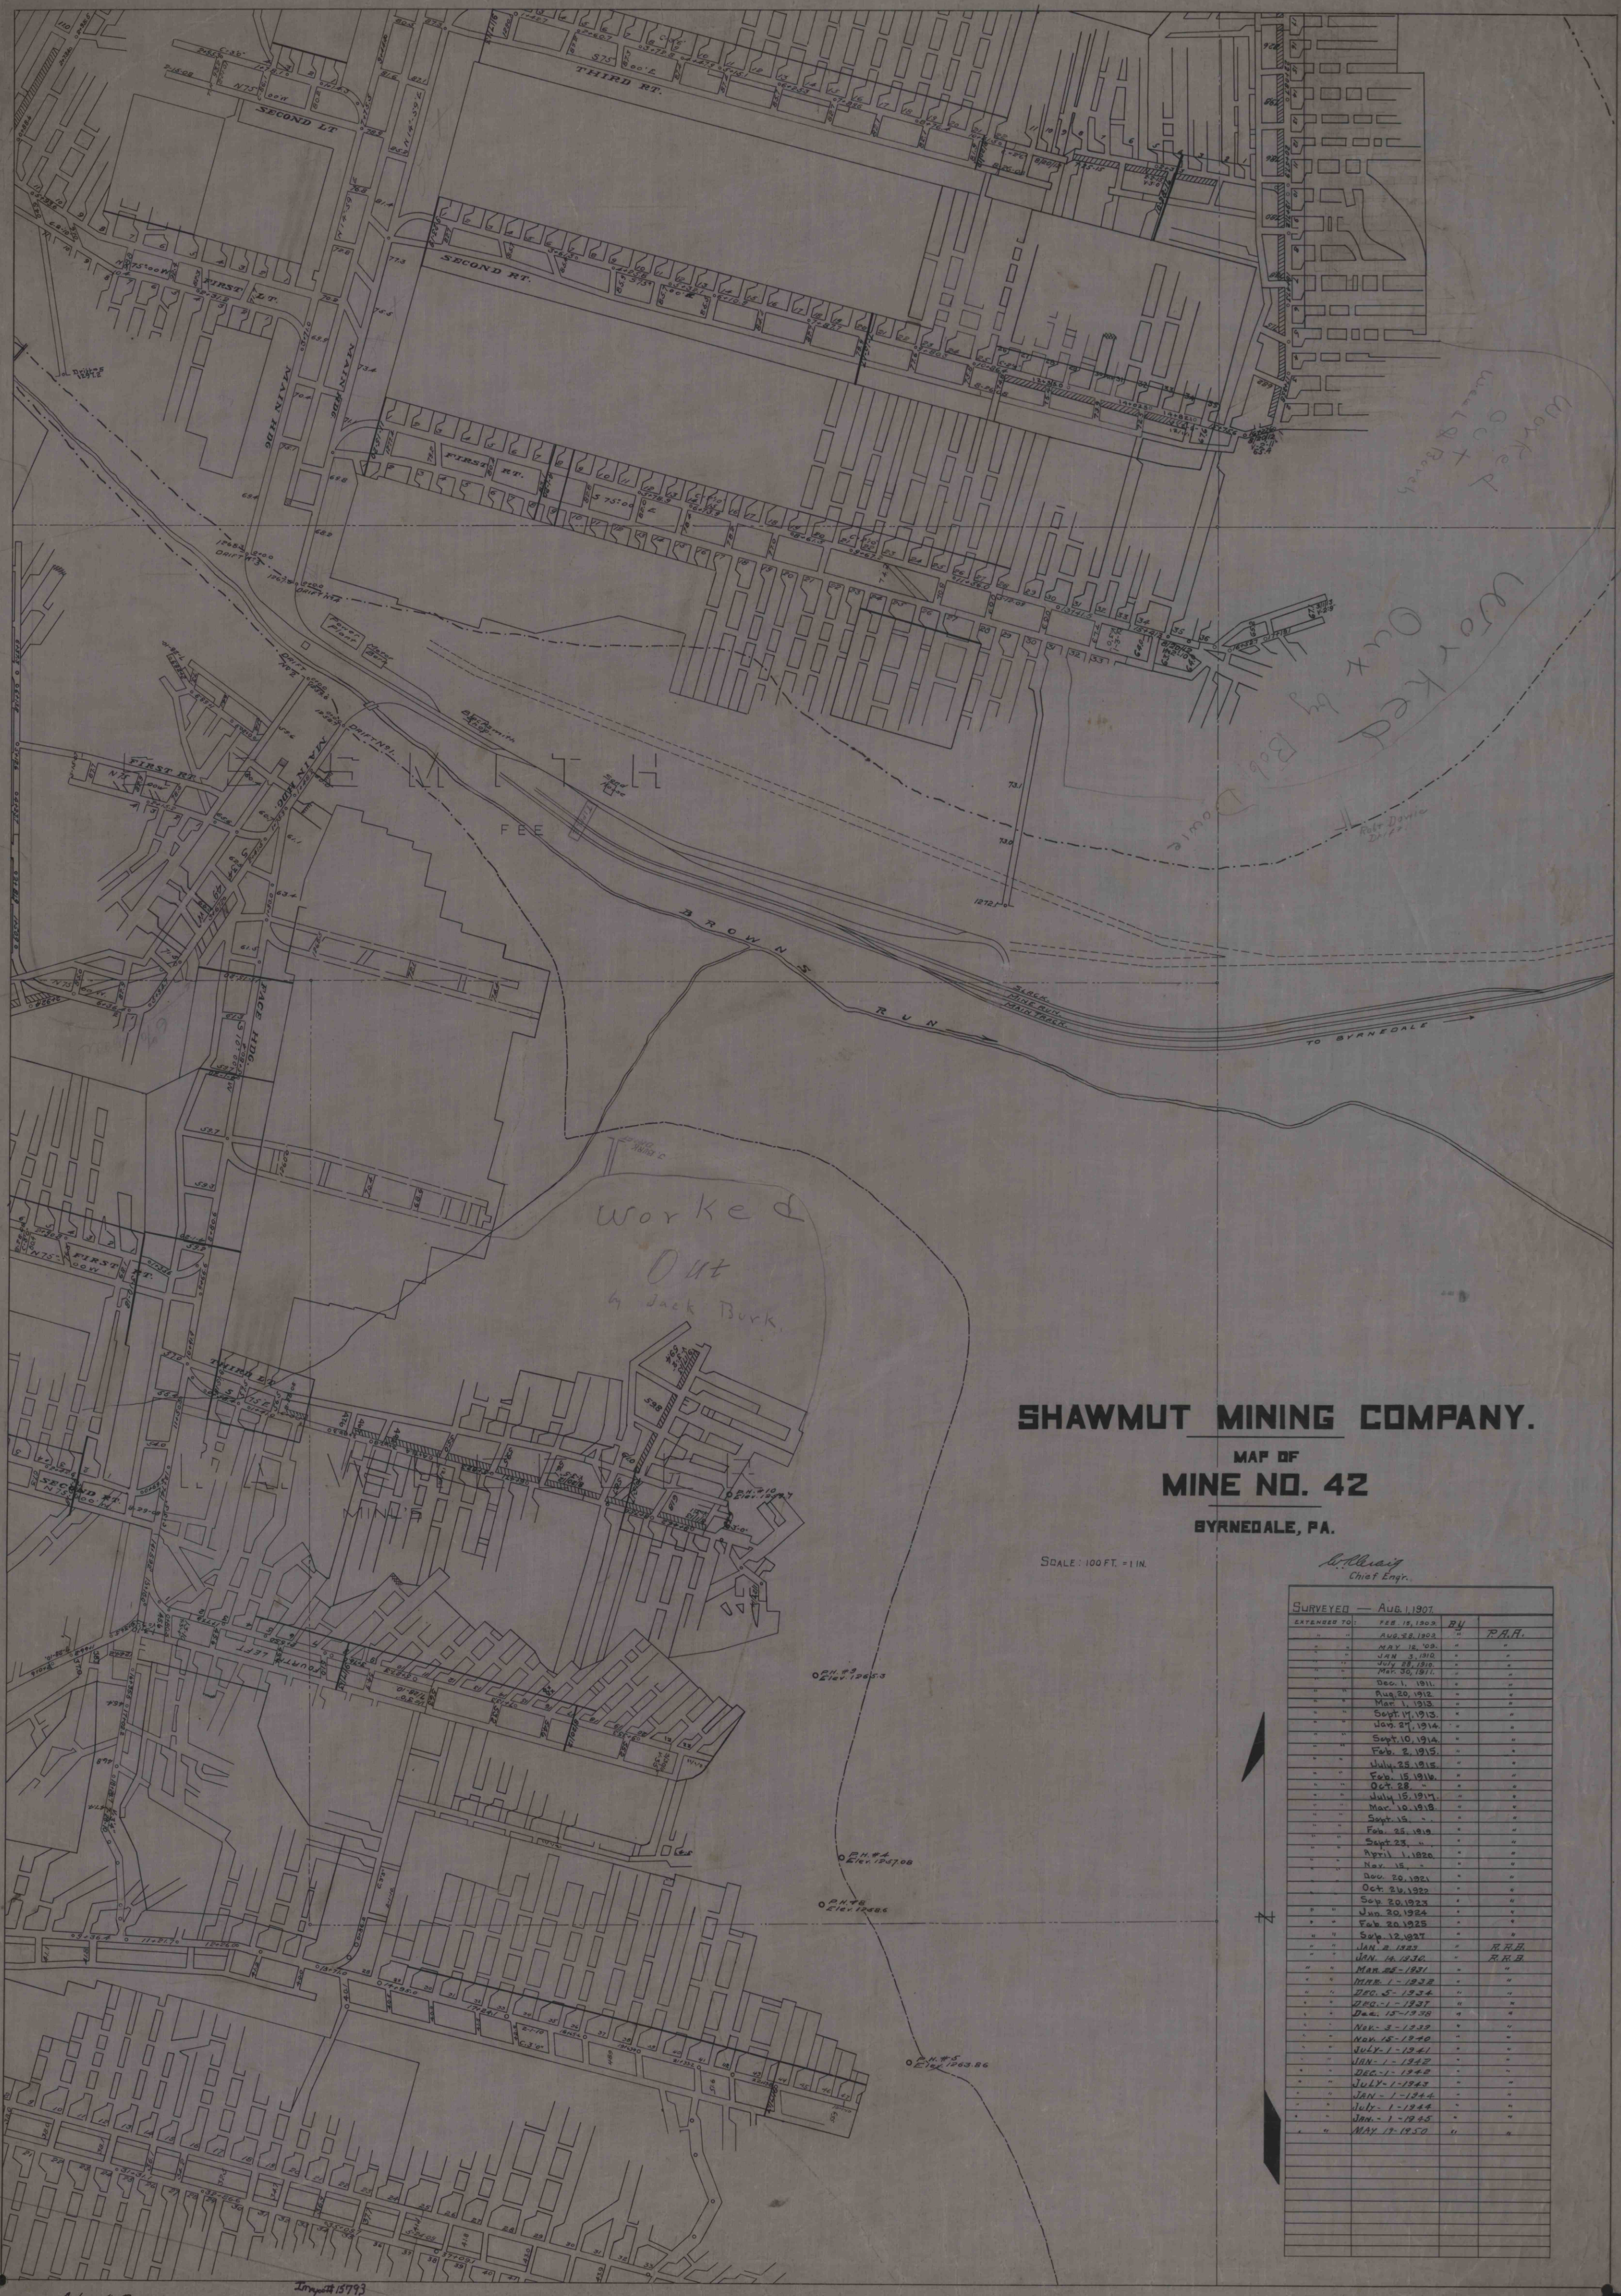

SHAWMUT MINING COMPANY.

MAP OF
MINE NO. 42
BYRNEDALE, PA.

SCALE: 100 FT. = 1 IN.

L. H. H. H.
Chief Engr.

SURVEYED — AUG. 1, 1907			
EXTENDED TO:	DATE	BY	REMARKS
"	FEB. 15, 1908	R. H.	P. H. H.
"	AUG. 28, 1908	"	"
"	MAY 18, 1909	"	"
"	JAN. 3, 1910	"	"
"	MAY 23, 1910	"	"
"	MAY 30, 1911	"	"
"	Dec. 1, 1911	"	"
"	Aug. 20, 1912	"	"
"	Mar. 1, 1913	"	"
"	Sept. 11, 1913	"	"
"	Jan. 27, 1914	"	"
"	Sept. 10, 1914	"	"
"	Feb. 2, 1915	"	"
"	July 25, 1915	"	"
"	Feb. 15, 1916	"	"
"	Oct. 28	"	"
"	July 15, 1917	"	"
"	Mar. 10, 1918	"	"
"	Sept. 15	"	"
"	Feb. 25, 1919	"	"
"	Sept. 23	"	"
"	April 1, 1920	"	"
"	Mar. 15	"	"
"	Dec. 20, 1921	"	"
"	Oct. 20, 1922	"	"
"	Sept. 20, 1923	"	"
"	Jan. 20, 1924	"	"
"	Feb. 20, 1925	"	"
"	Sept. 12, 1927	"	"
"	JAN. 2, 1929	"	R. H. H.
"	JAN. 10, 1930	"	R. H. H.
"	MAR. 25, 1931	"	"
"	MAR. 1, 1932	"	"
"	DEC. 5, 1934	"	"
"	DEC. 1, 1937	"	"
"	Dec. 15, 1938	"	"
"	Nov. 3, 1939	"	"
"	Nov. 15, 1940	"	"
"	JULY 1, 1941	"	"
"	JAN. 1, 1942	"	"
"	DEC. 1, 1942	"	"
"	JULY 1, 1943	"	"
"	JAN. 1, 1944	"	"
"	July 1, 1944	"	"
"	Jan. 1, 1945	"	"
"	MAY 17, 1950	"	"