


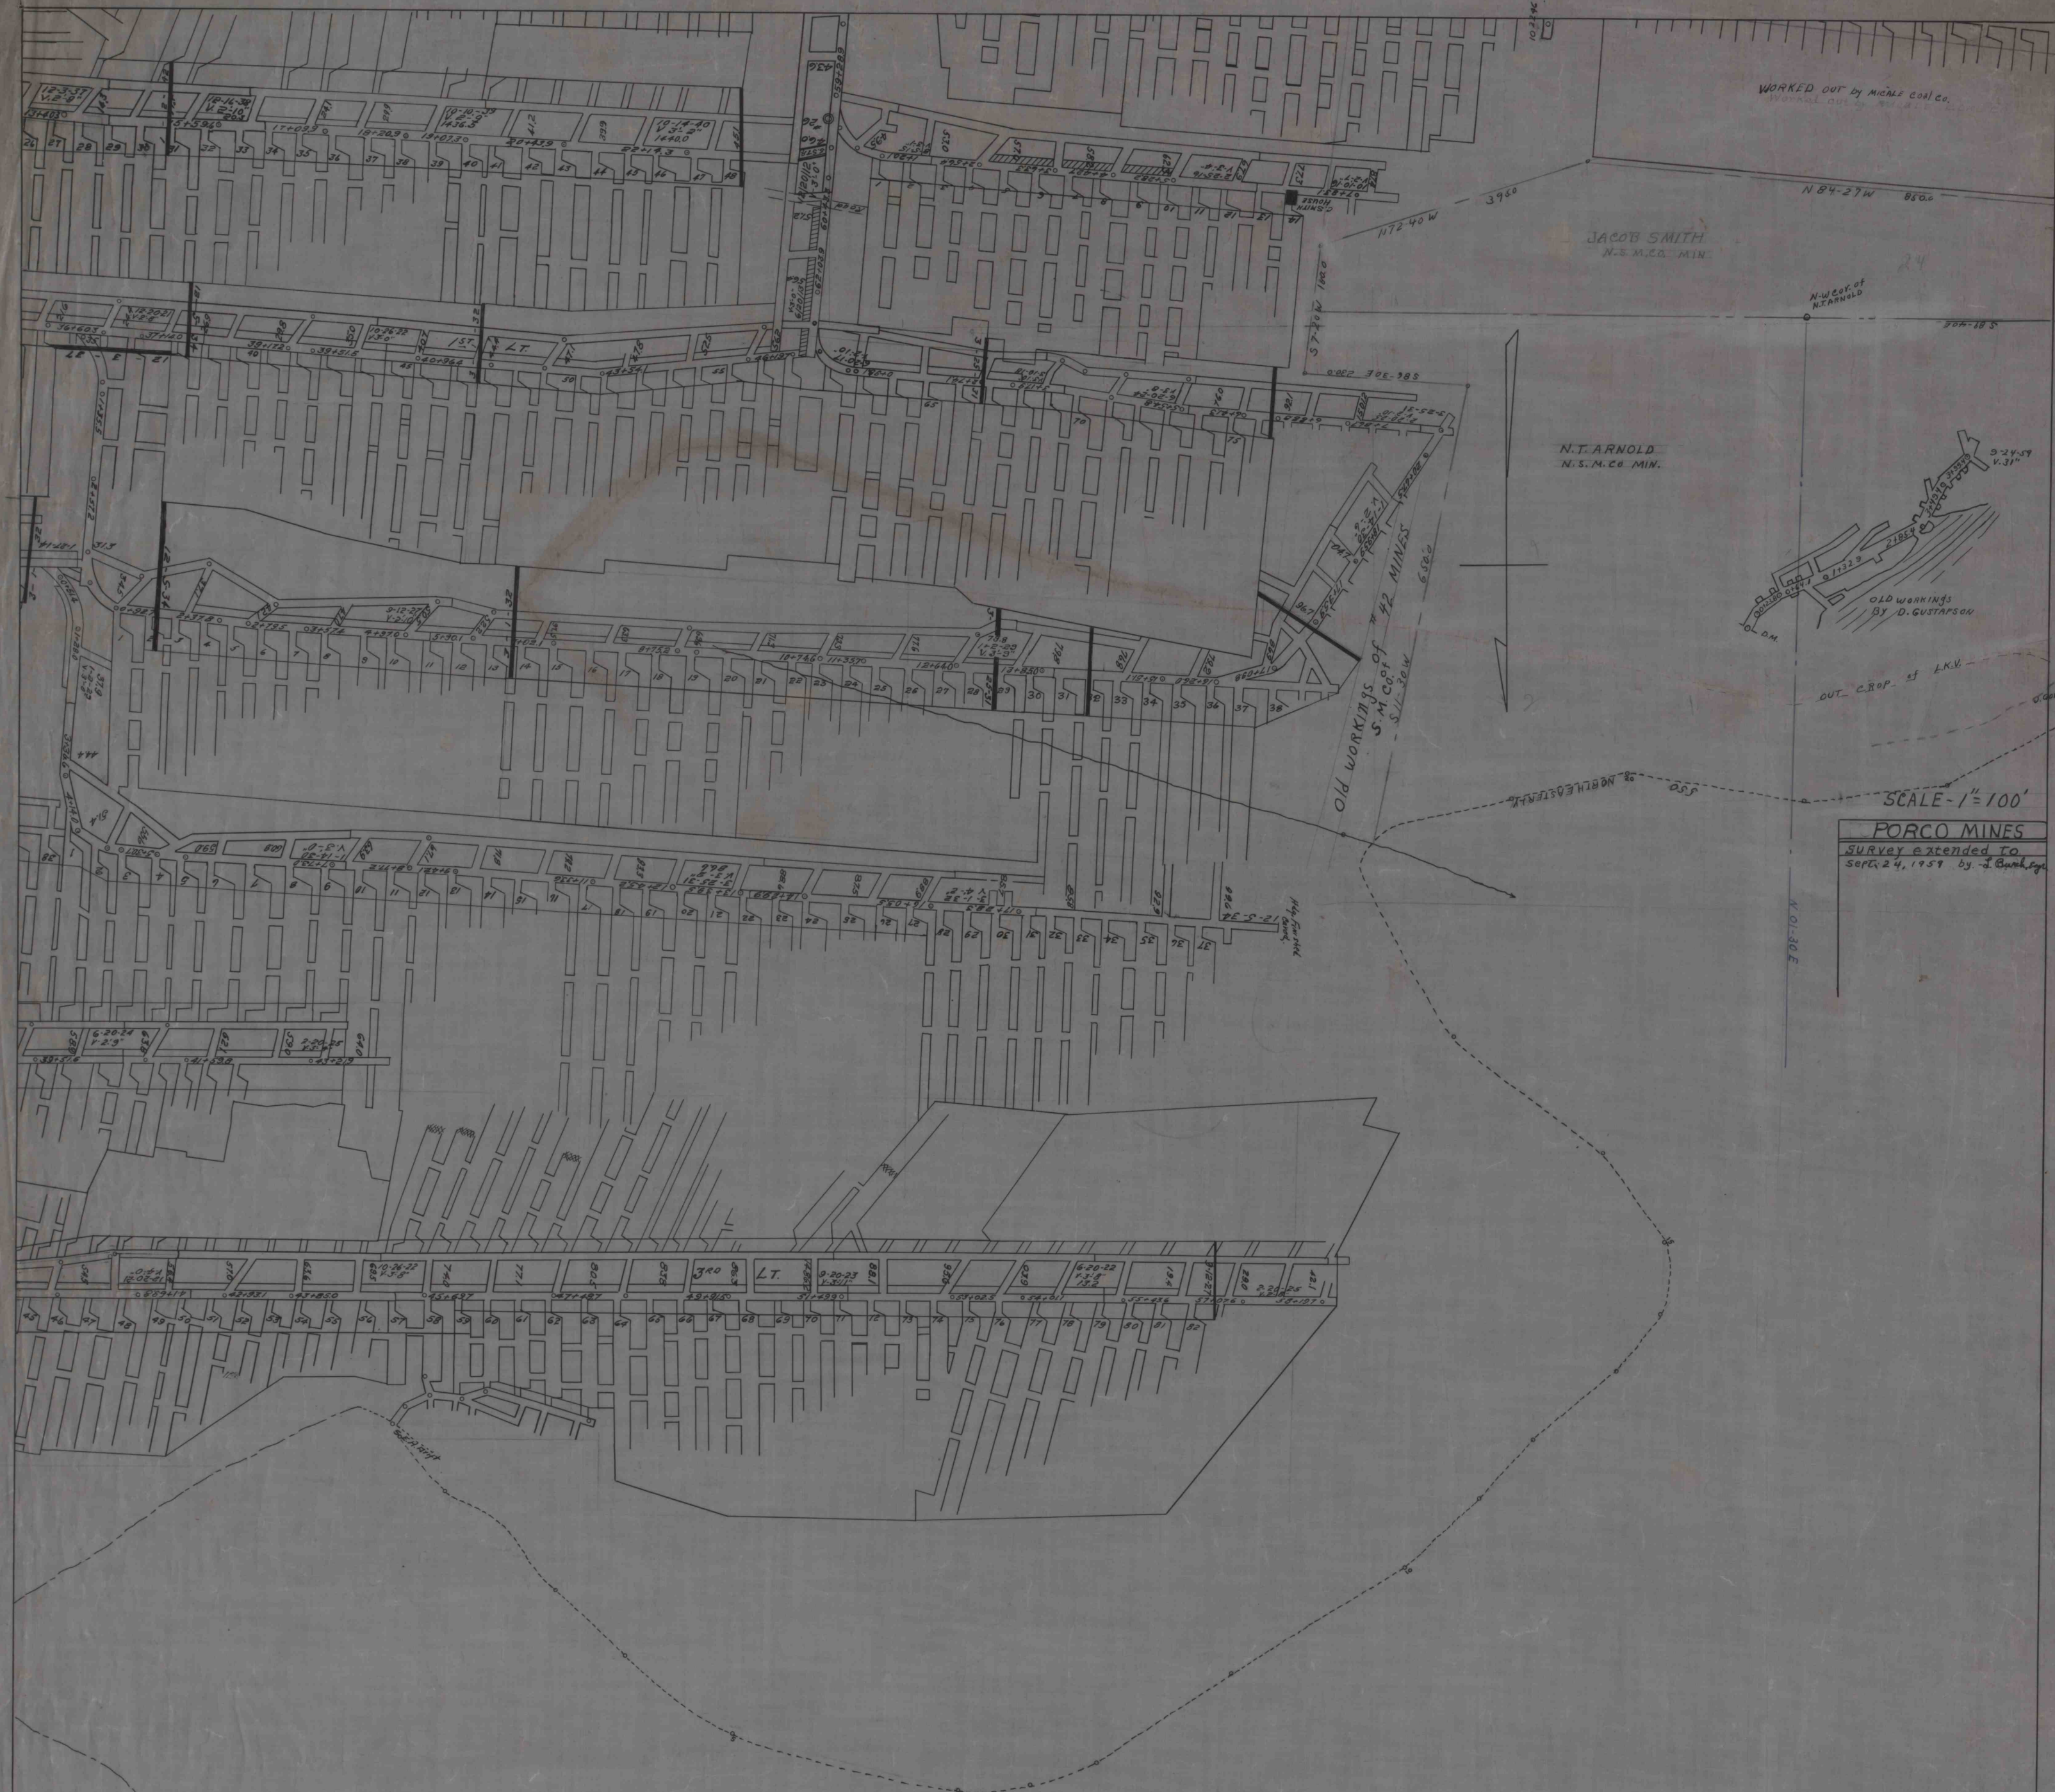

SCALE - 1" = 100'
PORCO MINES
Survey extended to
Sept. 24, 1951 by J. B. B. B.