


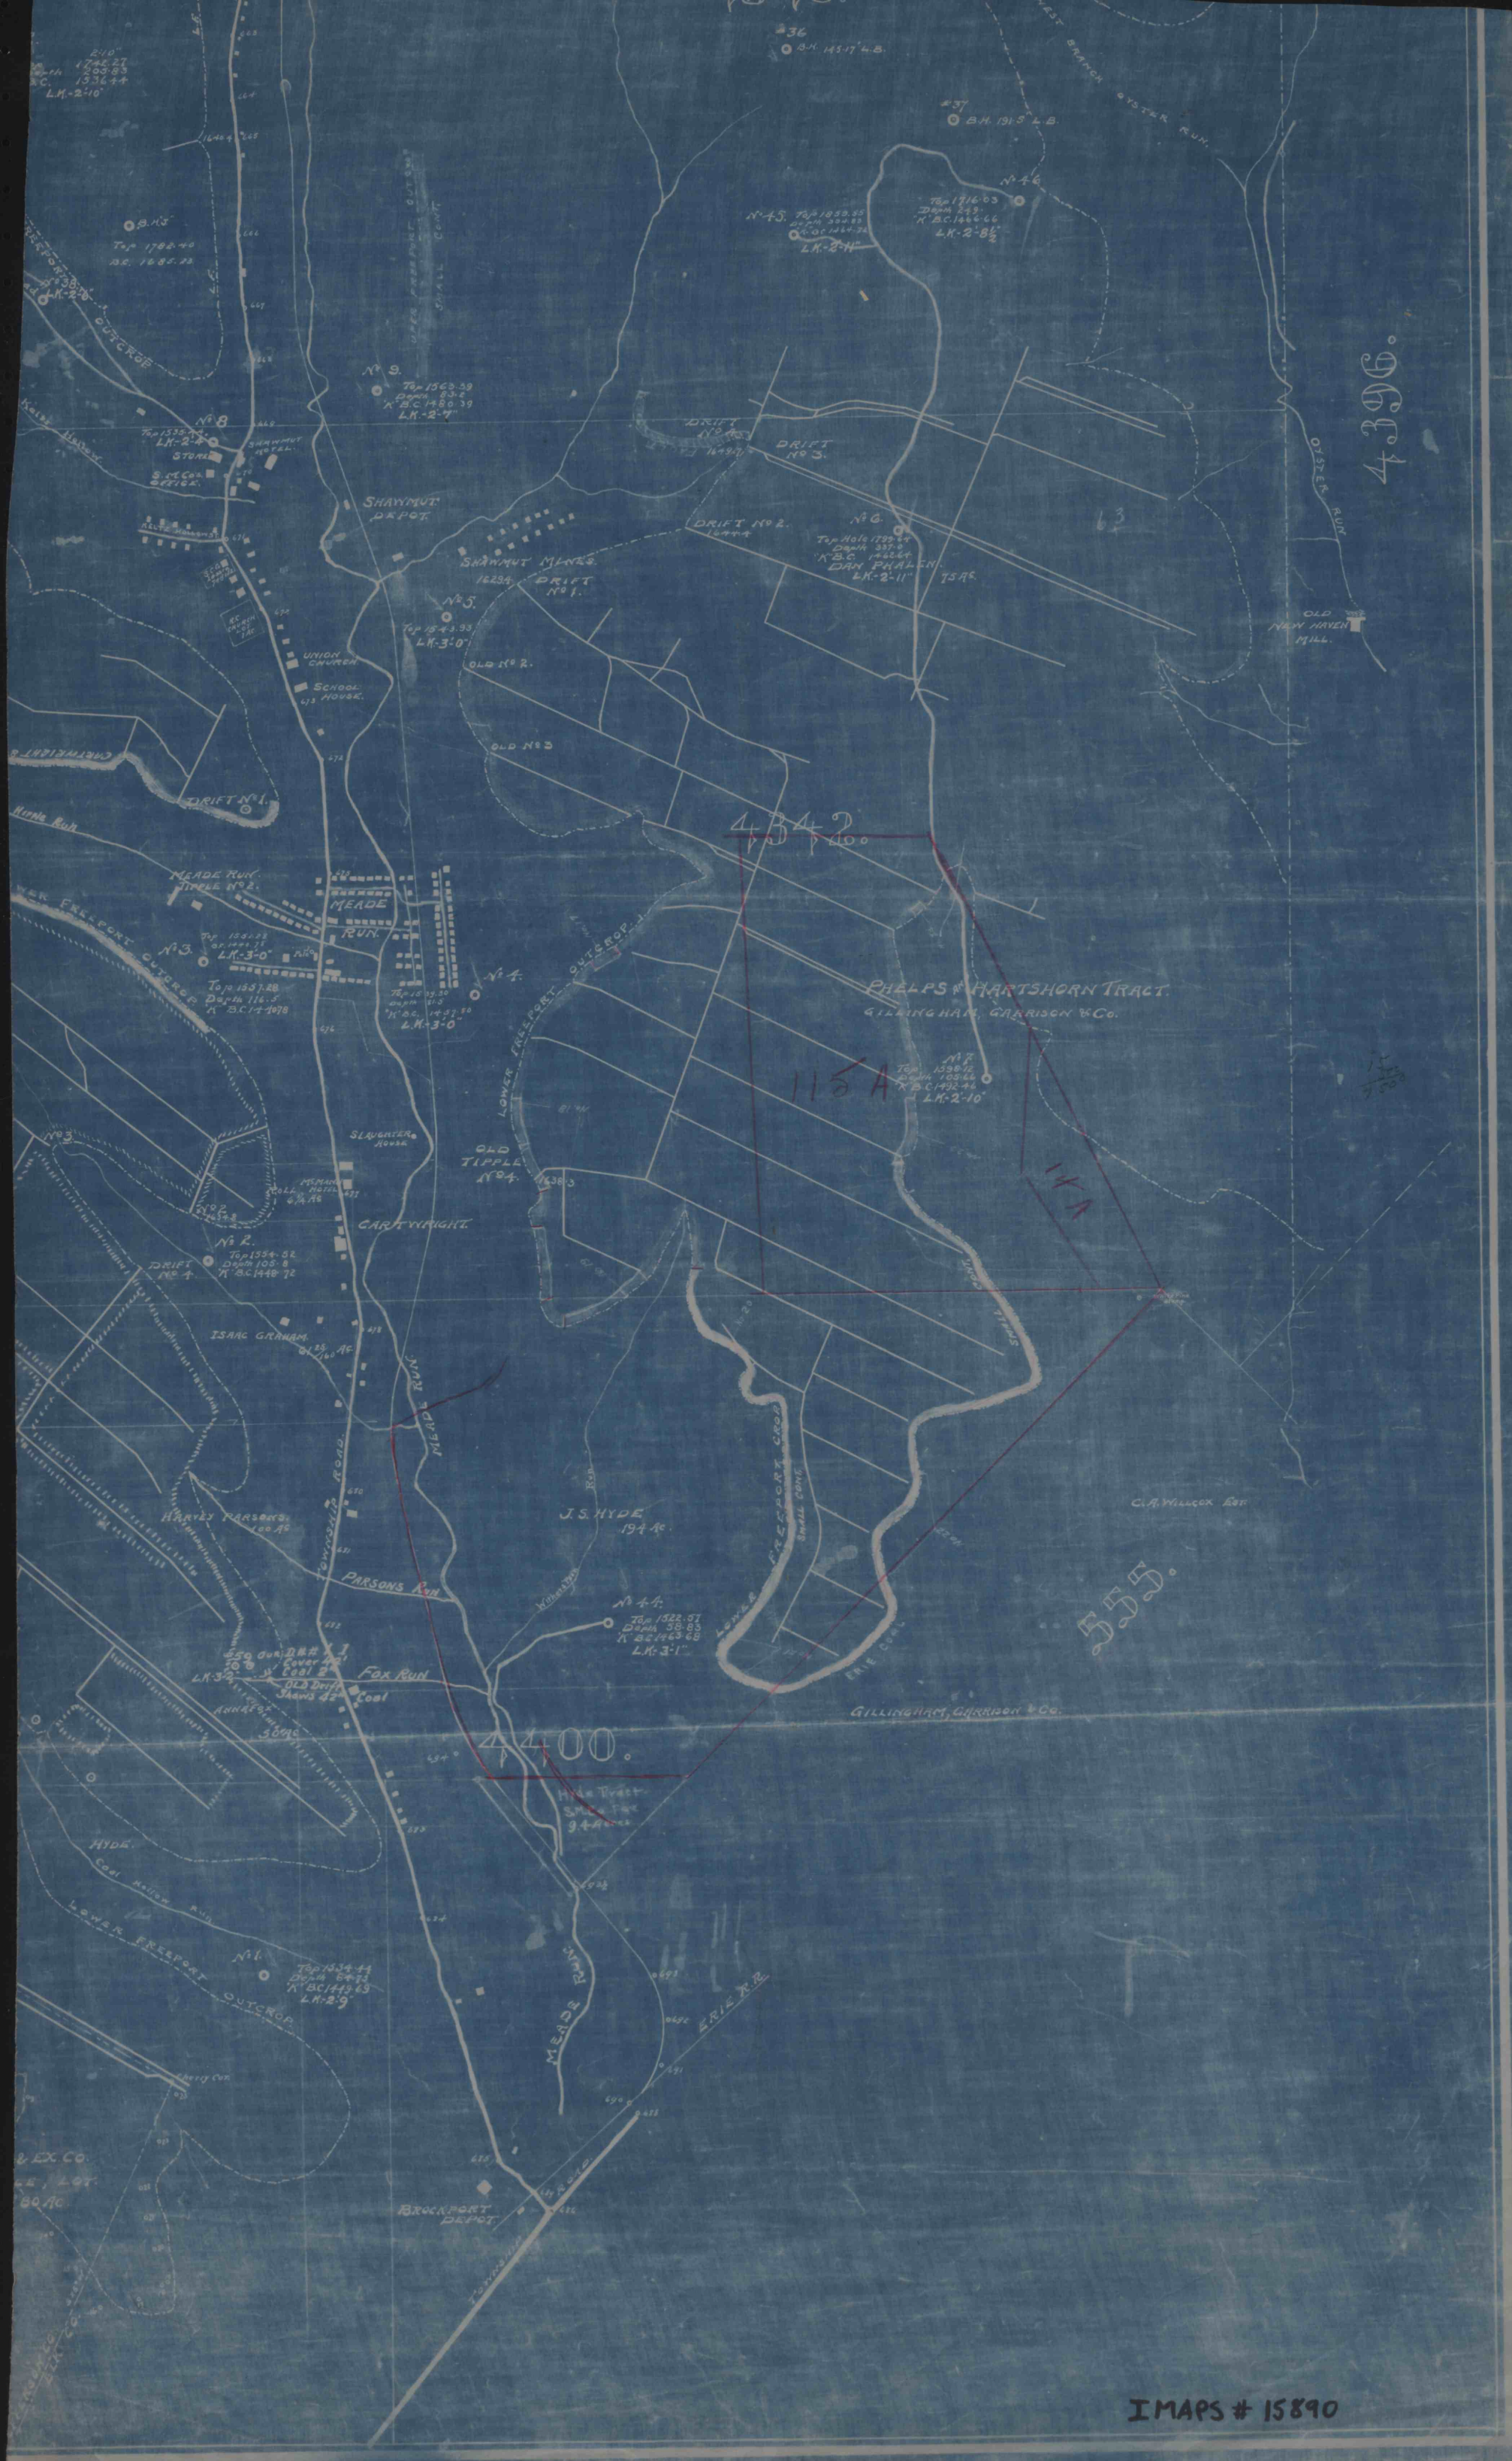

4396.

4342.

115A

14A

555.

4400.