


Boys' Club has been changed
 to Memorial Park

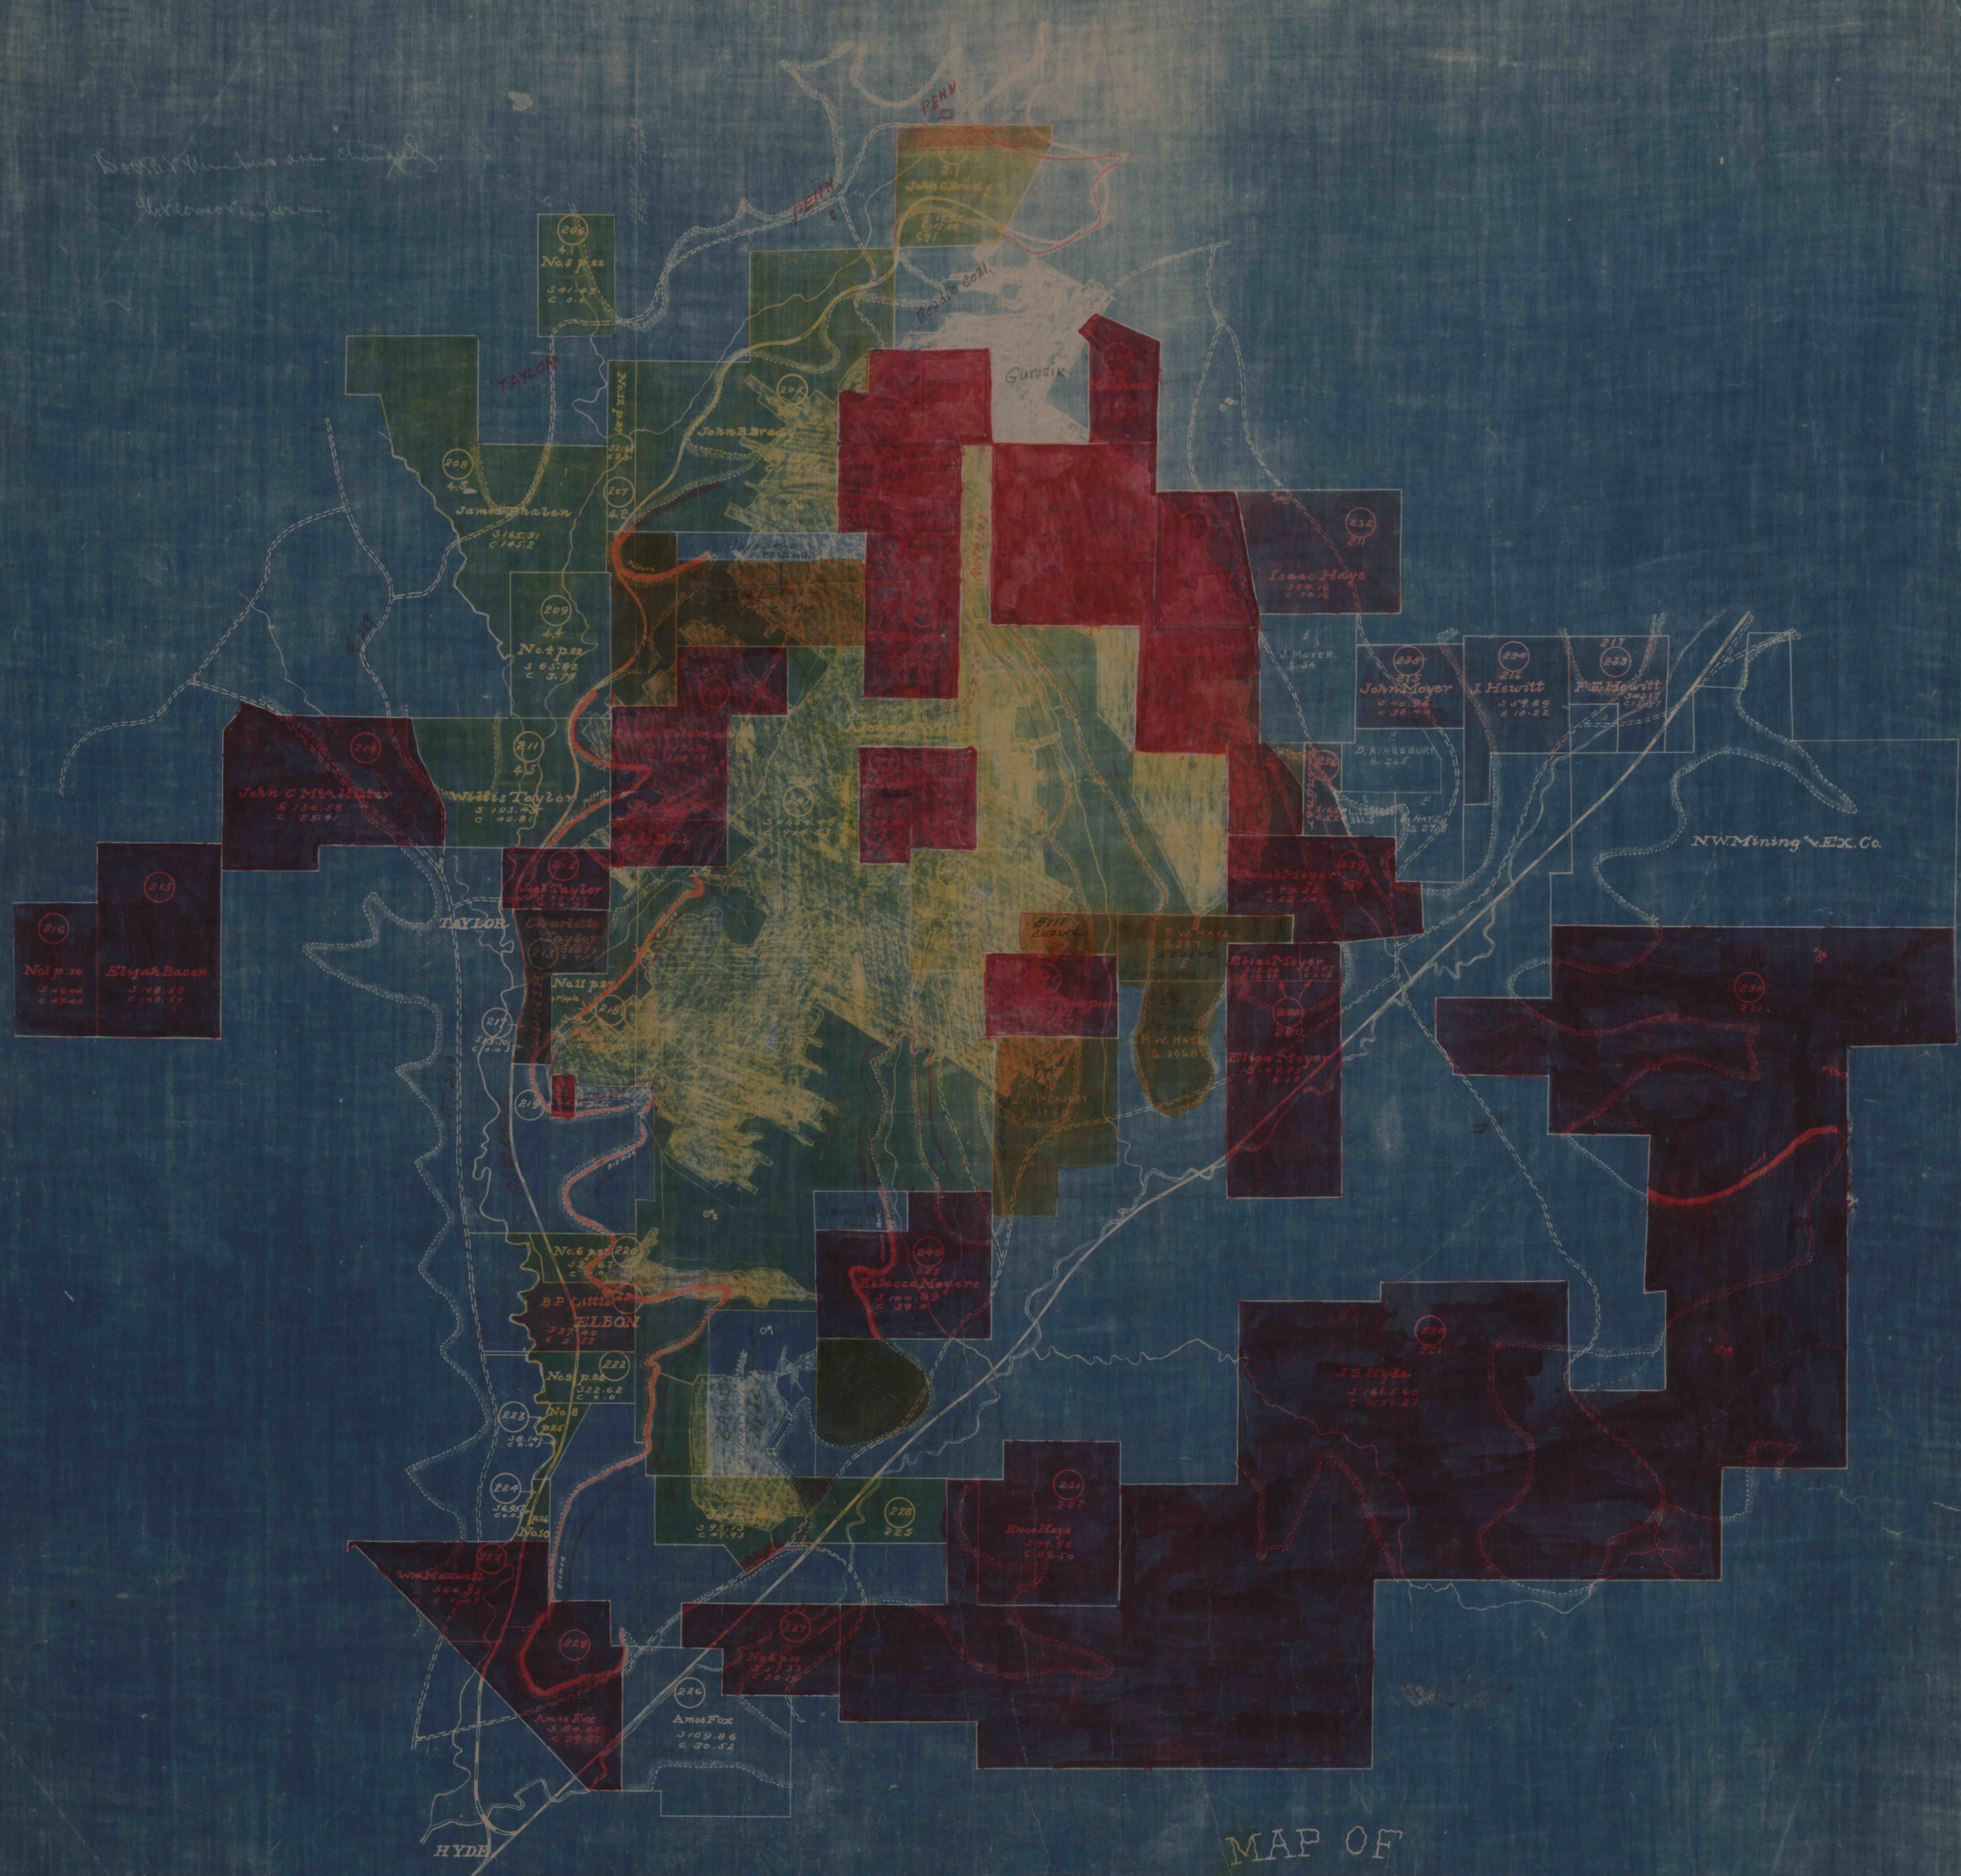

MAP OF ELBON FIELD SHAWMUT MIN. CO.

Scale 1 in = 1000 ft. 1905.

- N.S.M.Co. Min.
 - N.S.M.Co. Surface.
 - N.S.M.Co. in Fee
 - ERIE LEASE TO N.S.M.Co.
- IMAPS # 15900