


← Progress with Map
 P = Roof Occasional

→ FLOW DIRECTION

SBP From Coal & Roof
 W = Water U.K. Source?
 COLLECTED WATER - LARGE AMOUNT.

#7

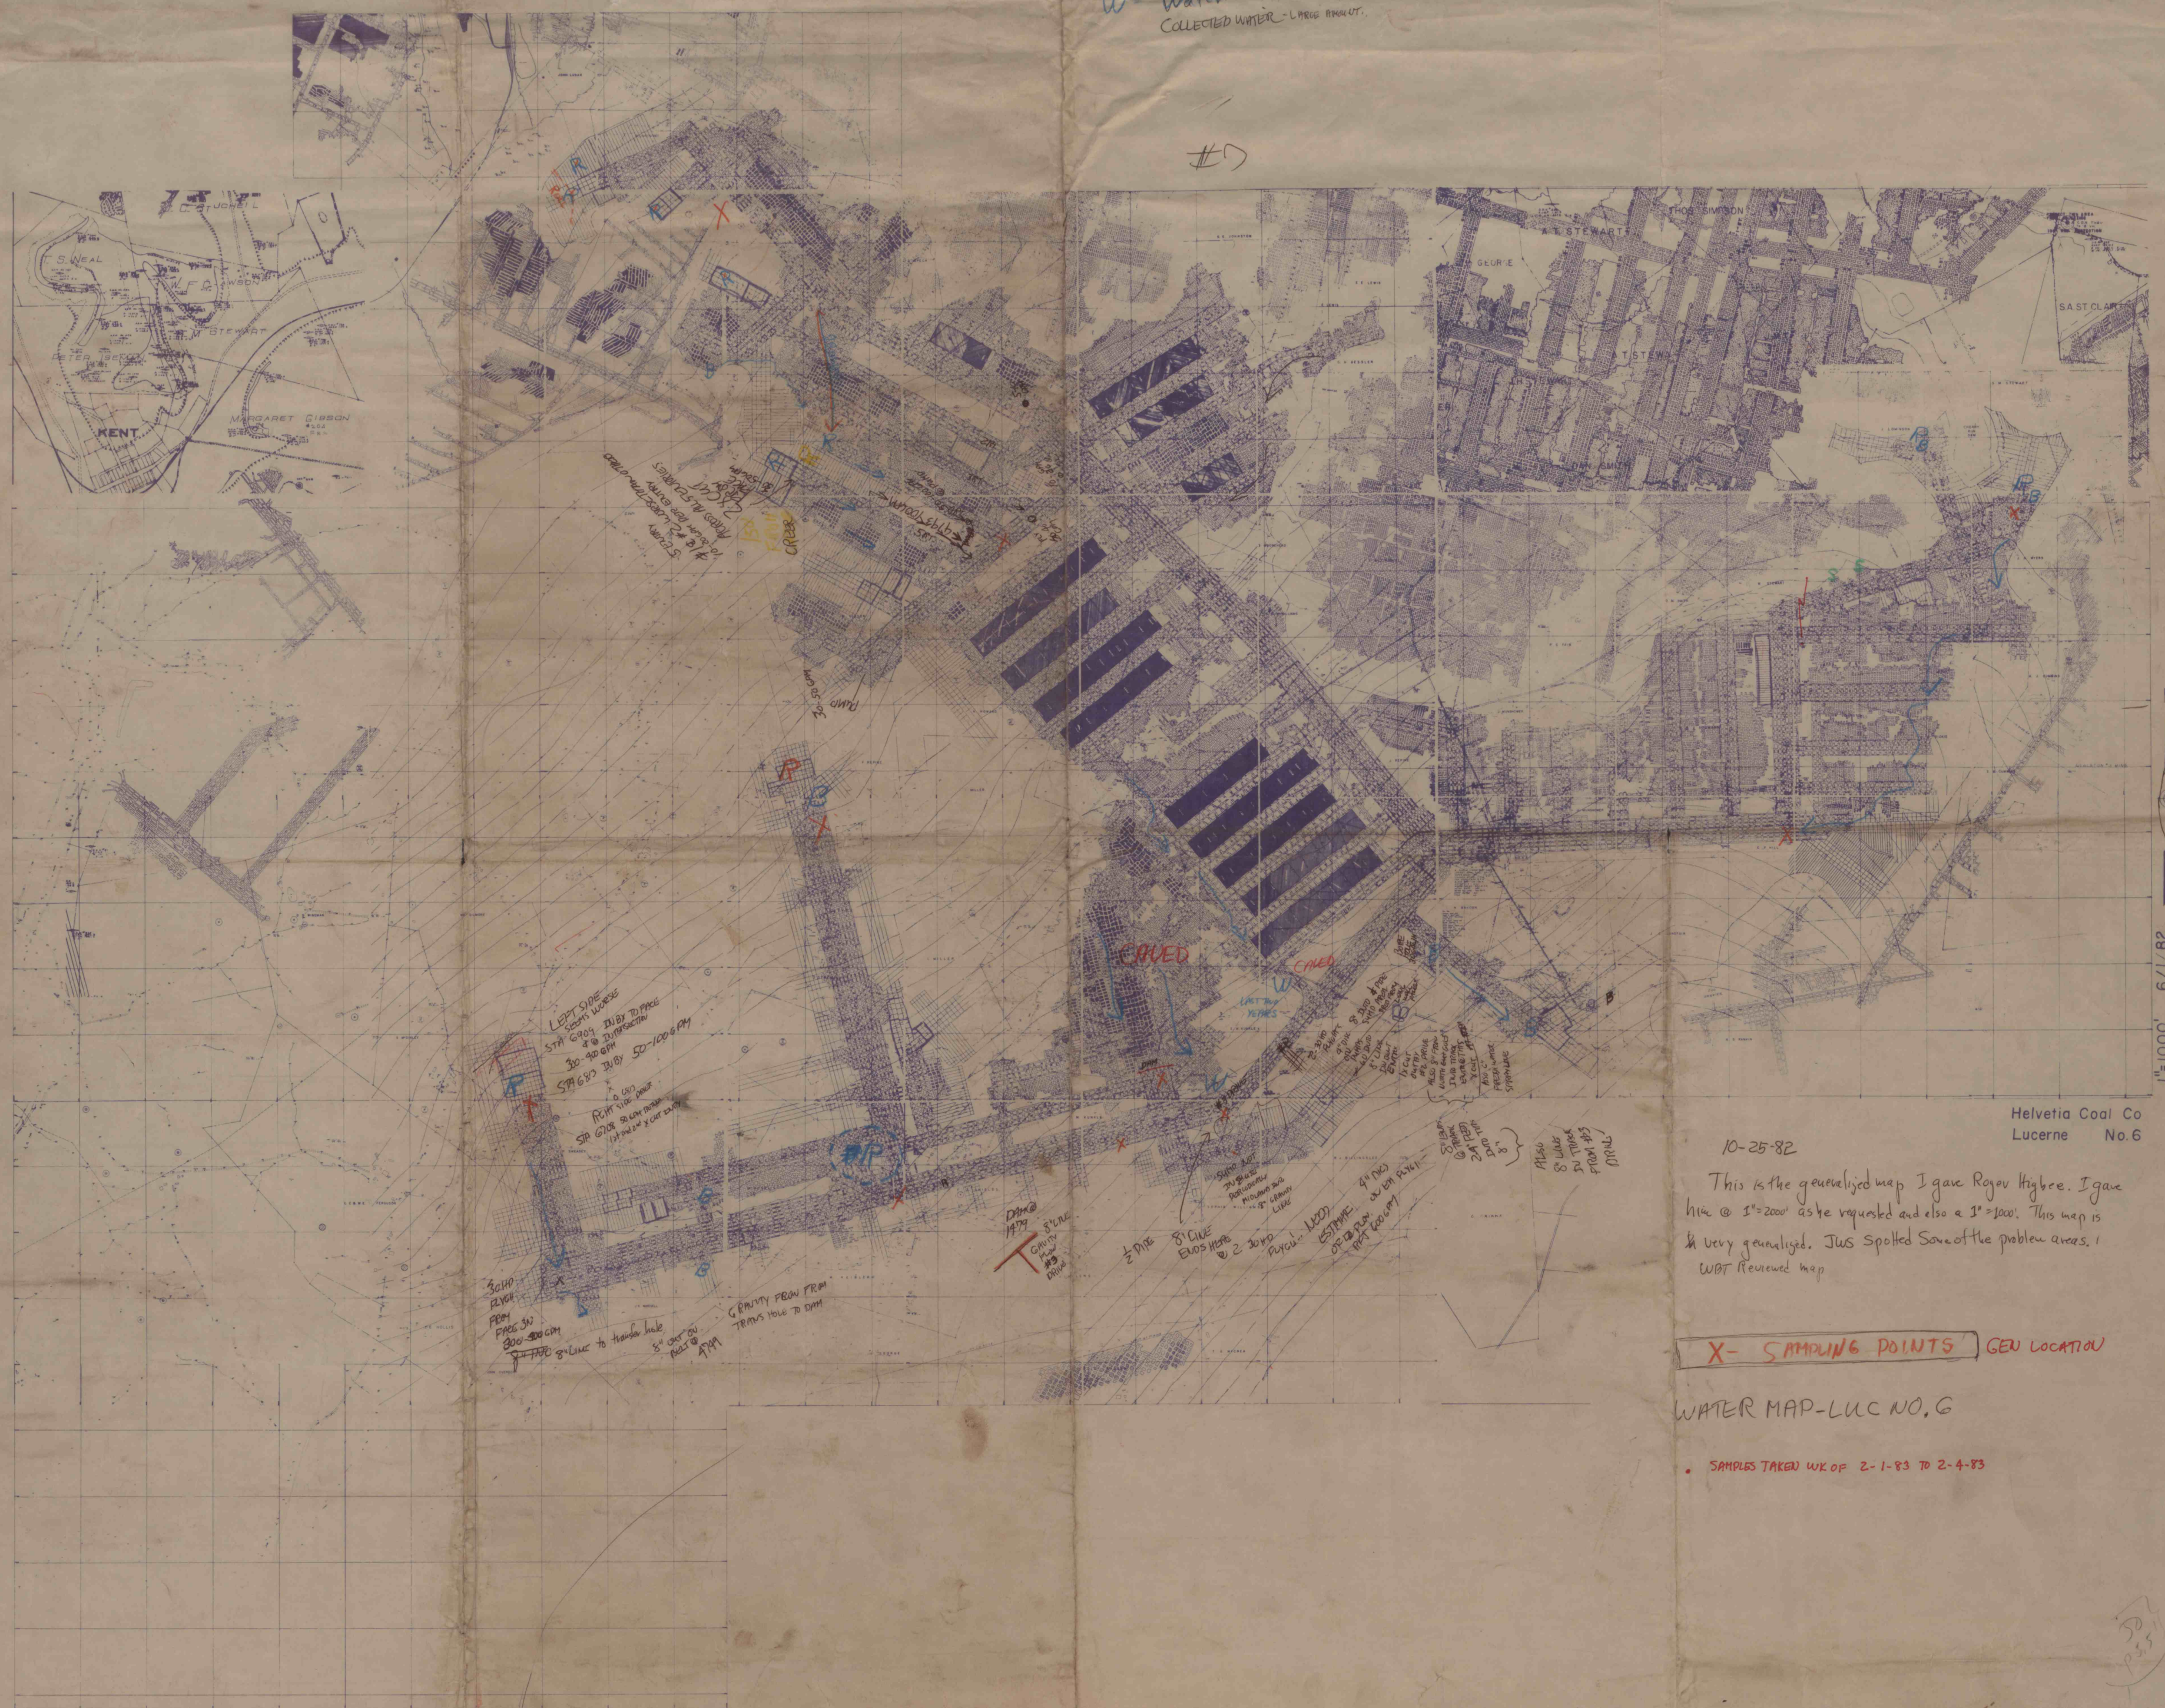

Helvetia Coal Co
 Lucerne No. 6

10-25-82

This is the generalized map I gave Royce Hight. I gave him @ 1"=2000' as he requested and also a 1"=1000'. This map is a very generalized. I just spotted some of the problem areas. I WBT Reviewed map

X- SAMPLING POINTS GEN LOCATION

WATER MAP-LUC NO. 6

• SAMPLES TAKEN WK OF 2-1-83 TO 2-4-83

IMAPS # 15932

