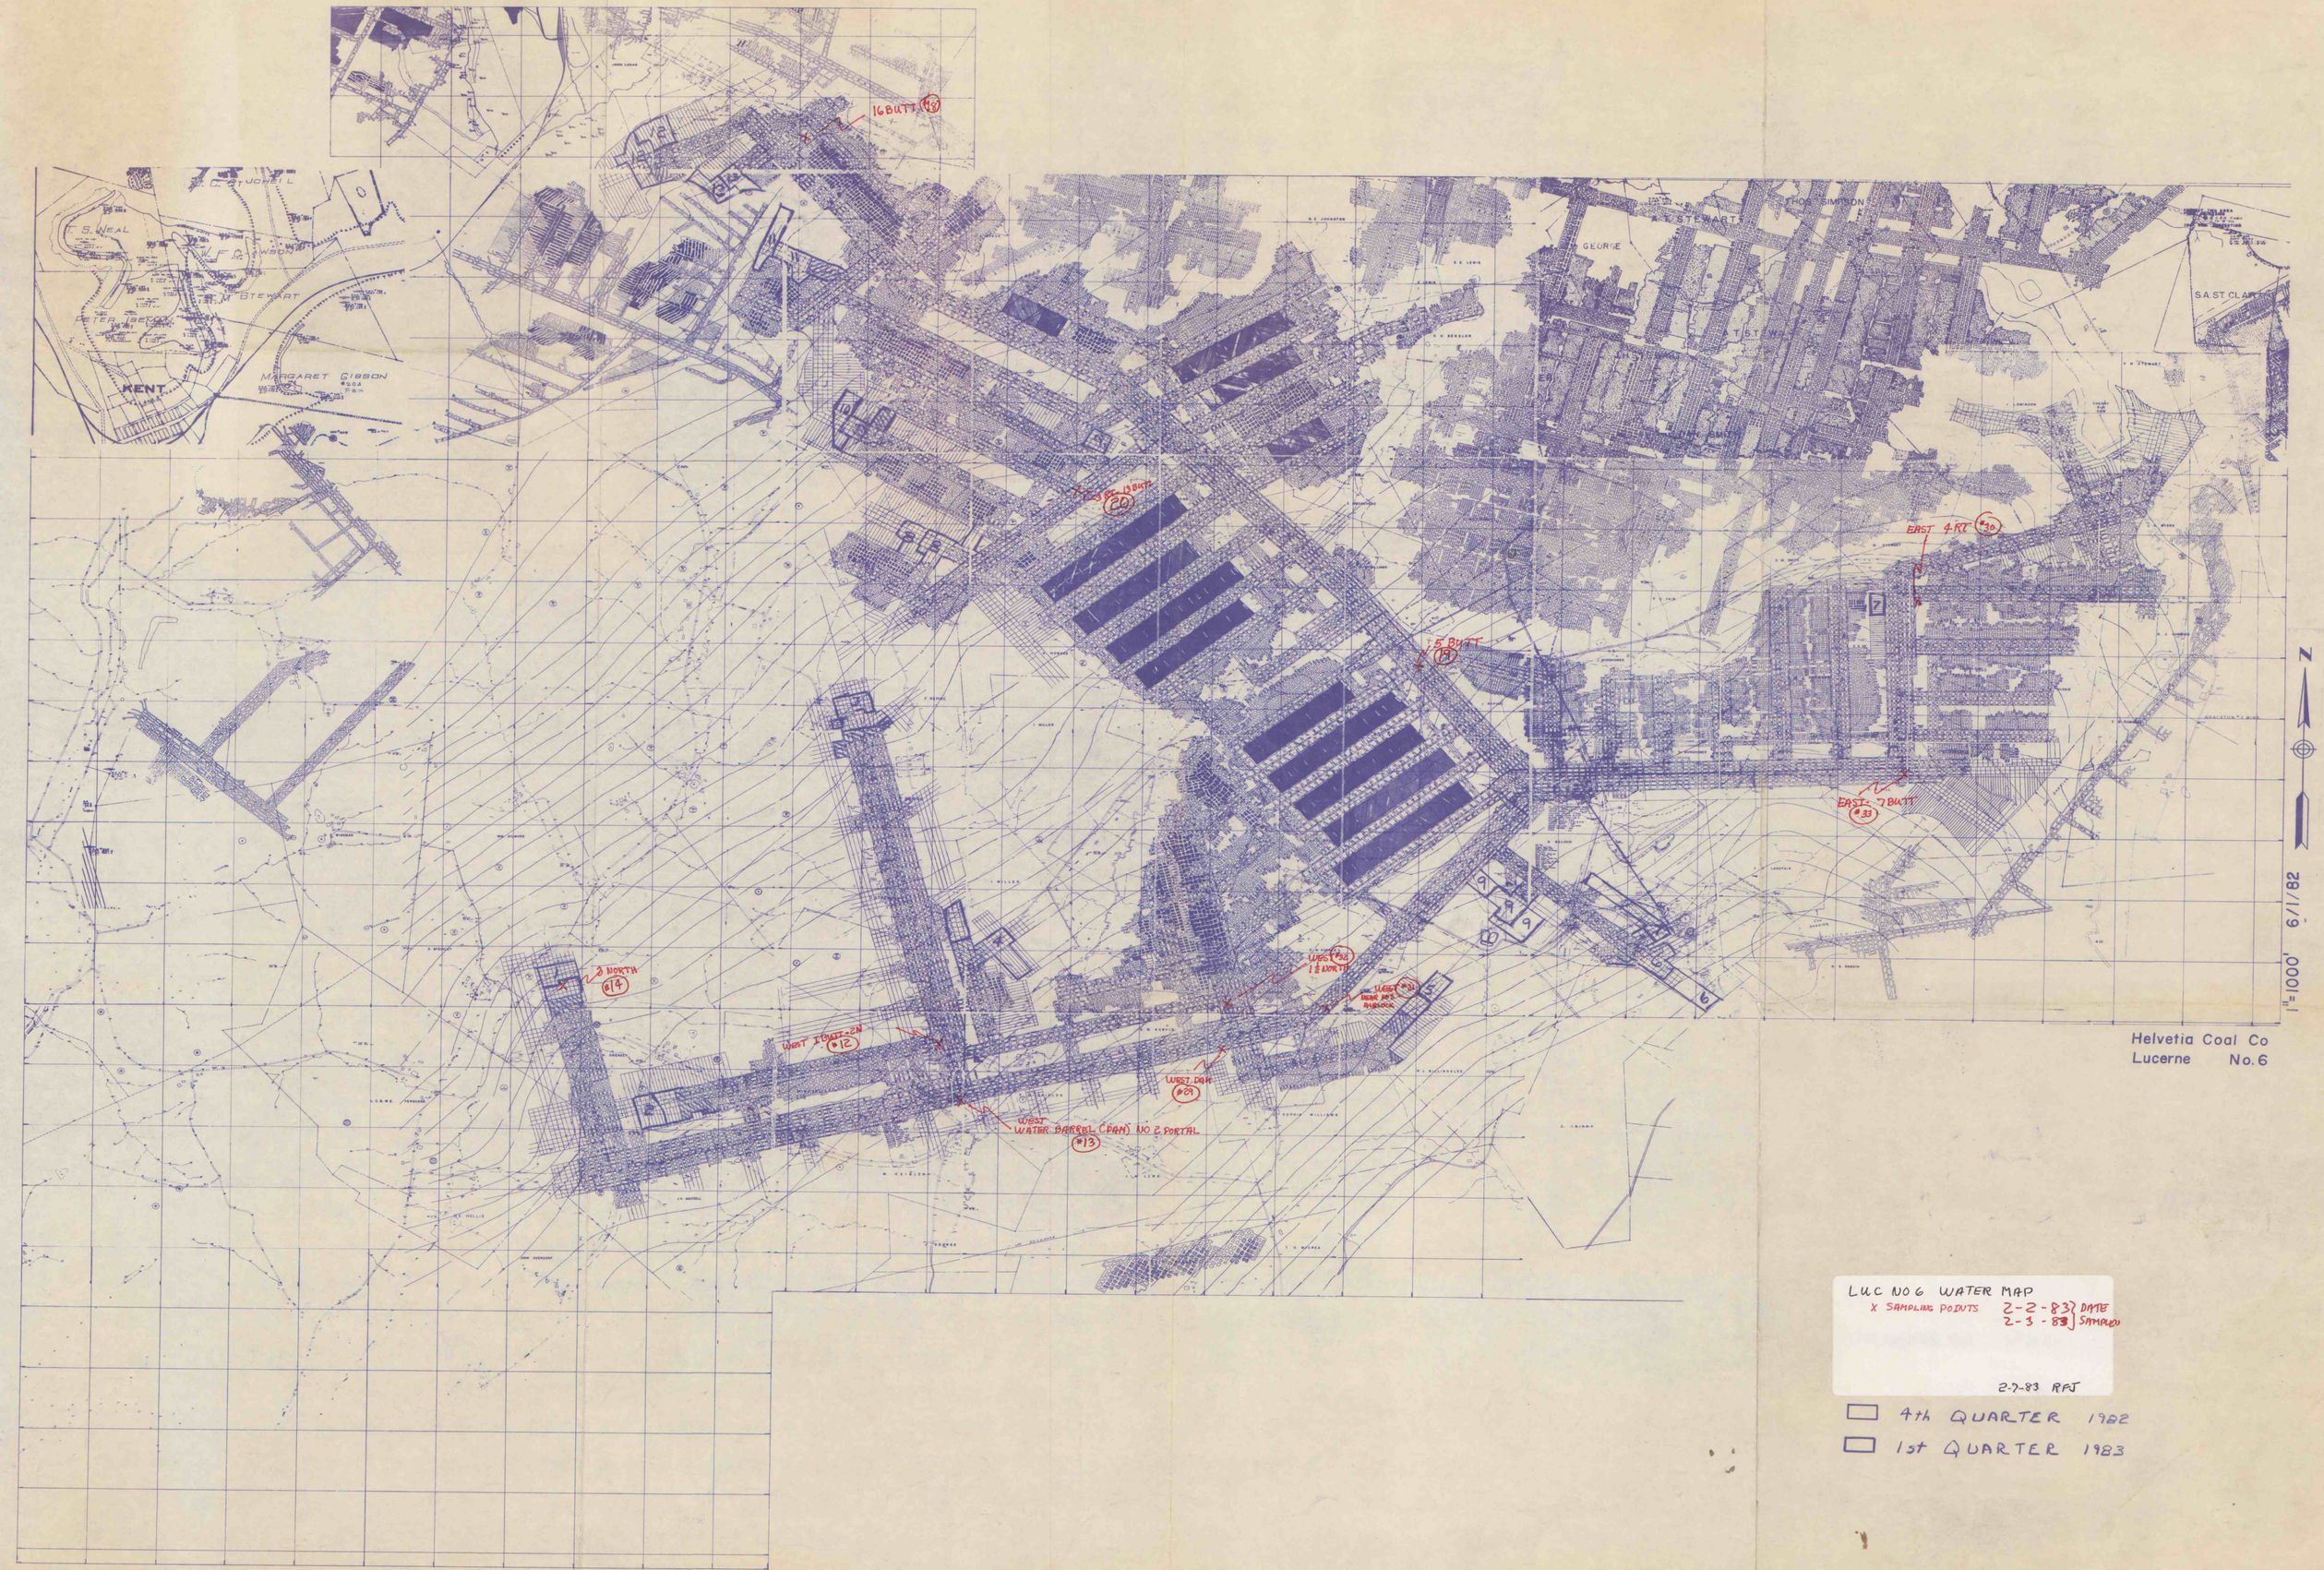
16 BUTT #18
KENT
MARGARET GIBSON
GEORGE
THOS SIMPSON
S.A. ST CLAIR
EAST 4 RT #30
EAST 7 BUTT #33
5 BUTT #19
EAST 13 BUTT #20
2 NORTH #14
WEST 1 BUTT-2N #12
WEST 1½ NORTH #32
WEST #31 MAIN AIRLOCK
WEST DAM #29
WEST WATER BARREL (DAM) NO 2 PORTAL #13
N
1"=1000'
6/1/82
Helvetia Coal Co
Lucerne No. 6
LUC NO 6 WATER MAP
X SAMPLING POINTS
2-2-83 } DATE
2-3-83 } SAMPLED
2-7-83 RFJ
4th QUARTER 1982
1st QUARTER 1983

IMAPS #15133