


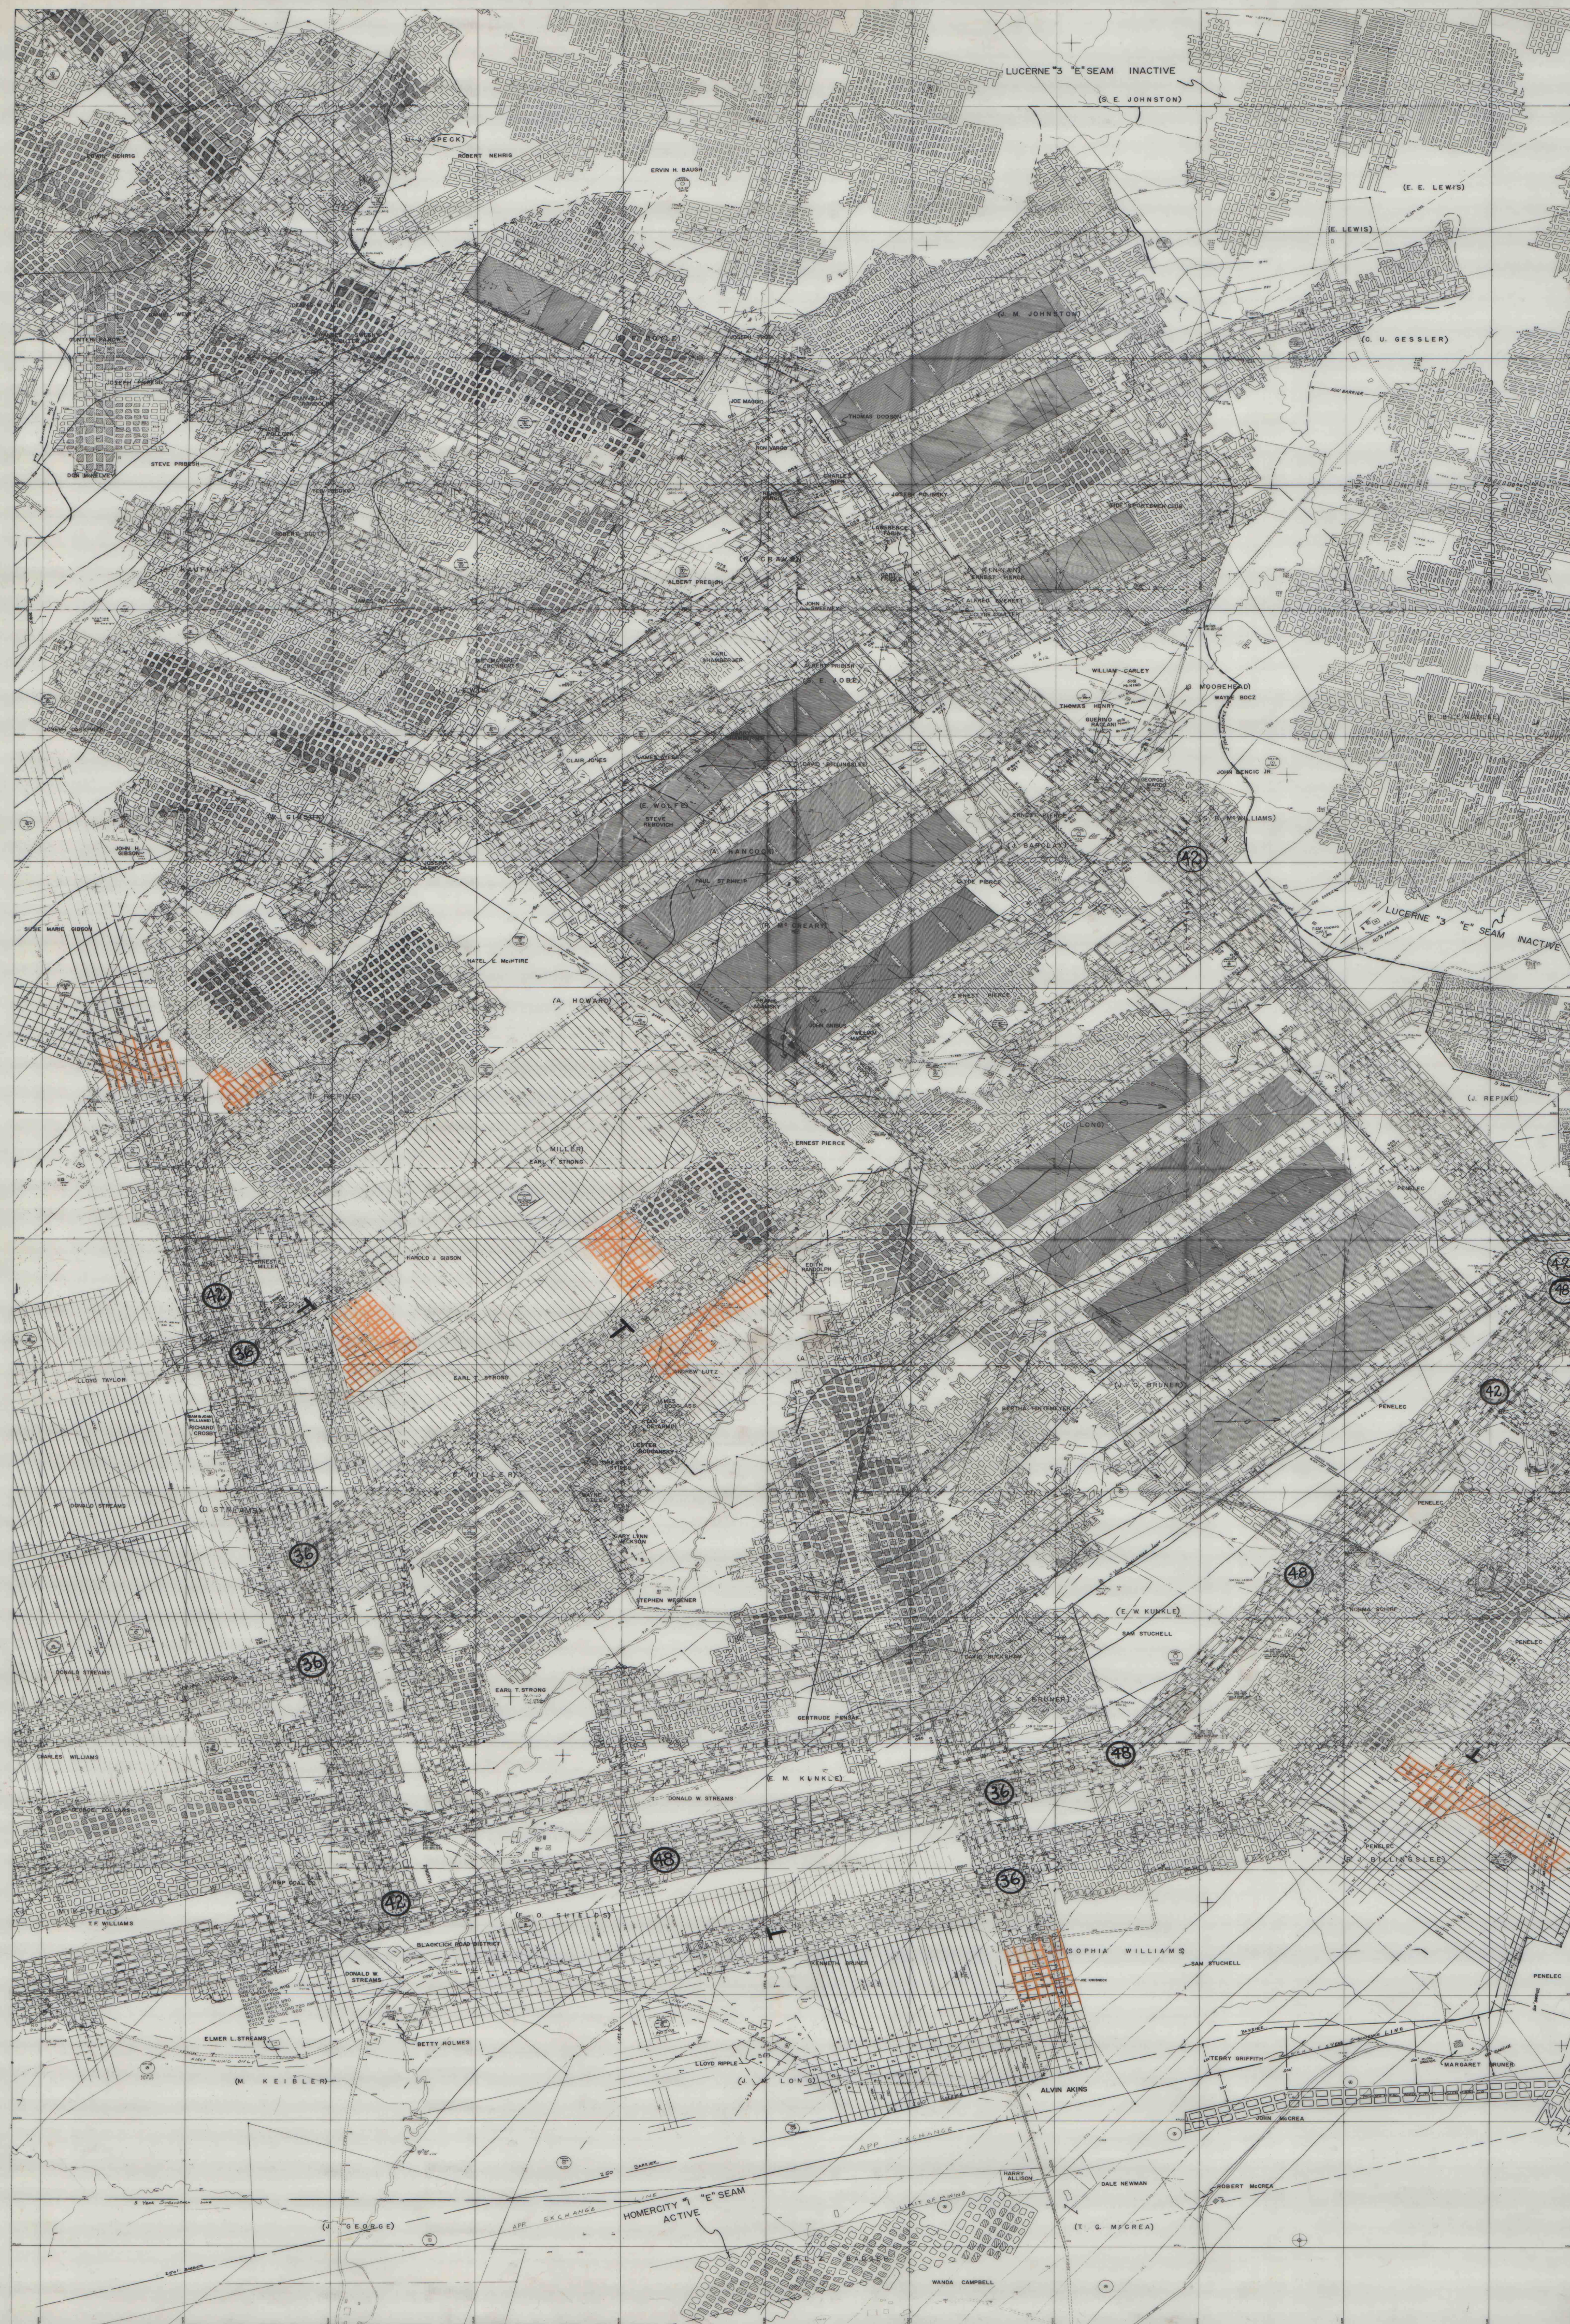

IMAPS # 15437

LUCERNE NO. 6 MINE - HELVETIA COAL CO.
BLACKLICK & CENTER TWP., INDIANA CO.
SCALE: 1"=400' DATE: 6-1-37