


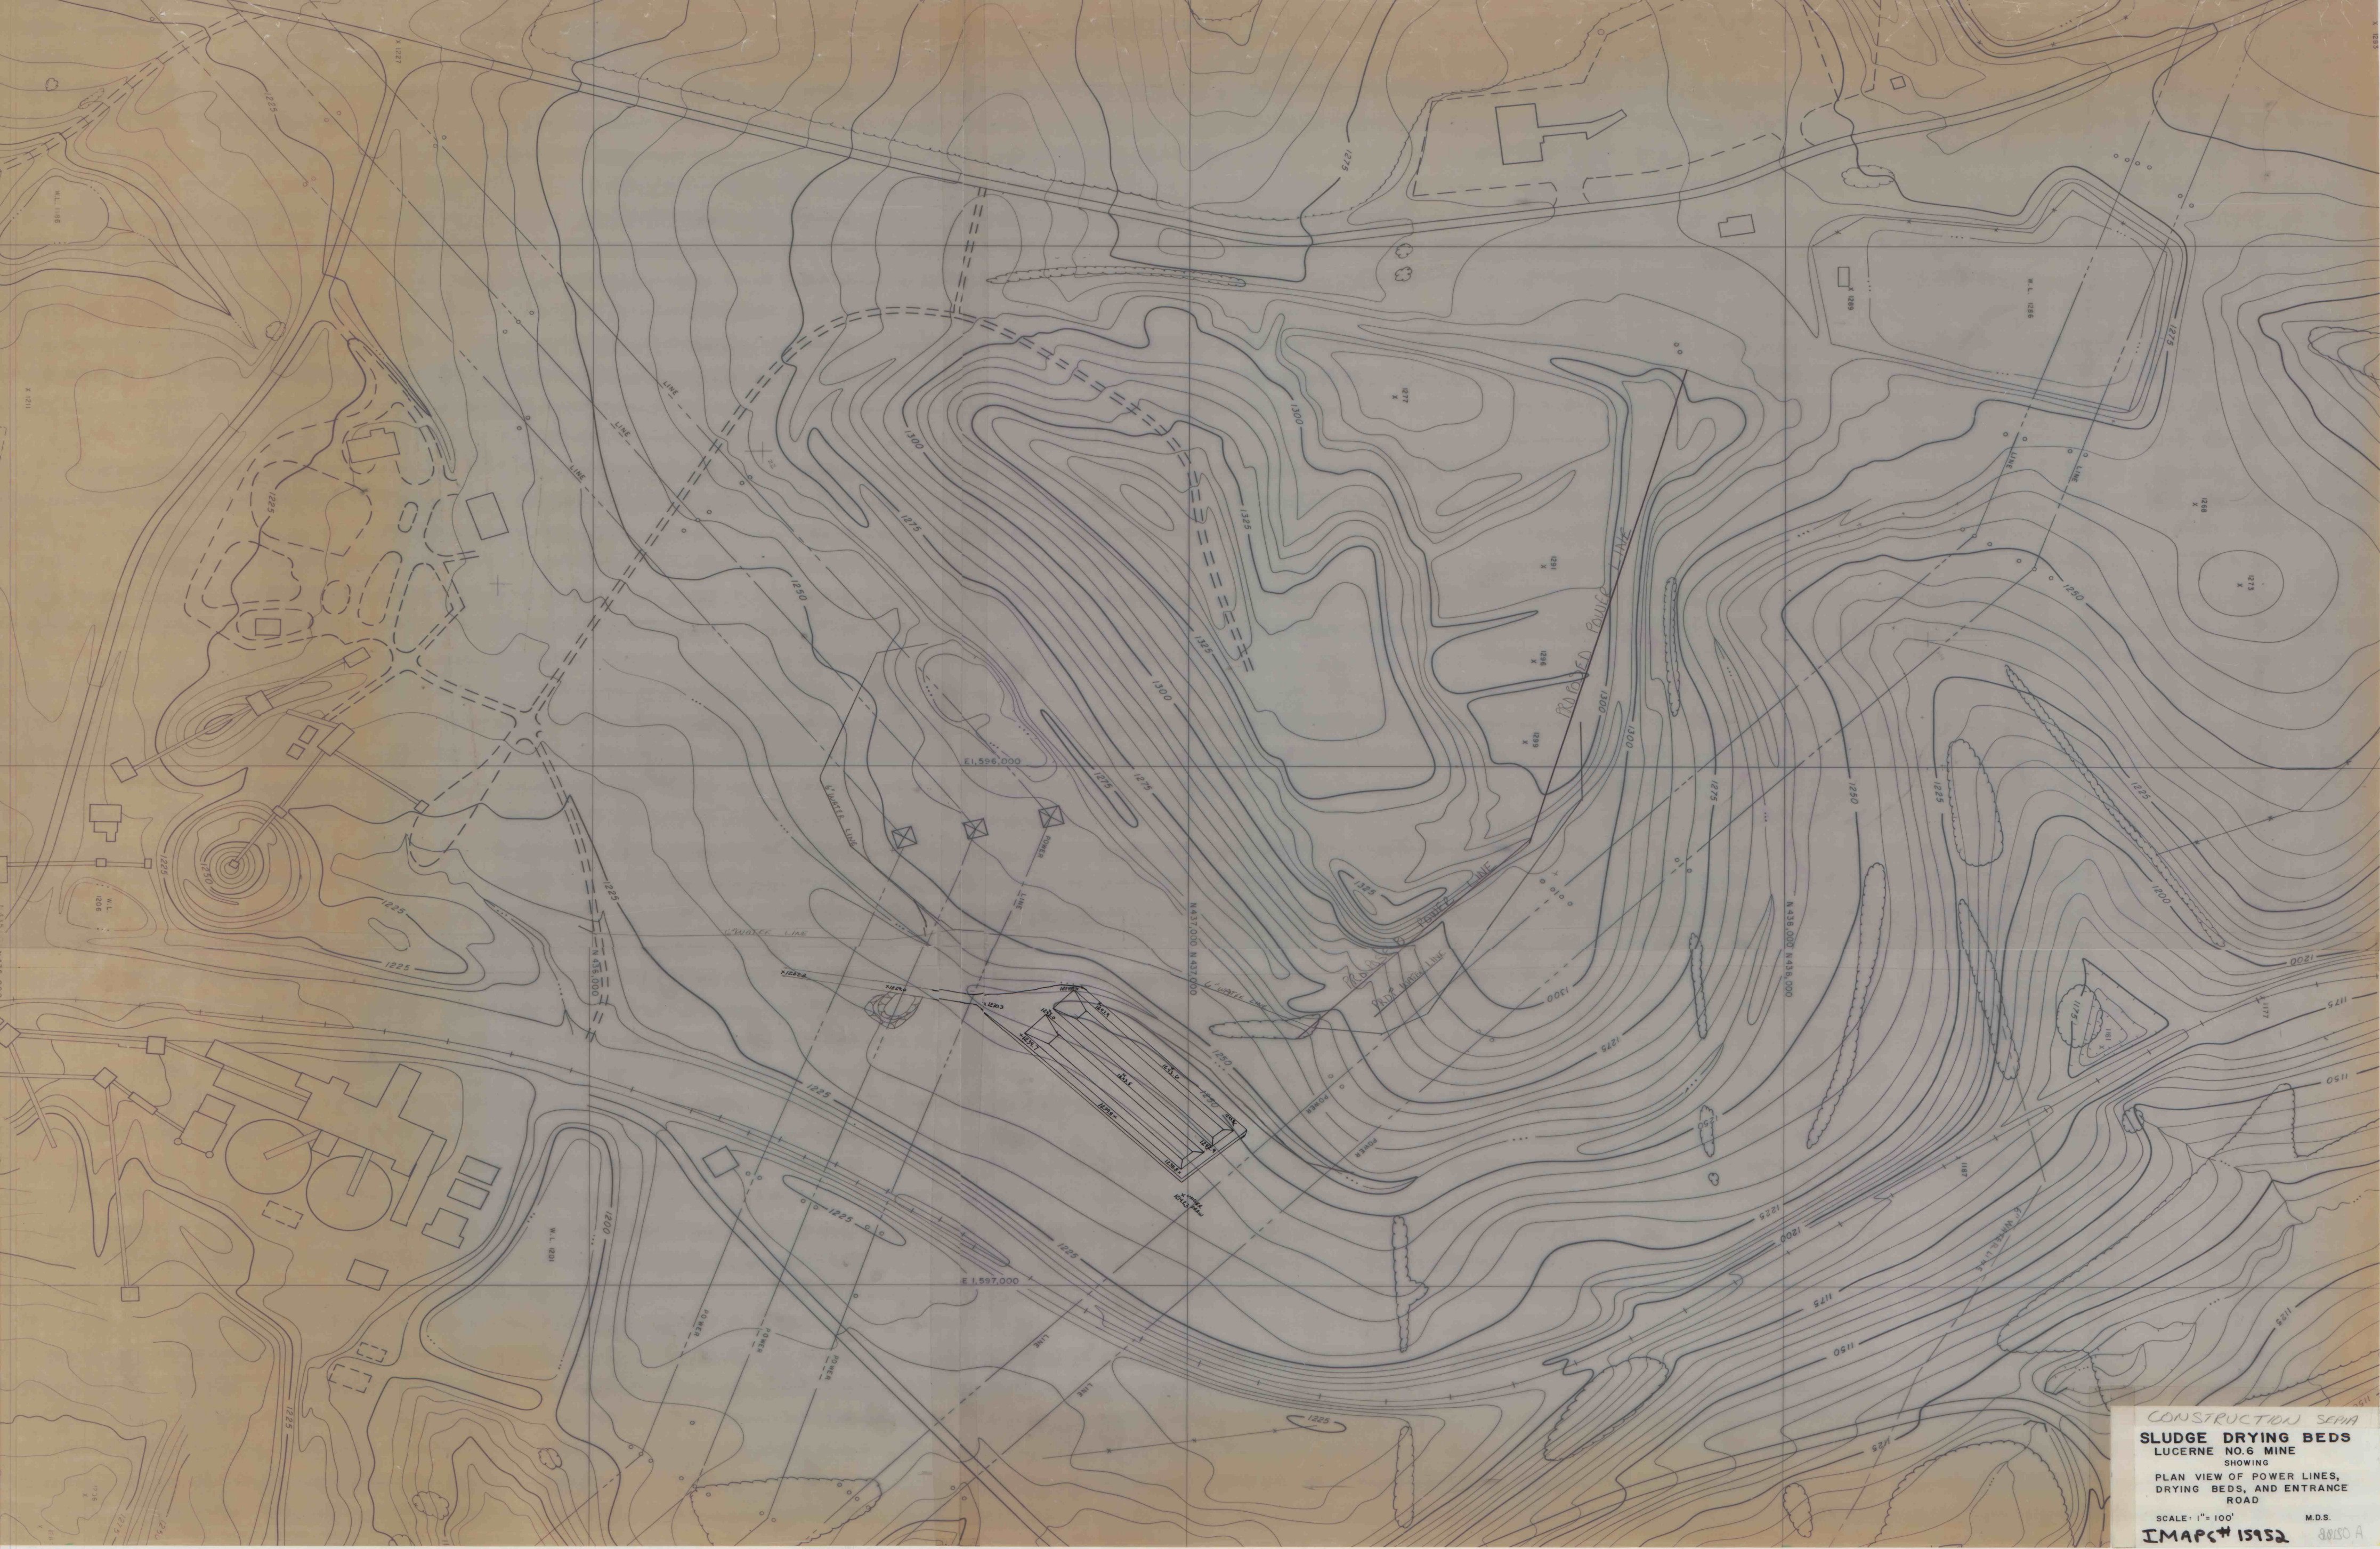

CONSTRUCTION SEPA
SLUDGE DRYING BEDS
LUCERNE NO. 6 MINE
SHOWING
PLAN VIEW OF POWER LINES,
DRYING BEDS, AND ENTRANCE
ROAD
SCALE: 1" = 100' M.D.S.
