


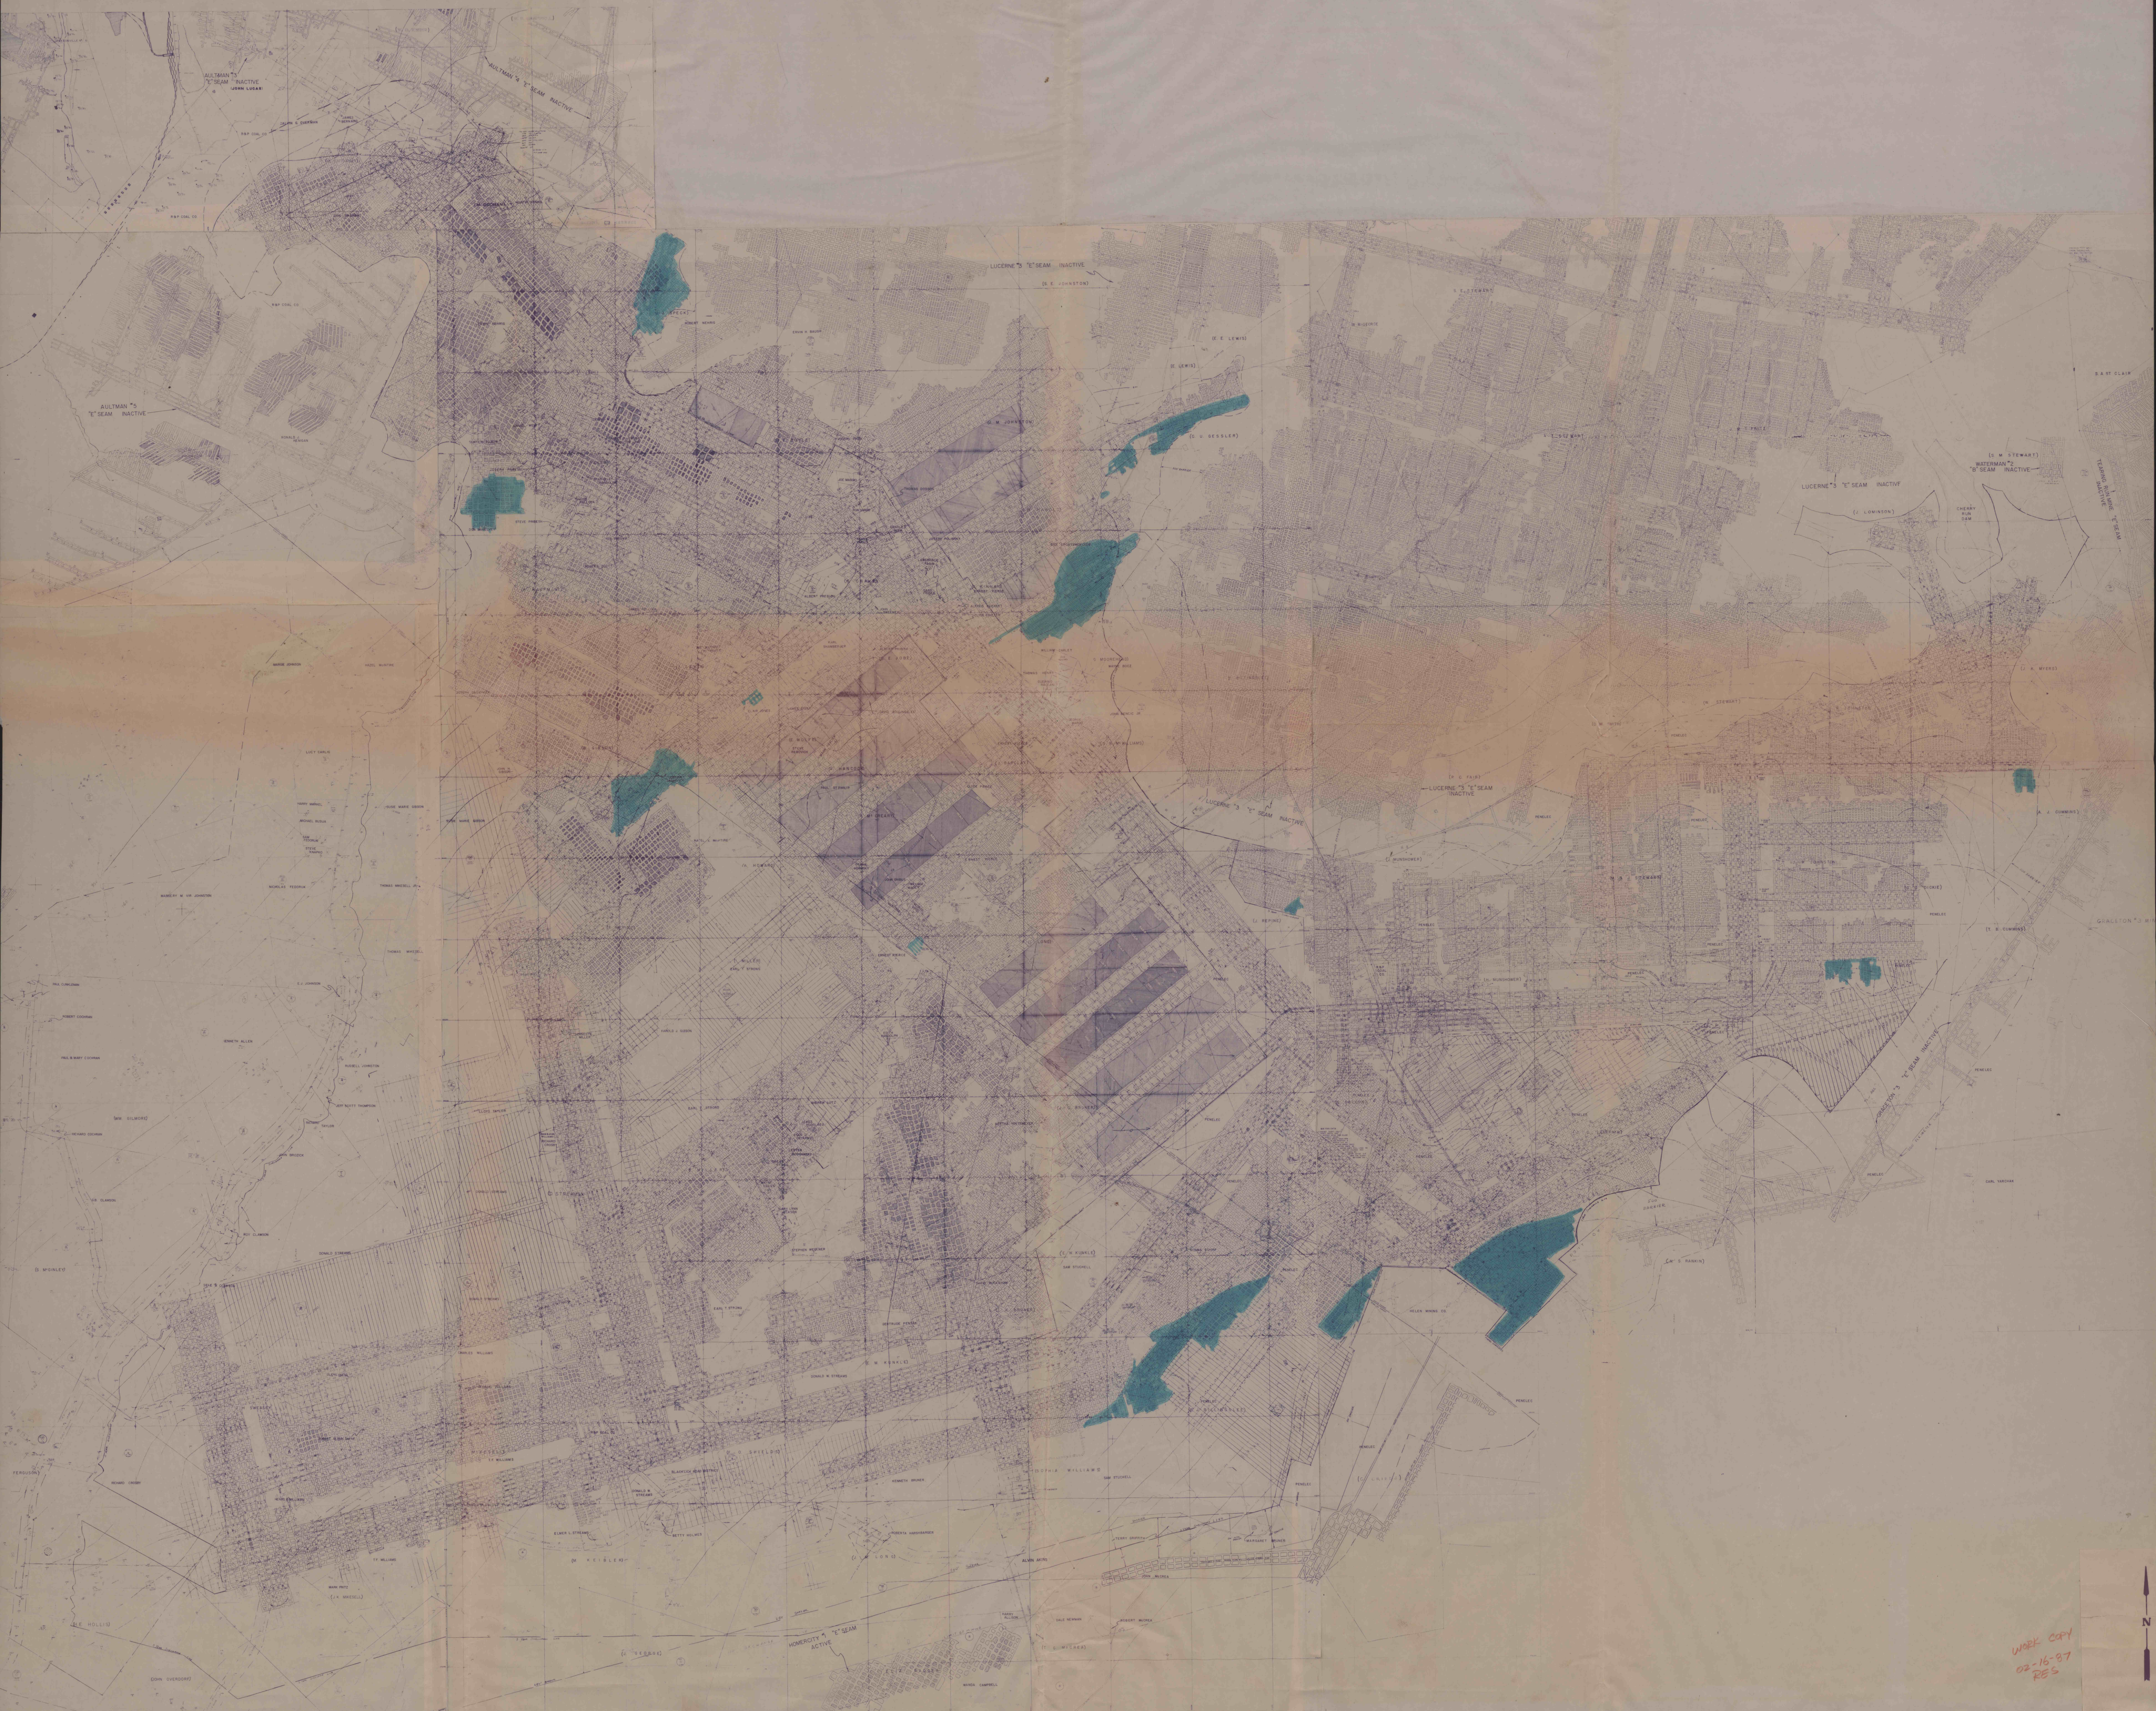

LUCERNE NO. 6 MINE - HELVETIA COAL CO.
BLACKLICK & CENTER TWP., INDIANA CO.
SCALE: 1" = 400' DATE: 12-91-86

IMAPS # 259A

WORK COPY
02-16-87
RES