


LUCERNE #8 MINE LEGEND

-  1" = 100' TRACINGS
-  HARD COPIES
-  1" = 200' TRACINGS
-  1" = 400' TRACINGS

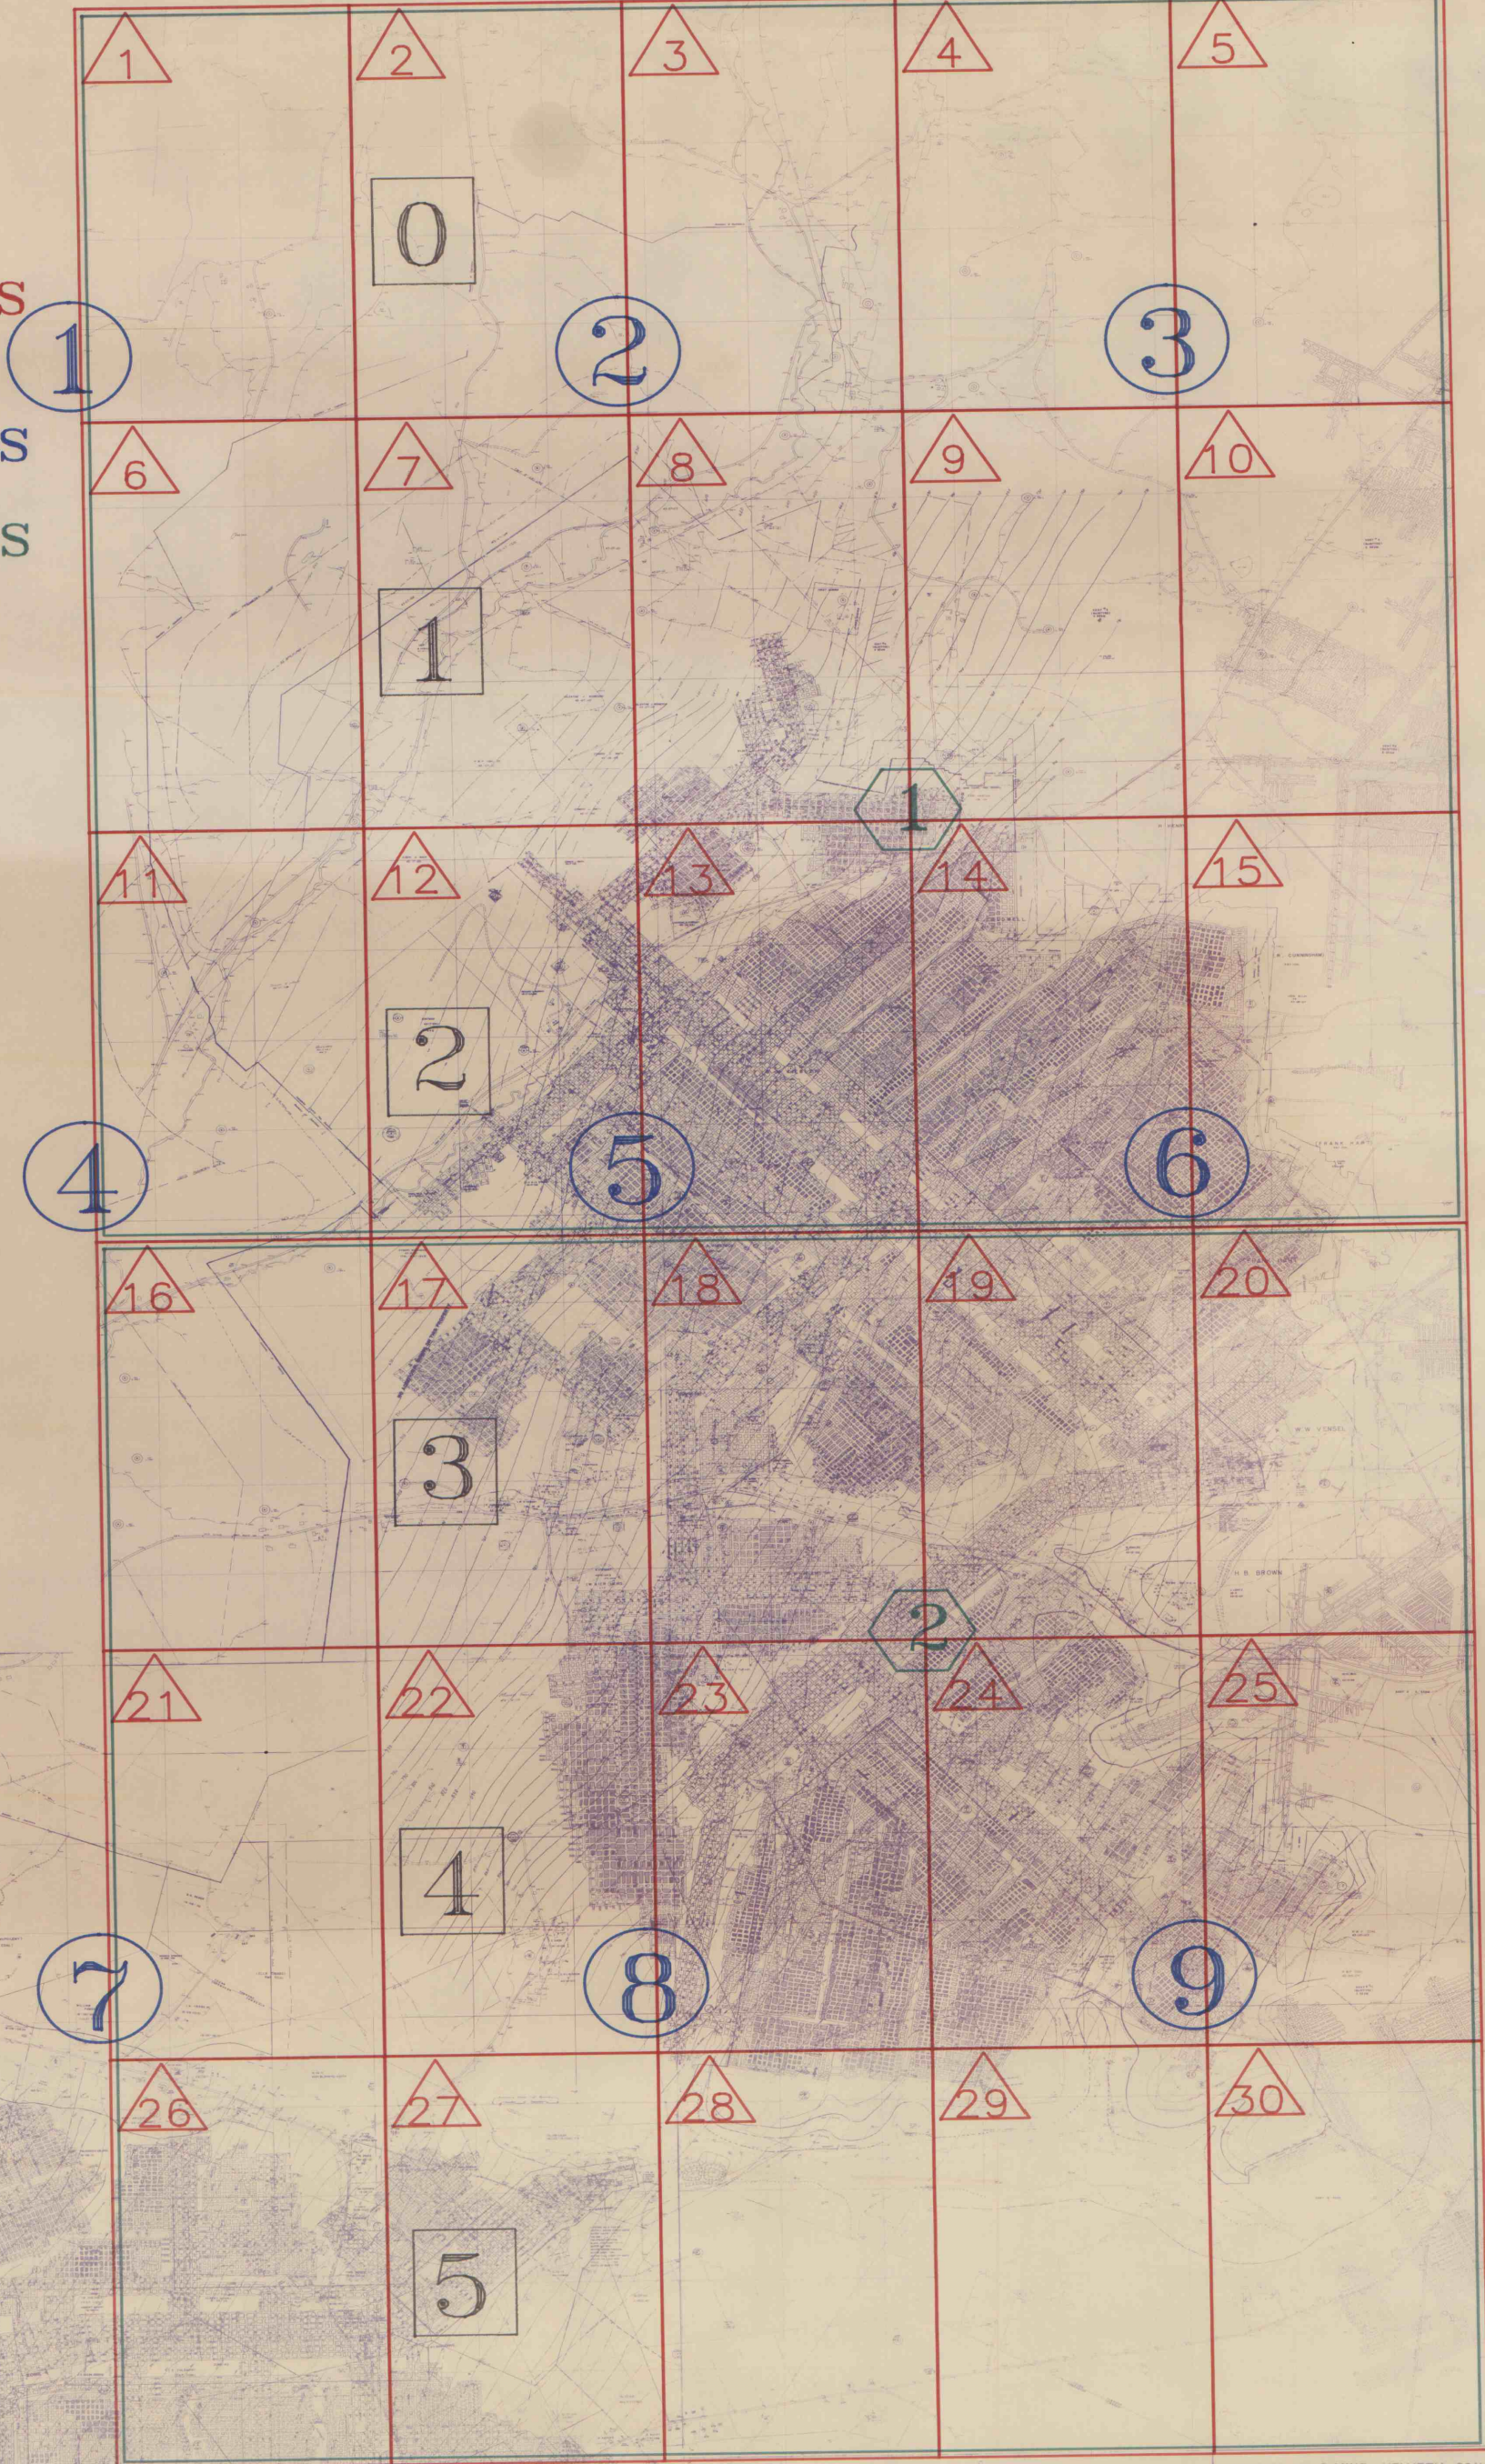

LUCERNE NO. 8 MINE - HELVETIA COAL CO.
YOUNG TWP - INDIANA CO, PA.

SCALE 1" = 1000'
FINAL MINE MAP 12-30-84

LUCERNE 9 MINE DATE 1"