


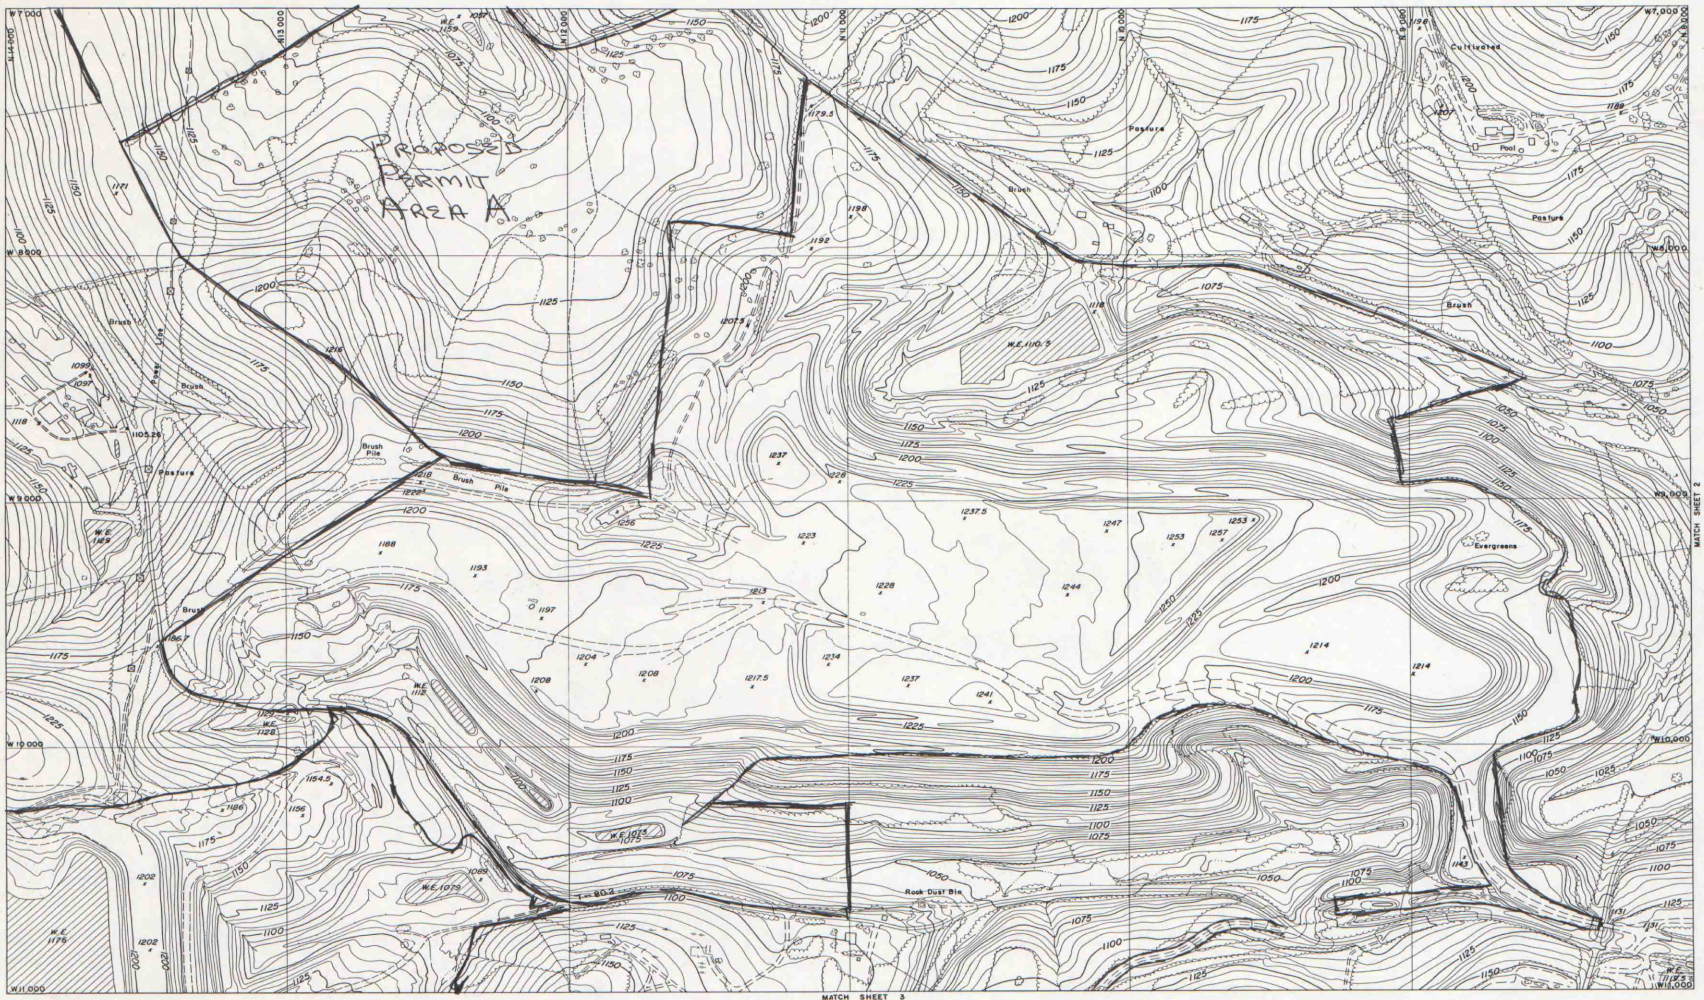

THIS MAP PREPARED BY PHOTOGRAMMETRIC METHODS USING AERIAL PHOTOGRAPHY DATED APRIL 28, 1967 BY L. ROBERT KIMBALL, CONSULTING ENGINEER, EBSBURG, PENNSYLVANIA
THIS MAP REVISED FROM AERIAL PHOTOGRAPHY DATED DECEMBER 2, 1969 & DECEMBER 14, 1970.



1	2
3	4

IMAPS# 15777

TOPOGRAPHIC MAP
OF
MINE 60 YARD AND REFUSE AREA
FOR
BETHLEHEM MINES CORPORATION
PENNSYLVANIA DIVISION
SCALE: 1" = 200' 400'
CONTOUR INTERVAL: 5'
MARCH, 1977
SHEET 1 OF 4