



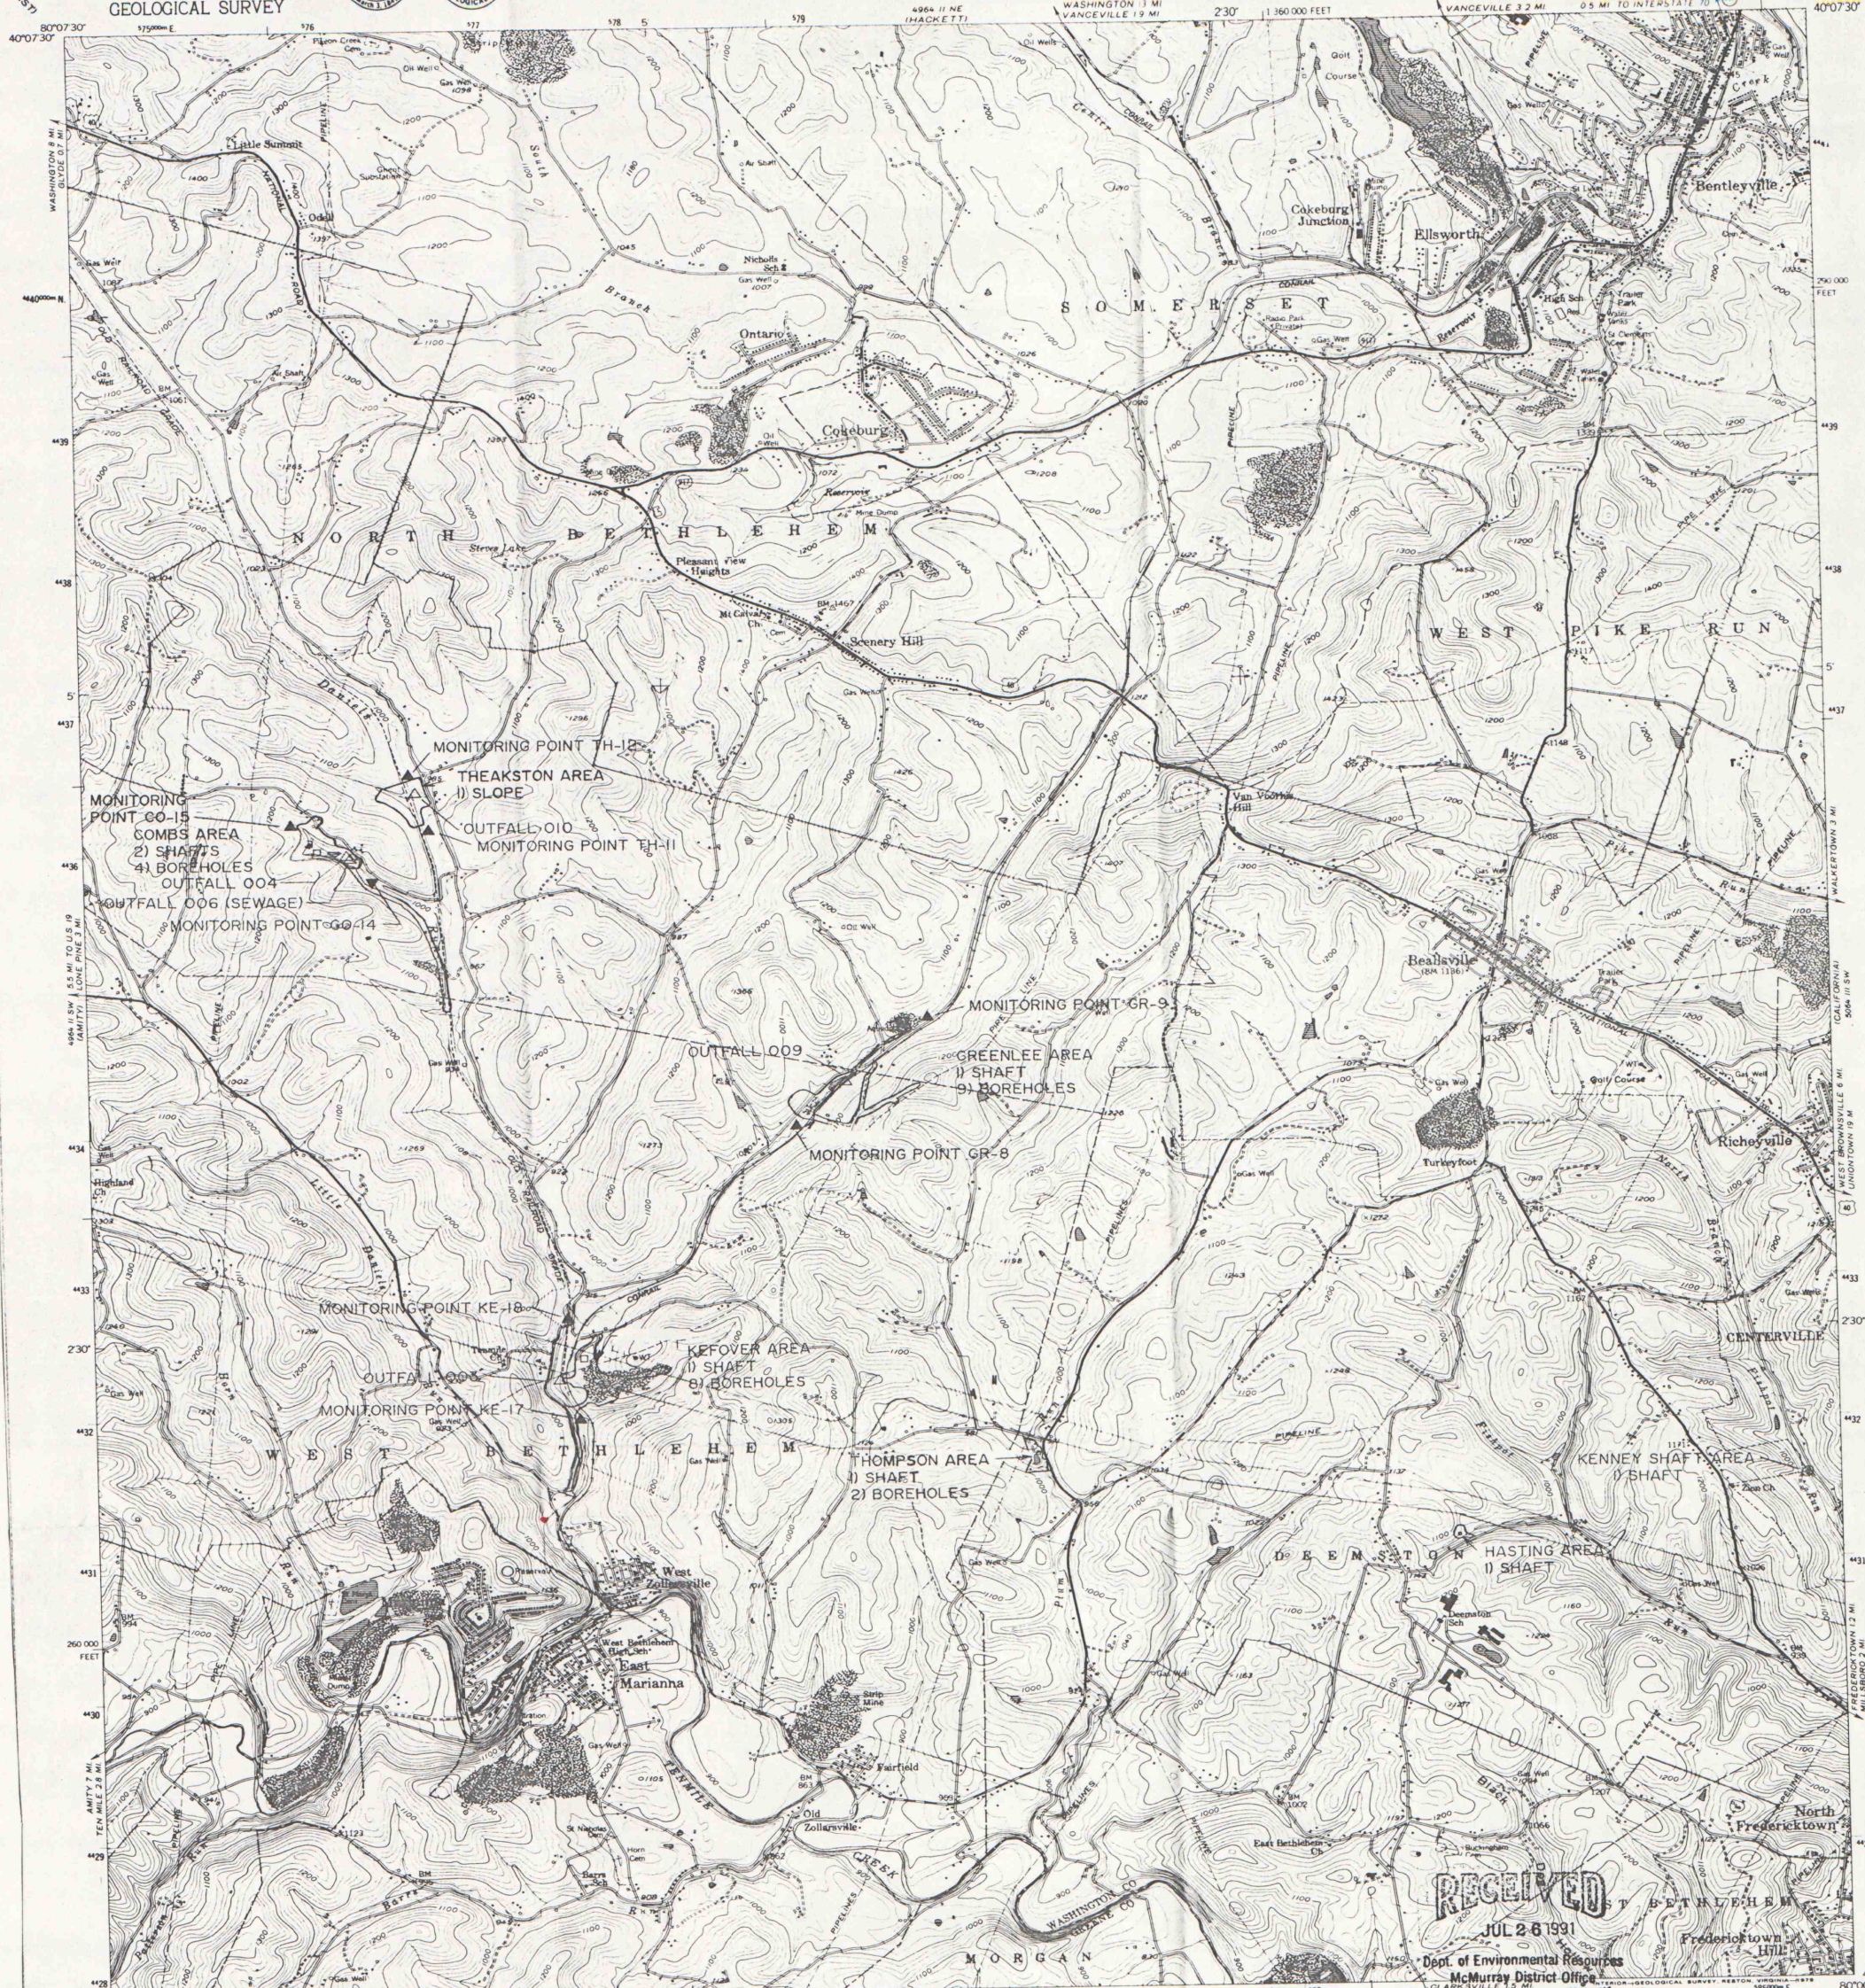

Maped, edited, and published by the Geological Survey
Control by USGS and USC&GS
Topography from aerial photographs by multiple methods
Aerial photographs taken 1952. Field check 1954
Polyconic projection. 1927 North American datum
10,000-foot grid based on Pennsylvania coordinate system, south zone
1000-meter Universal Transverse Mercator grid ticks, zone 17,
shown in blue
Revisions shown in purple compiled in cooperation with State of
Pennsylvania agencies from aerial photographs taken 1977 and other
source data. This information not field checked. Map edited 1979

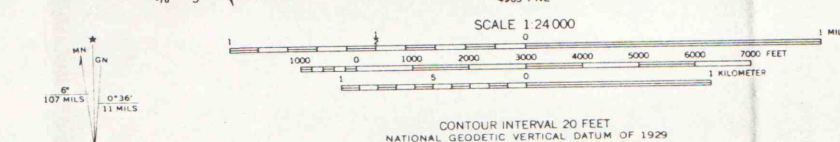

RECEIVED
JUL 28 1991
Dept. of Environmental Resources
McMurray District Office

ROAD CLASSIFICATION
Heavy-duty Light-duty
Medium-duty Unimproved dirt
State Route
ELLSWORTH, PA.
1:4000-W8000/7.5
1954
PHOTOREVISED 1979
AMS 4964 II SE-SERIES V831

VESTA MINING COMPANY
VESTA MINE
SITES ASSOCIATED WITH VESTA MINE
MAP INCLUDES SHAFTS, BOREHOLES,
OUTFALLS AND MONITORING POINTS
SCALE: 1"=2000' DATE: JUNE 25, 1991

DRAWING No. **A-4407 SH. 2**