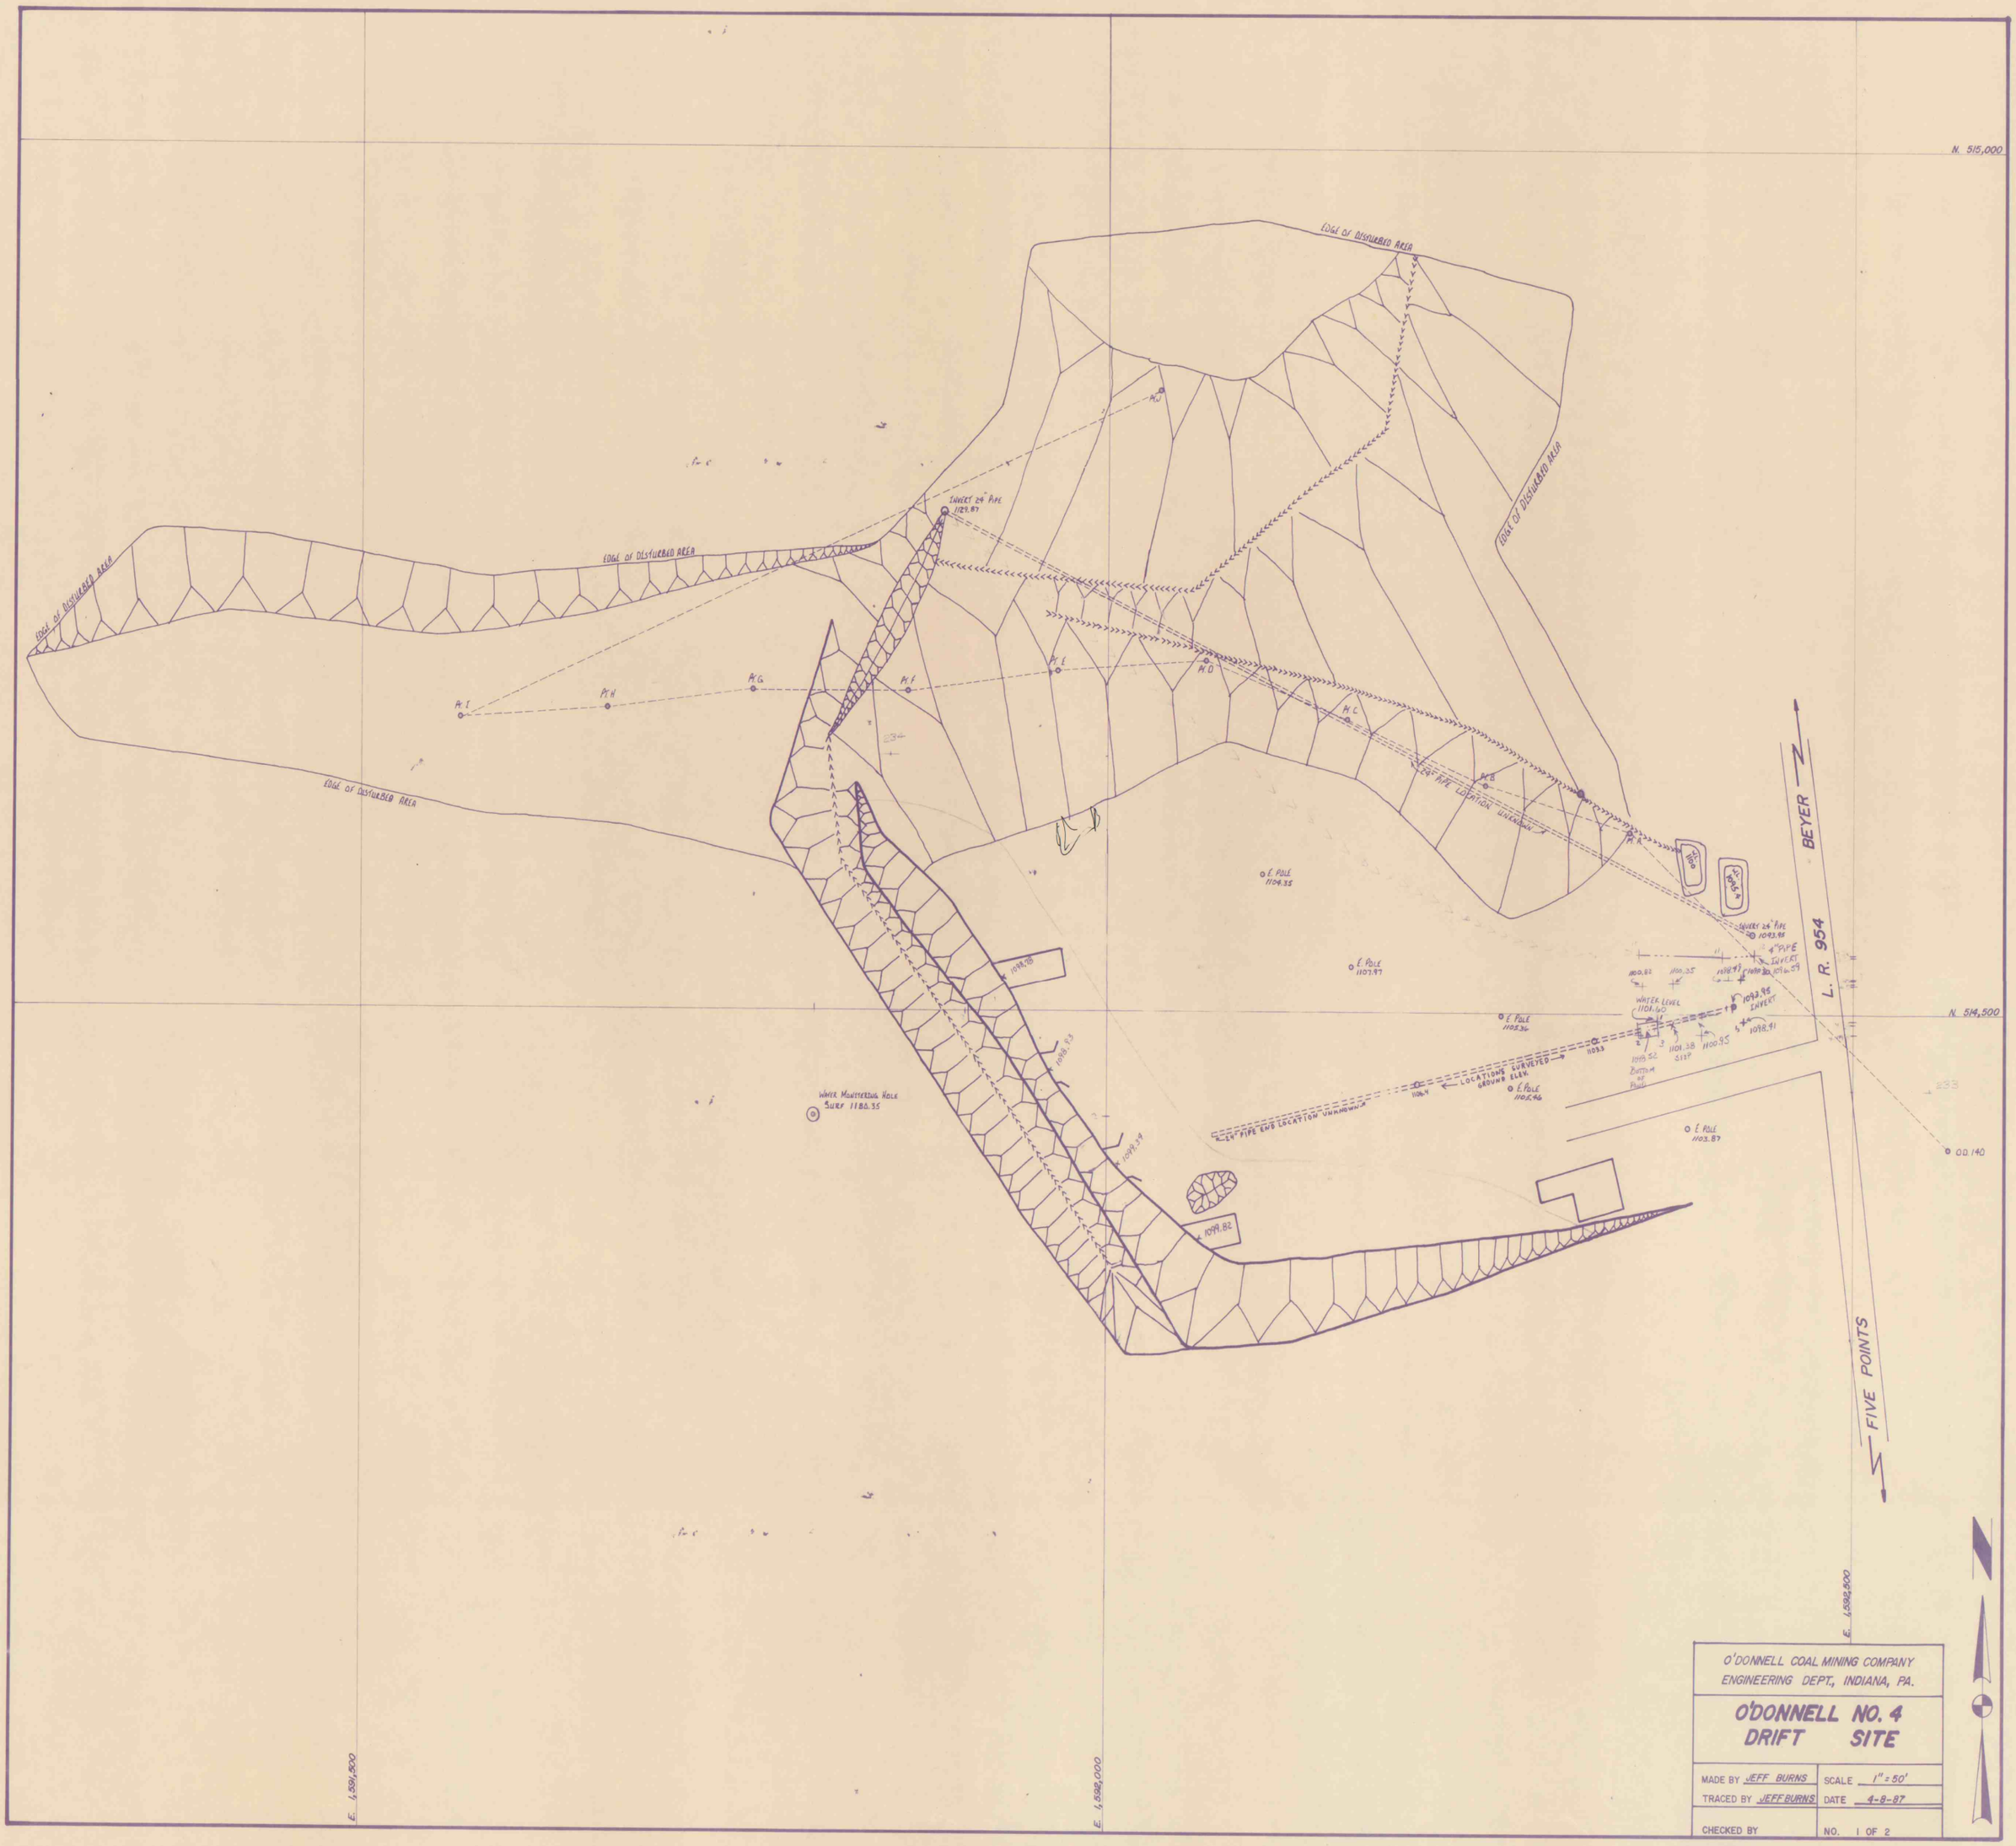

O'DONNELL COAL MINING COMPANY
ENGINEERING DEPT., INDIANA, PA.

O'DONNELL NO. 4 DRIFT SITE

MADE BY JEFF BURNS	SCALE 1" = 50'
TRACED BY JEFF BURNS	DATE 4-8-87
CHECKED BY	NO. 1 OF 2

IMAPS # 16021