


0.10

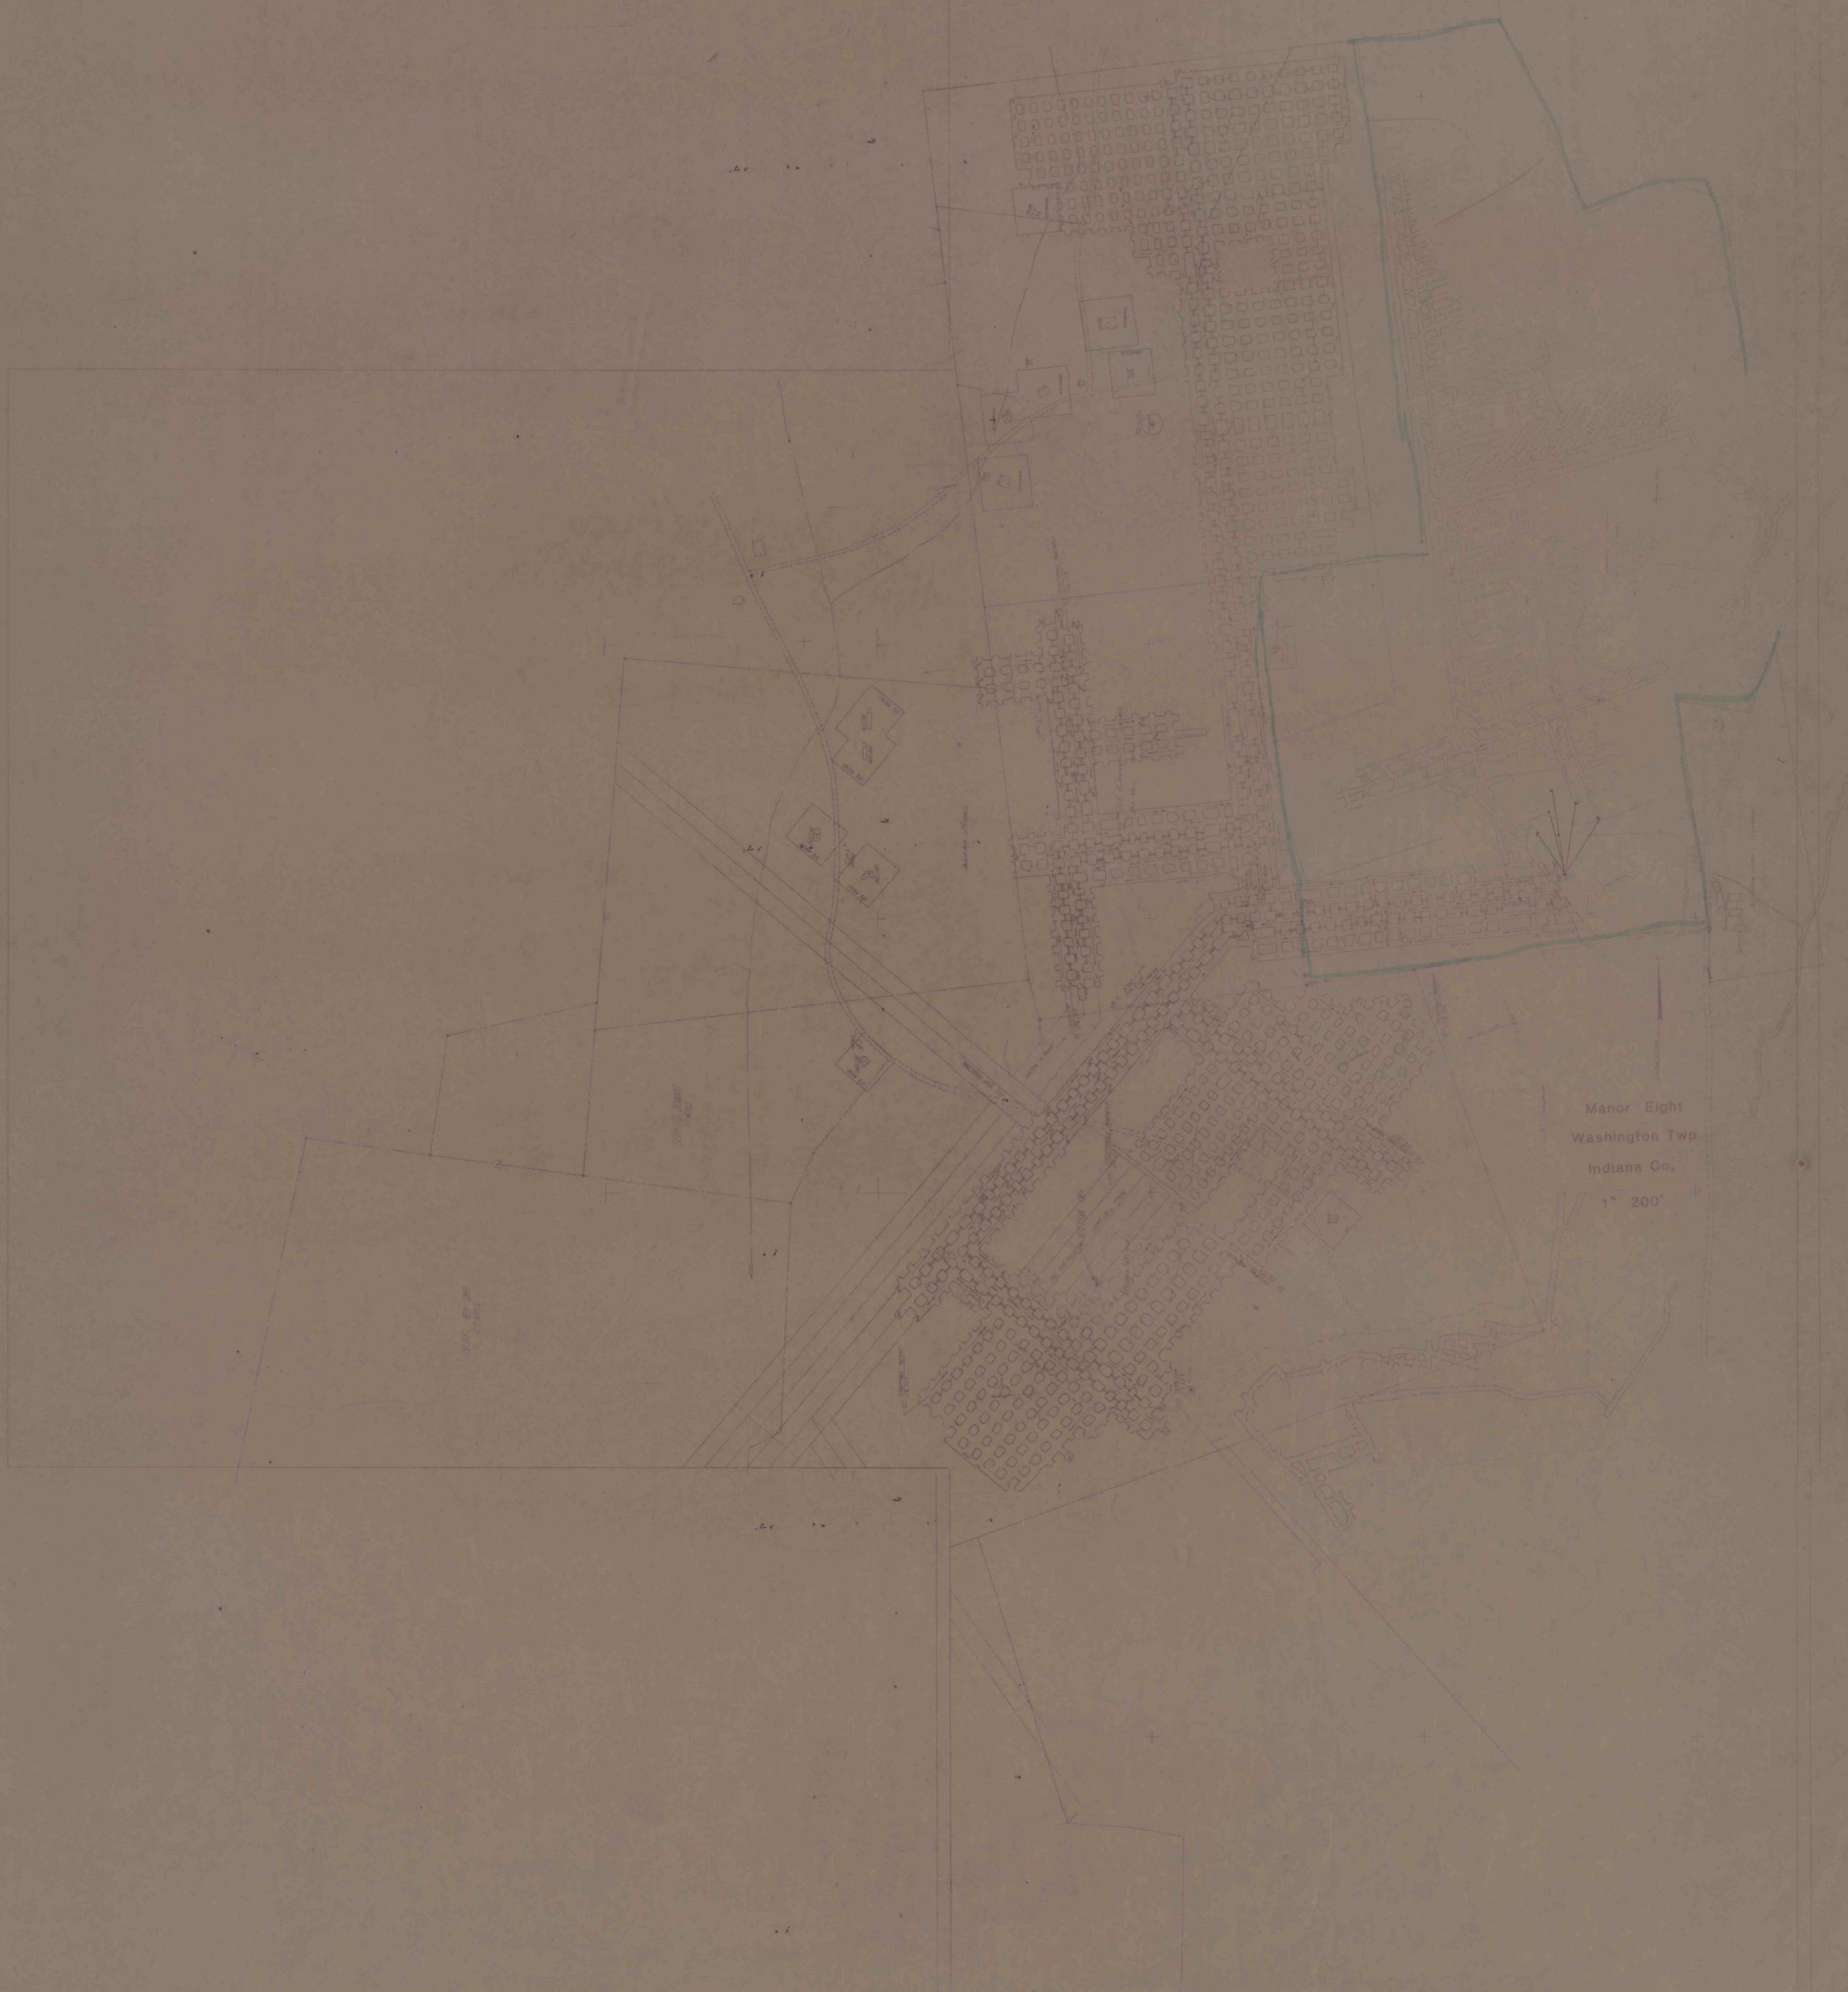

Manor Eight
Washington Twp
Indiana Co.
1" = 200'