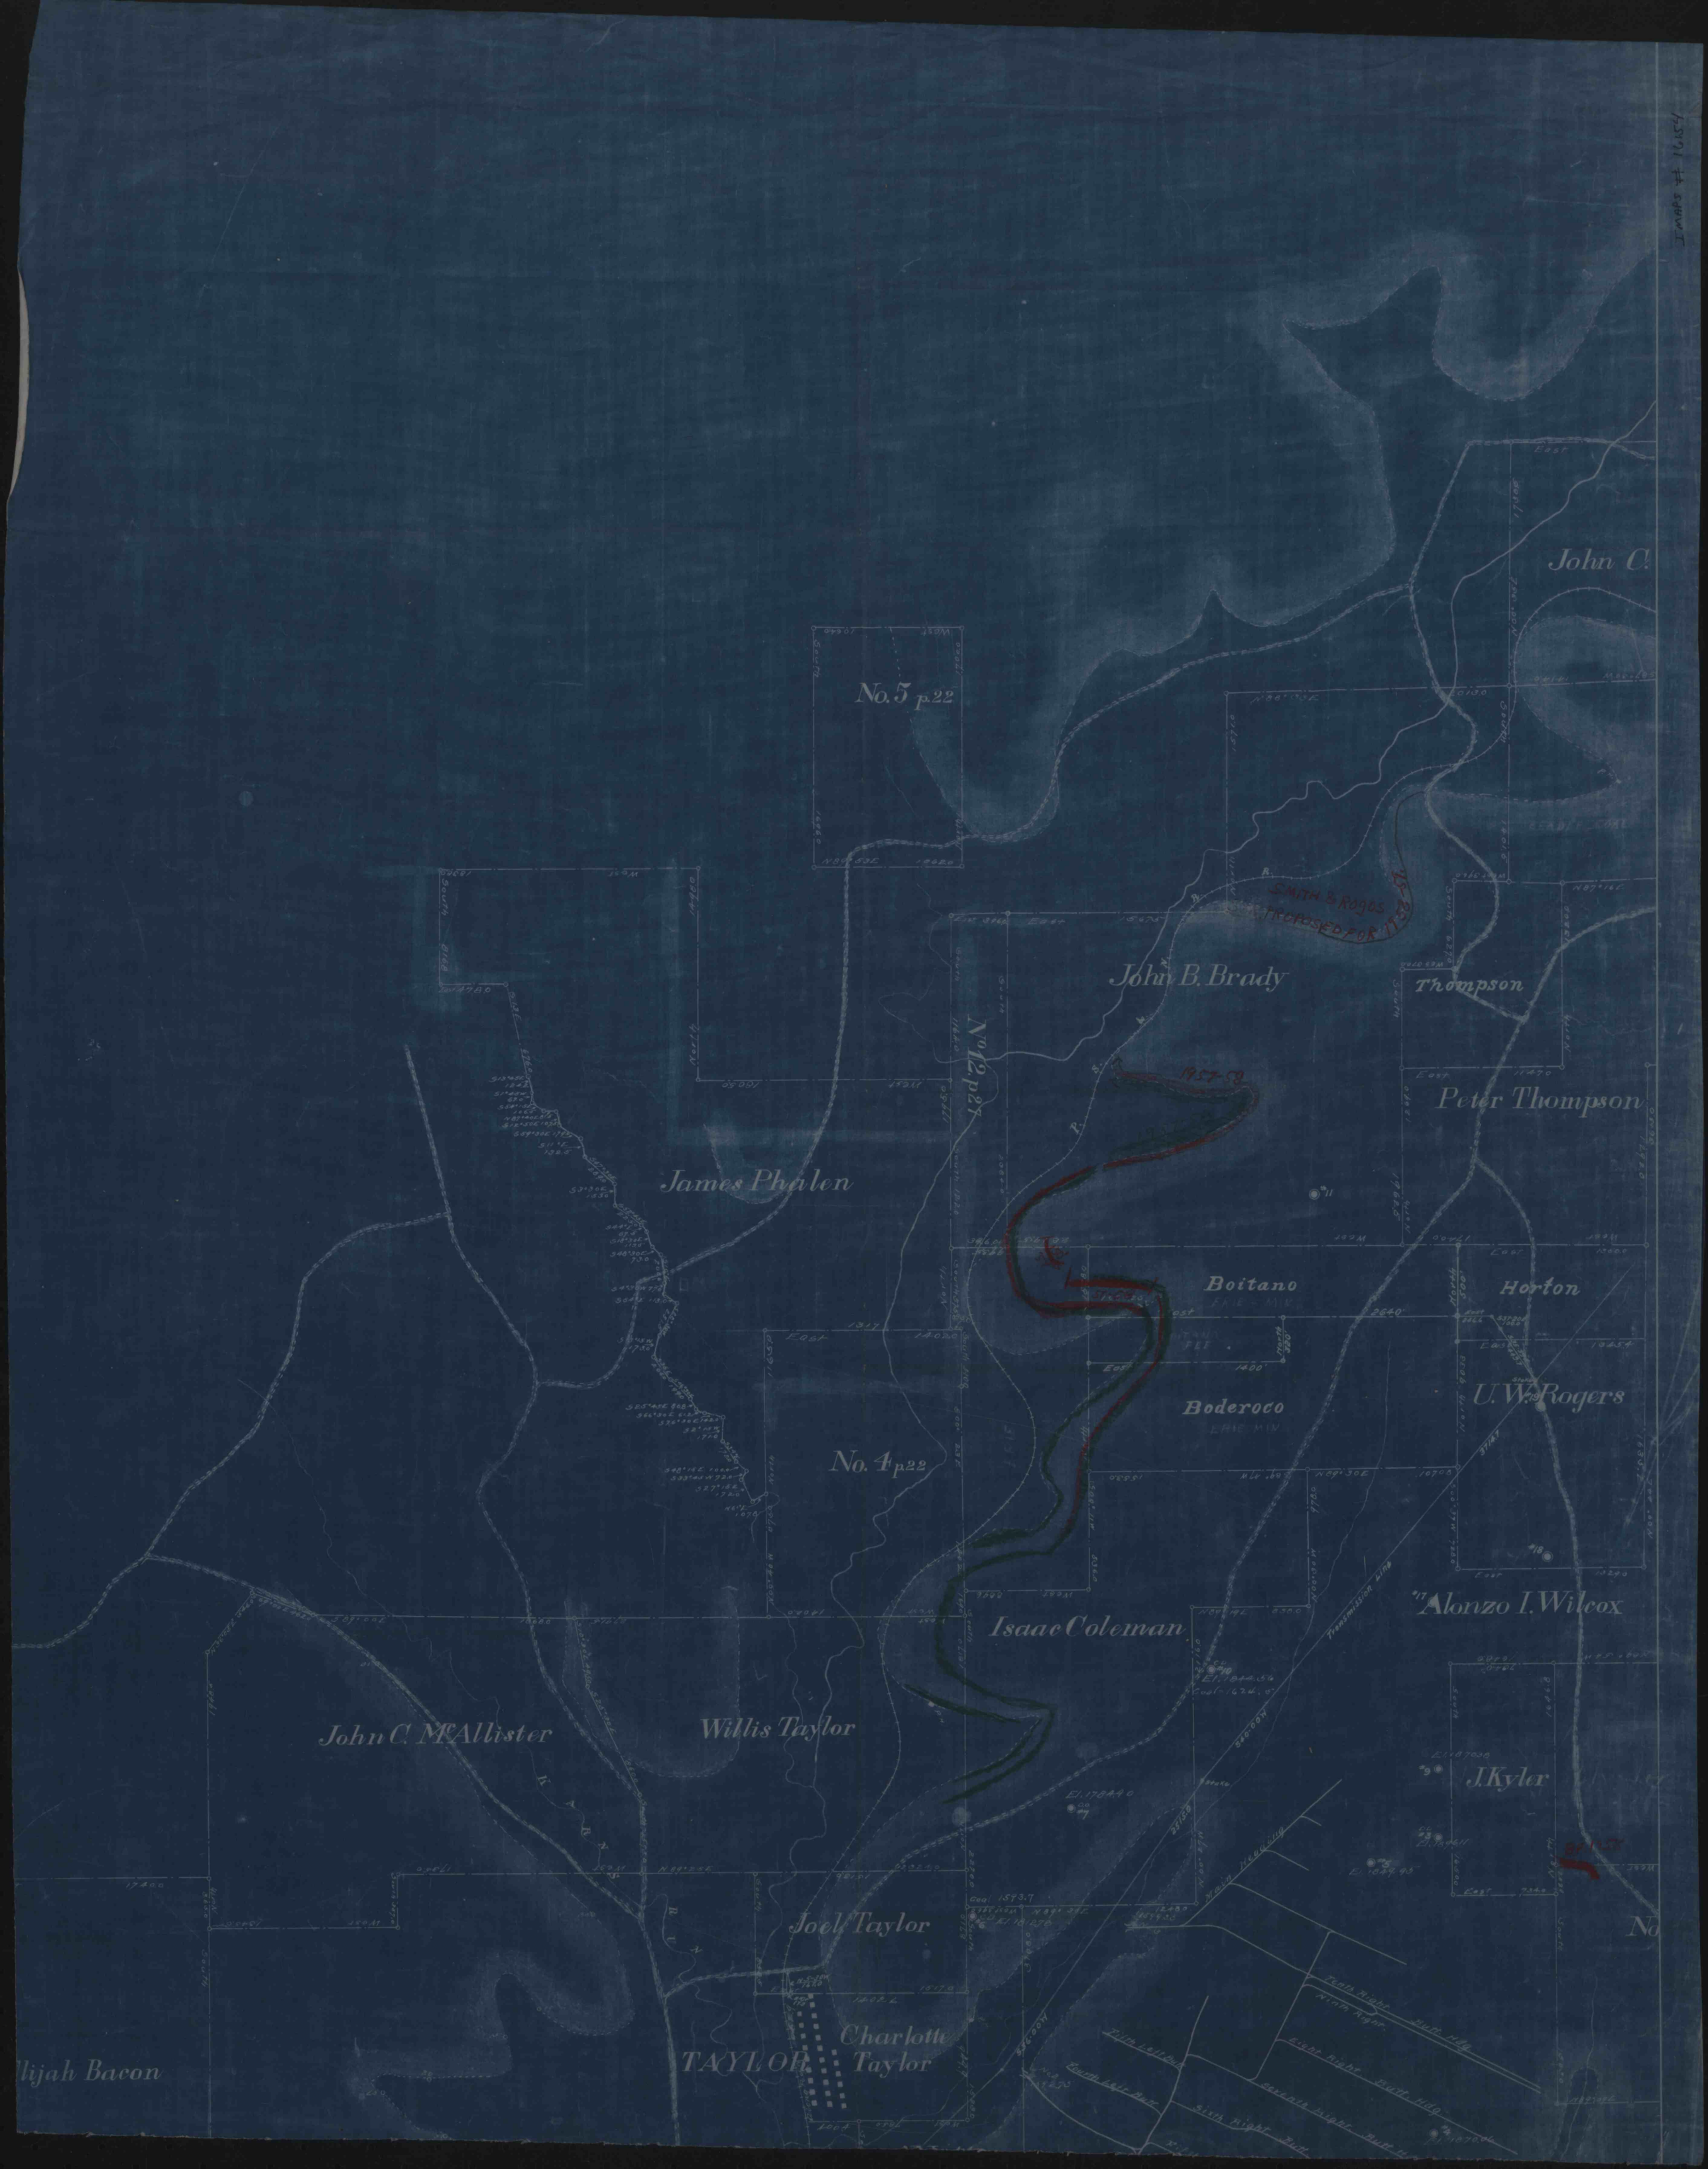
Imaps # 16154
John C.
No. 5 p.22
John B. Brady
Thompson
Peter Thompson
No. 12 p.21
James Phalen
Boitano
Horton
Boderoco
U. W. Rogers
No. 4 p.22
Isaac Coleman
Alonzo I. Wilcox
John C. McAllister
Willis Taylor
J. Kyler
Joel Taylor
Charlotte Taylor
TAYLOR
Elijah Bacon
Transmission Line
Main Heading
Tenth Right Butt Hdg.
Ninth Right
Eight Right Butt Hdg.
Seventh Right Butt Hdg.
Sixth Right Butt
Fifth Left Butt
Fourth Left Butt