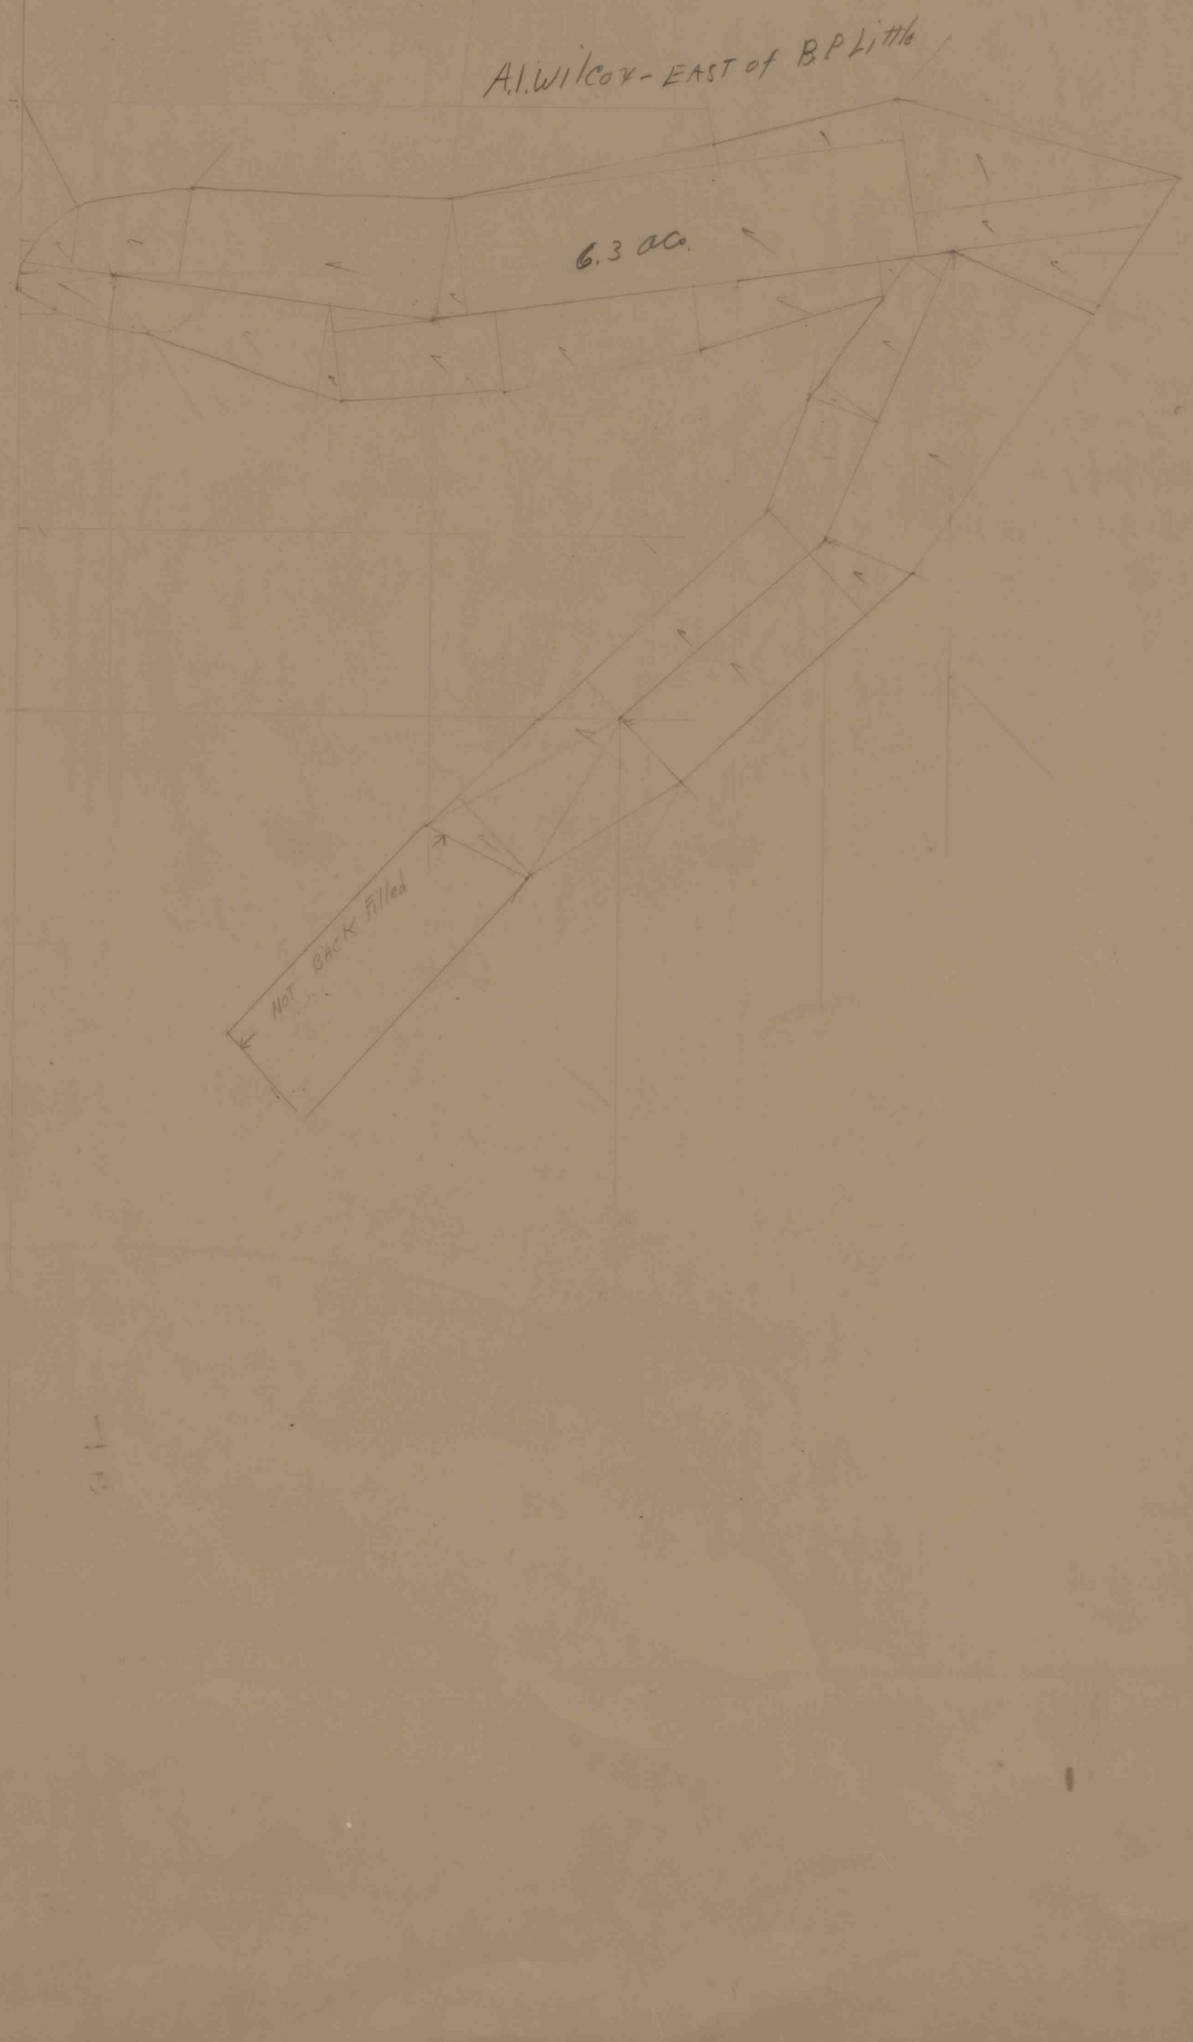P. No 9.