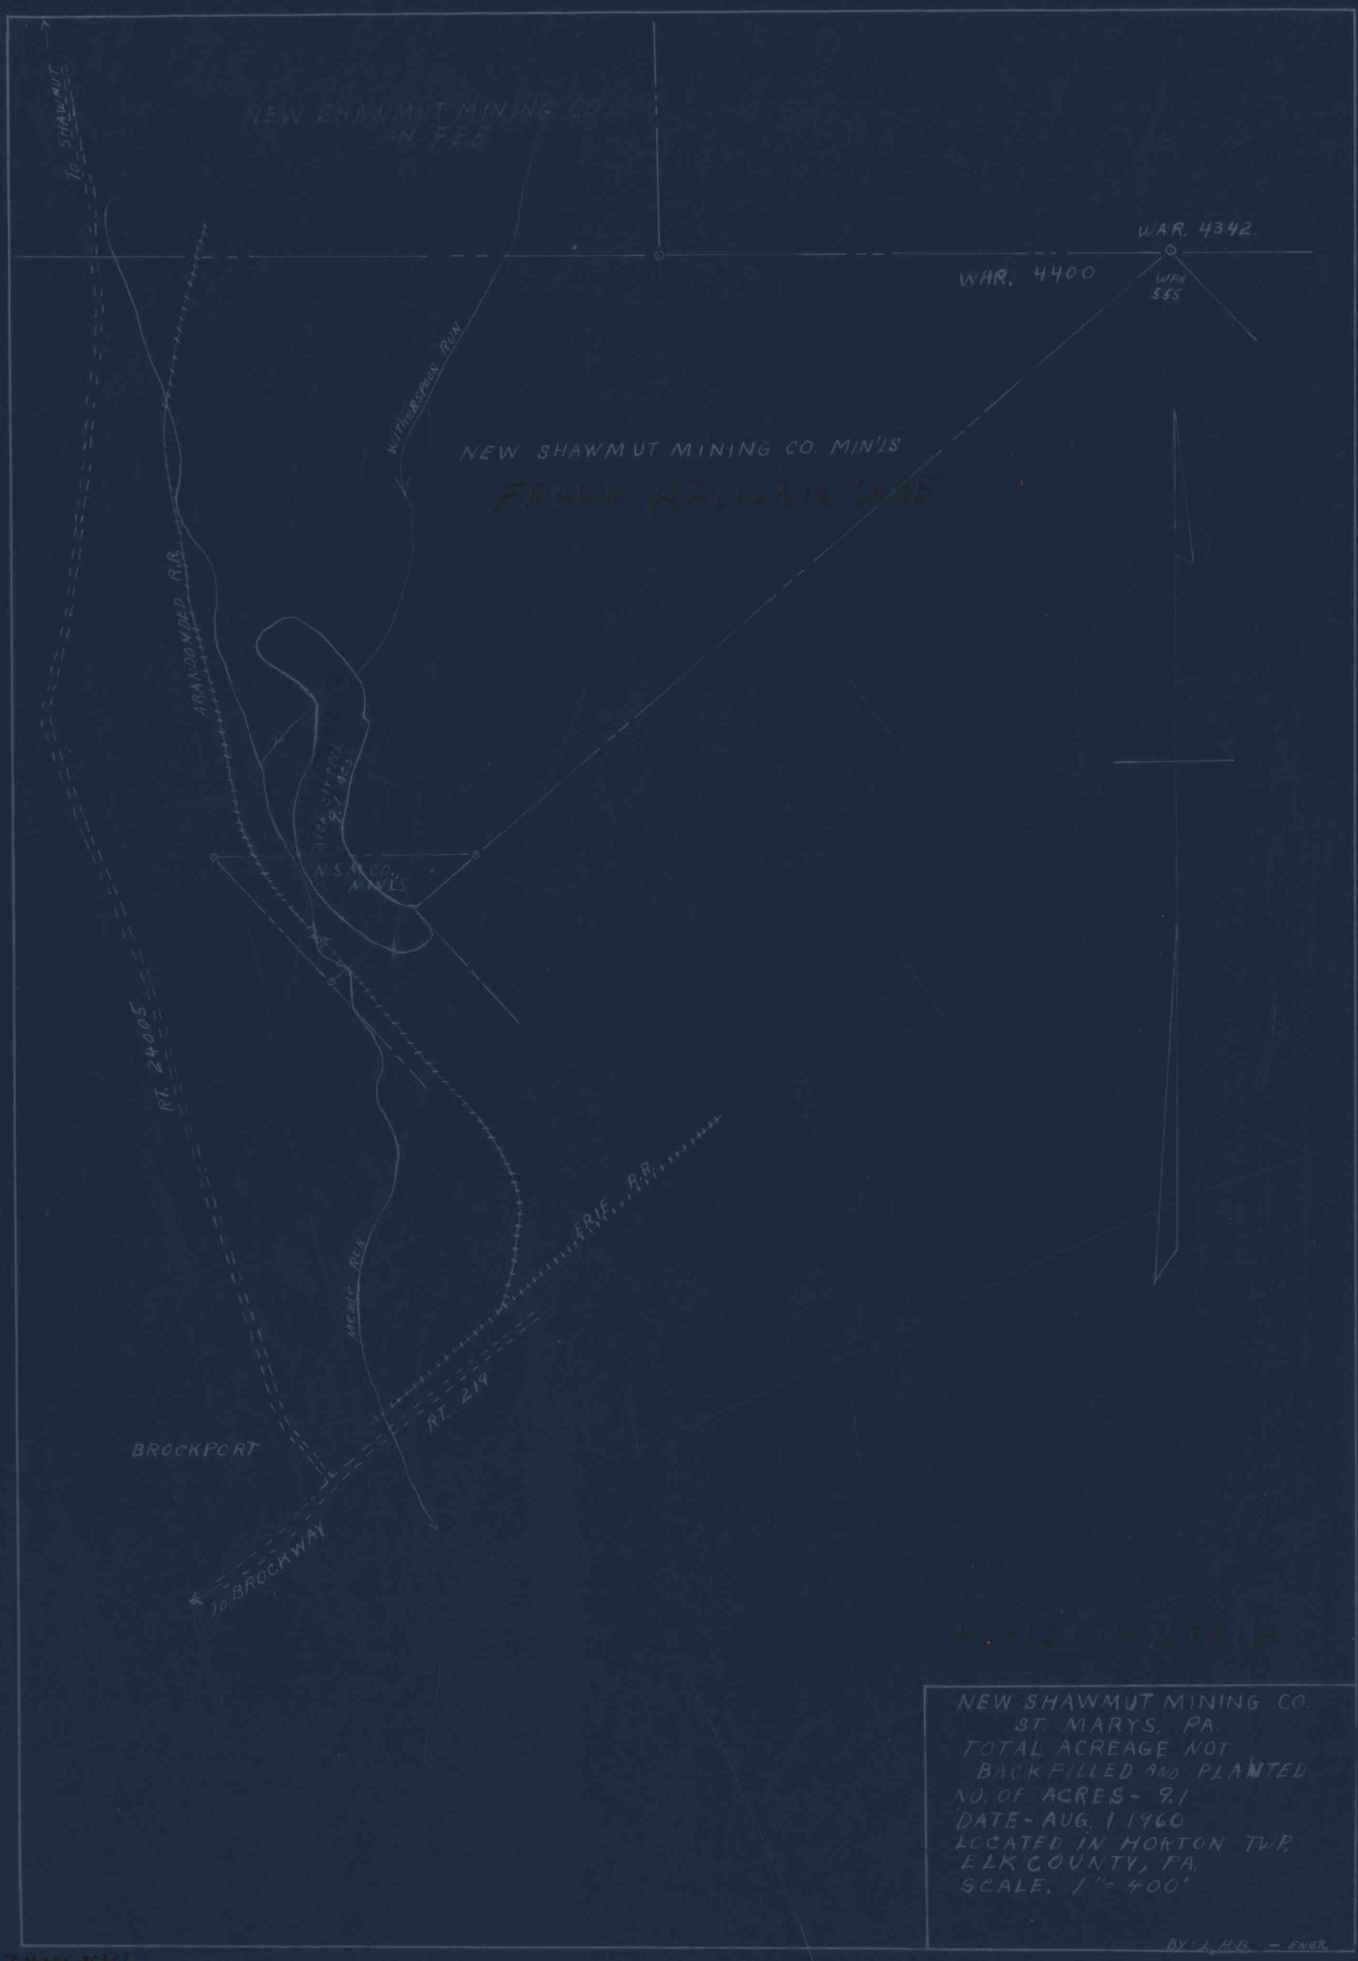
NEW SHAWMUT MINING CO.
IN FEE
TO SHAWMUT
W.A.R. 4342.
W.A.R. 4400
W.A.R. 555
WITHERSPOON RUN
NEW SHAWMUT MINING CO. MIN'LS
FEE
ABANDONED R.R.
N.S.M.CO. MIN'LS
RT. 24005
ERIE R.R.
MEADE RUN
RT. 219
BROCKPORT
TO BROCKWAY
NEW SHAWMUT MINING CO.
ST. MARYS, PA.
TOTAL ACREAGE NOT
BACKFILLED AND PLANTED
NO. OF ACRES - 9.1
DATE - AUG. 1 1960
LOCATED IN HORTON TWP.
ELK COUNTY, PA.
SCALE. 1" = 400'
BY - L. H.B. - ENGR.

I MAPS 16166