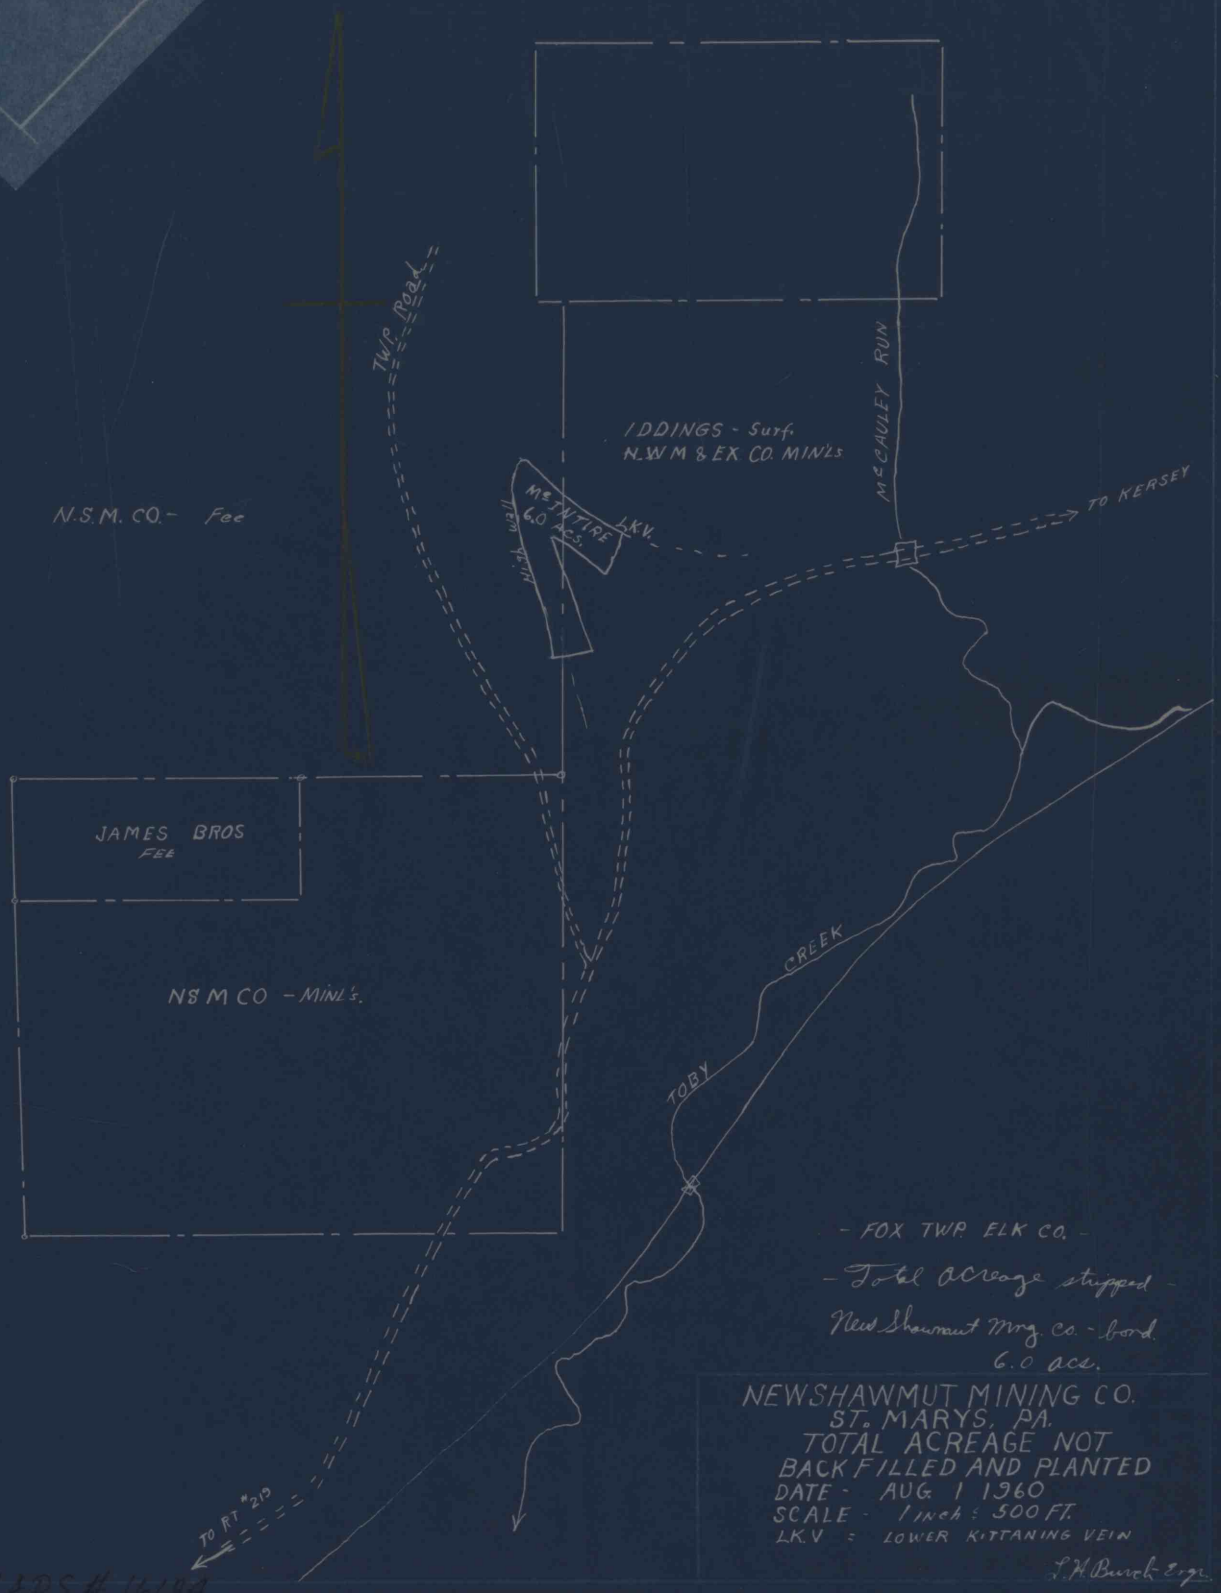
TWP. Road
IDDINGS - Surf.
N.W.M & EX CO. MIN'Ls
McCAULEY RUN
TO KERSEY
N.S.M. CO. - Fee
McINTIRE
6.0 ACS.
L.K.V.
JAMES BROS
FEE
NS M CO - MIN'Ls.
TOBY
CREEK
TO RT #219
- FOX TWP. ELK CO. -
- Total acreage stripped -
New Shawmut Mng. Co. - bond.
6.0 acs.
NEWSHAWMUT MINING CO.
ST. MARYS, PA.
TOTAL ACREAGE NOT
BACKFILLED AND PLANTED
DATE - AUG. 1 1960
SCALE - 1 inch = 500 FT.
L.K.V = LOWER KITTANING VEIN
S.H. Burch Engr.

MAPS # 16184