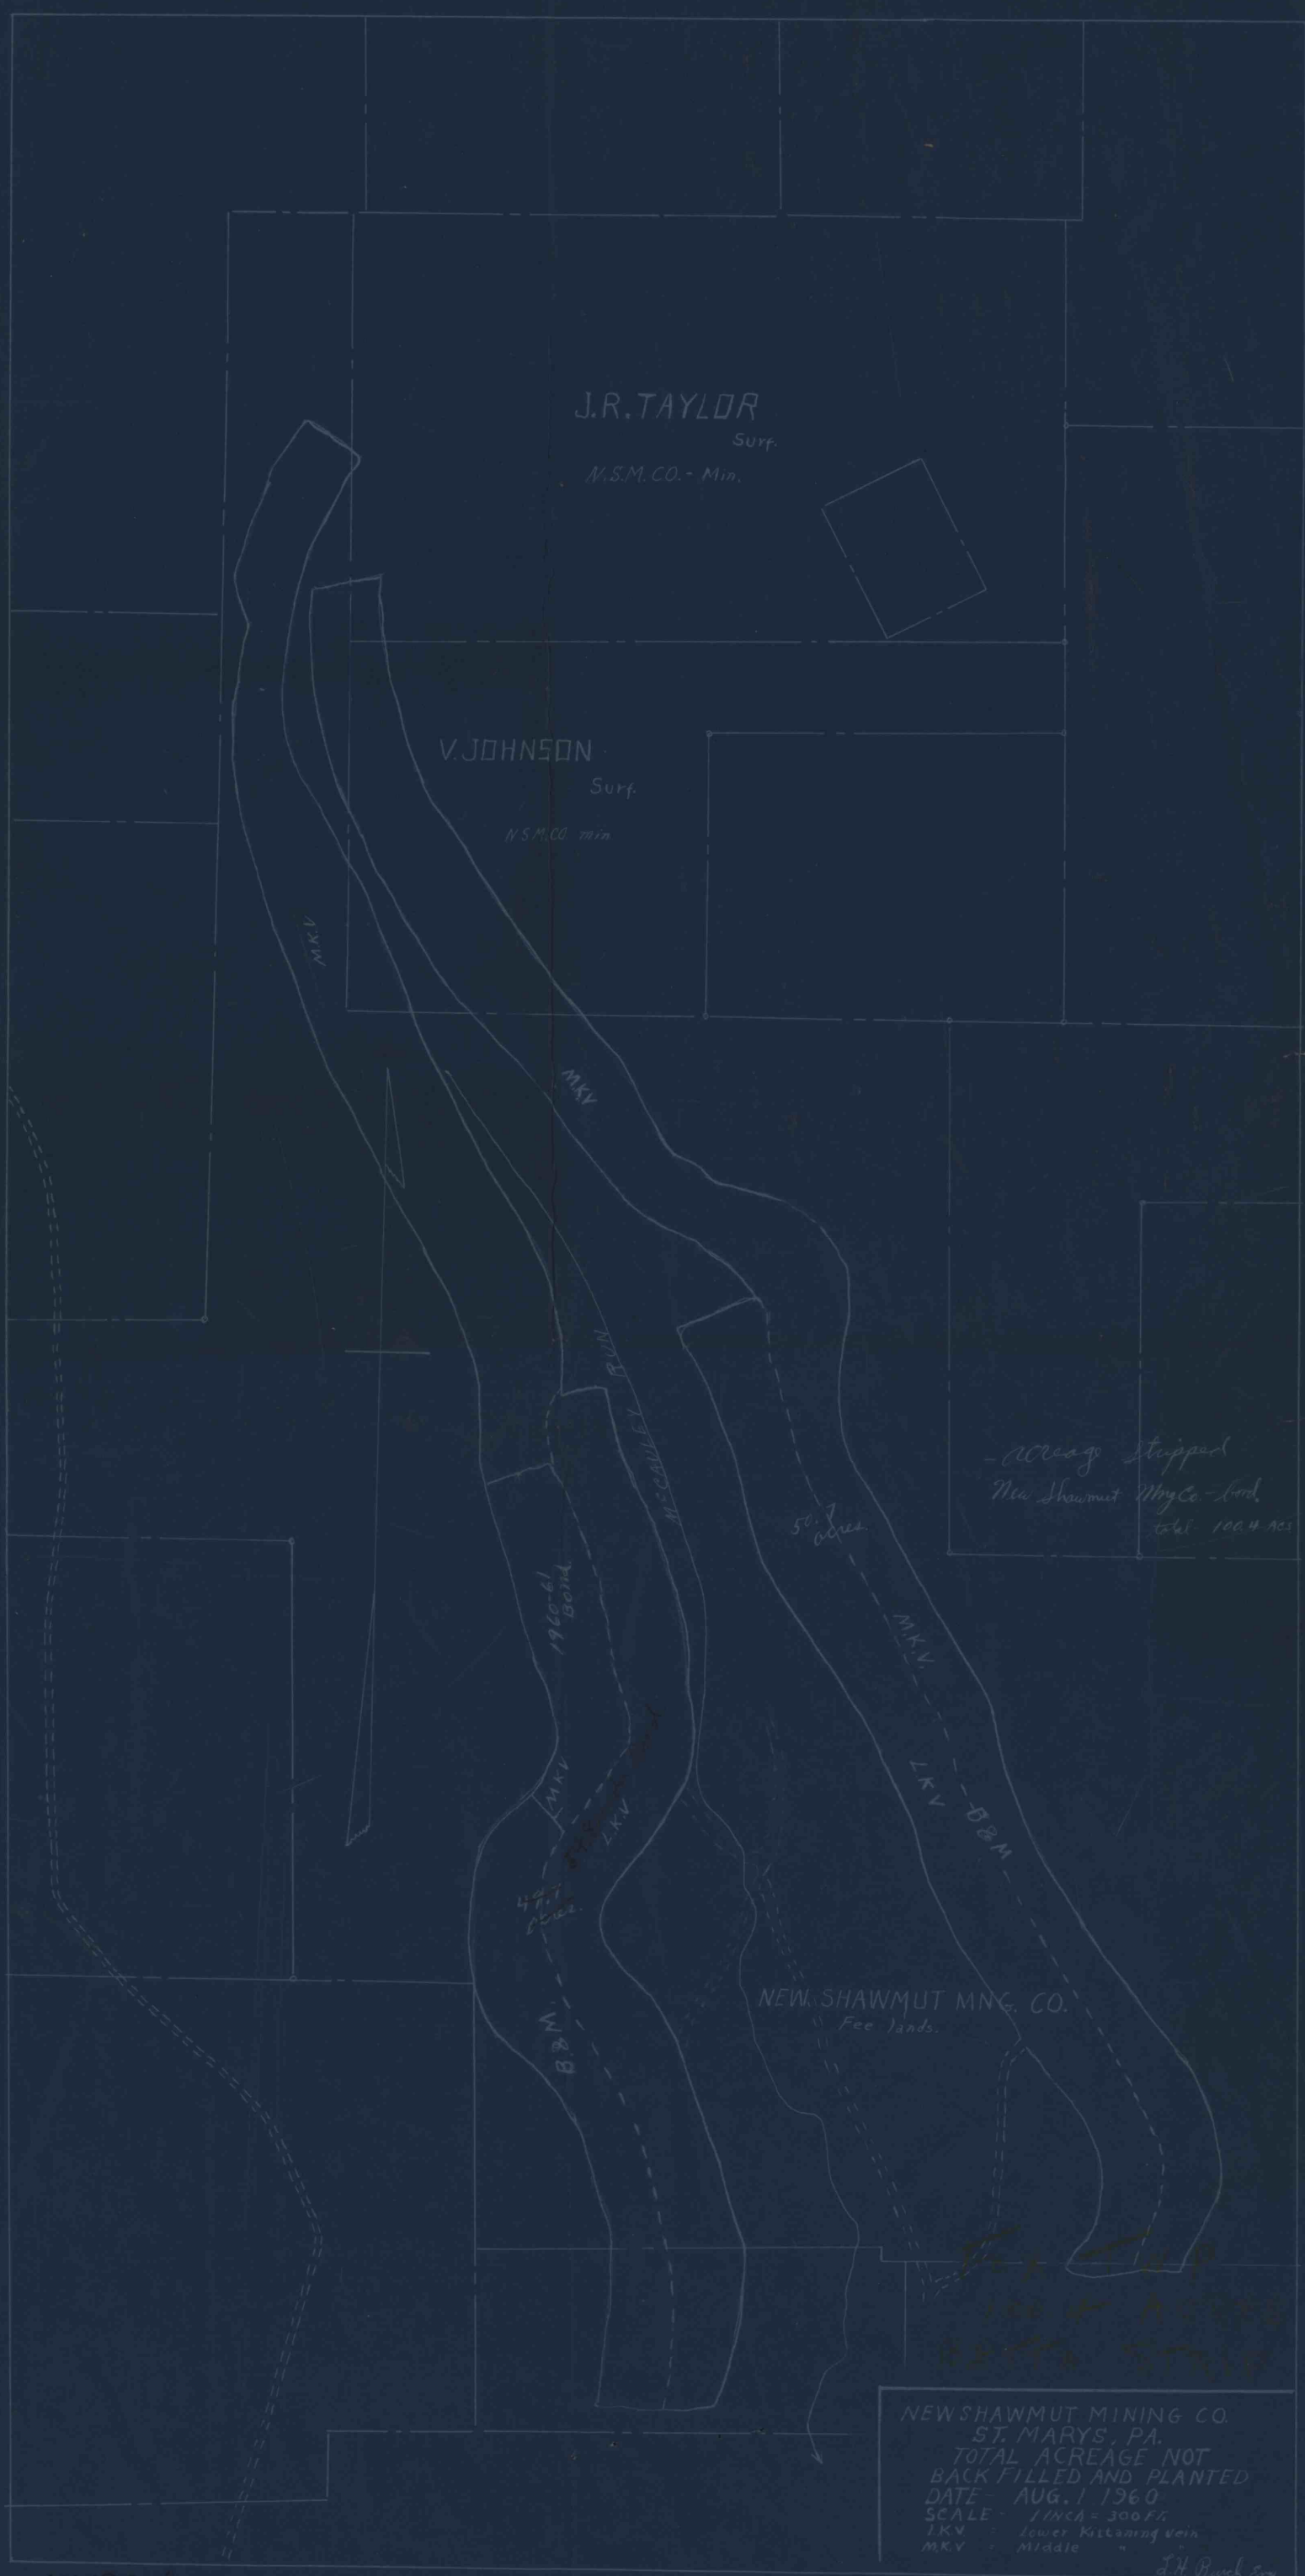
J.R. TAYLOR
Surf.
N.S.M. CO. - Min.
V. JOHNSON
Surf.
N.S.M.CO. min.
M.K.V.
M.K.V.
McCAULEY RUN
1960-61 Bond
M.K.V.
L.K.V.
B&M
50.7 acres
M.K.V.
L.K.V.
B&M
NEW SHAWMUT MNG. CO.
Fee lands.
- acreage stripped
New Shawmut Mng Co. - bond.
total - 100.4 ACS
NEW SHAWMUT MINING CO.
ST. MARYS, PA.
TOTAL ACREAGE NOT
BACK FILLED AND PLANTED
DATE - AUG. 1 1960
SCALE - 1 INCH = 300 FT.
L.K.V. - Lower Kittanning vein
M.K.V. - Middle "
L.H. Burch Eng.

IMAPS # 16192