



G. KUNES

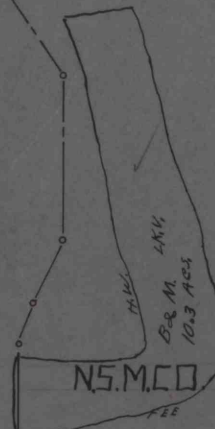


N.T. ARNOLD
SURF

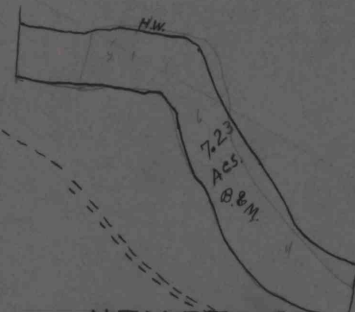


N.S.M.CO


C. DENNISON
FEE

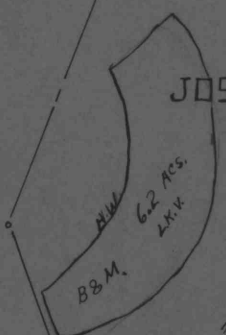

JOSEPH DILL

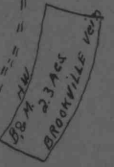

HALL & KAUL
SURE

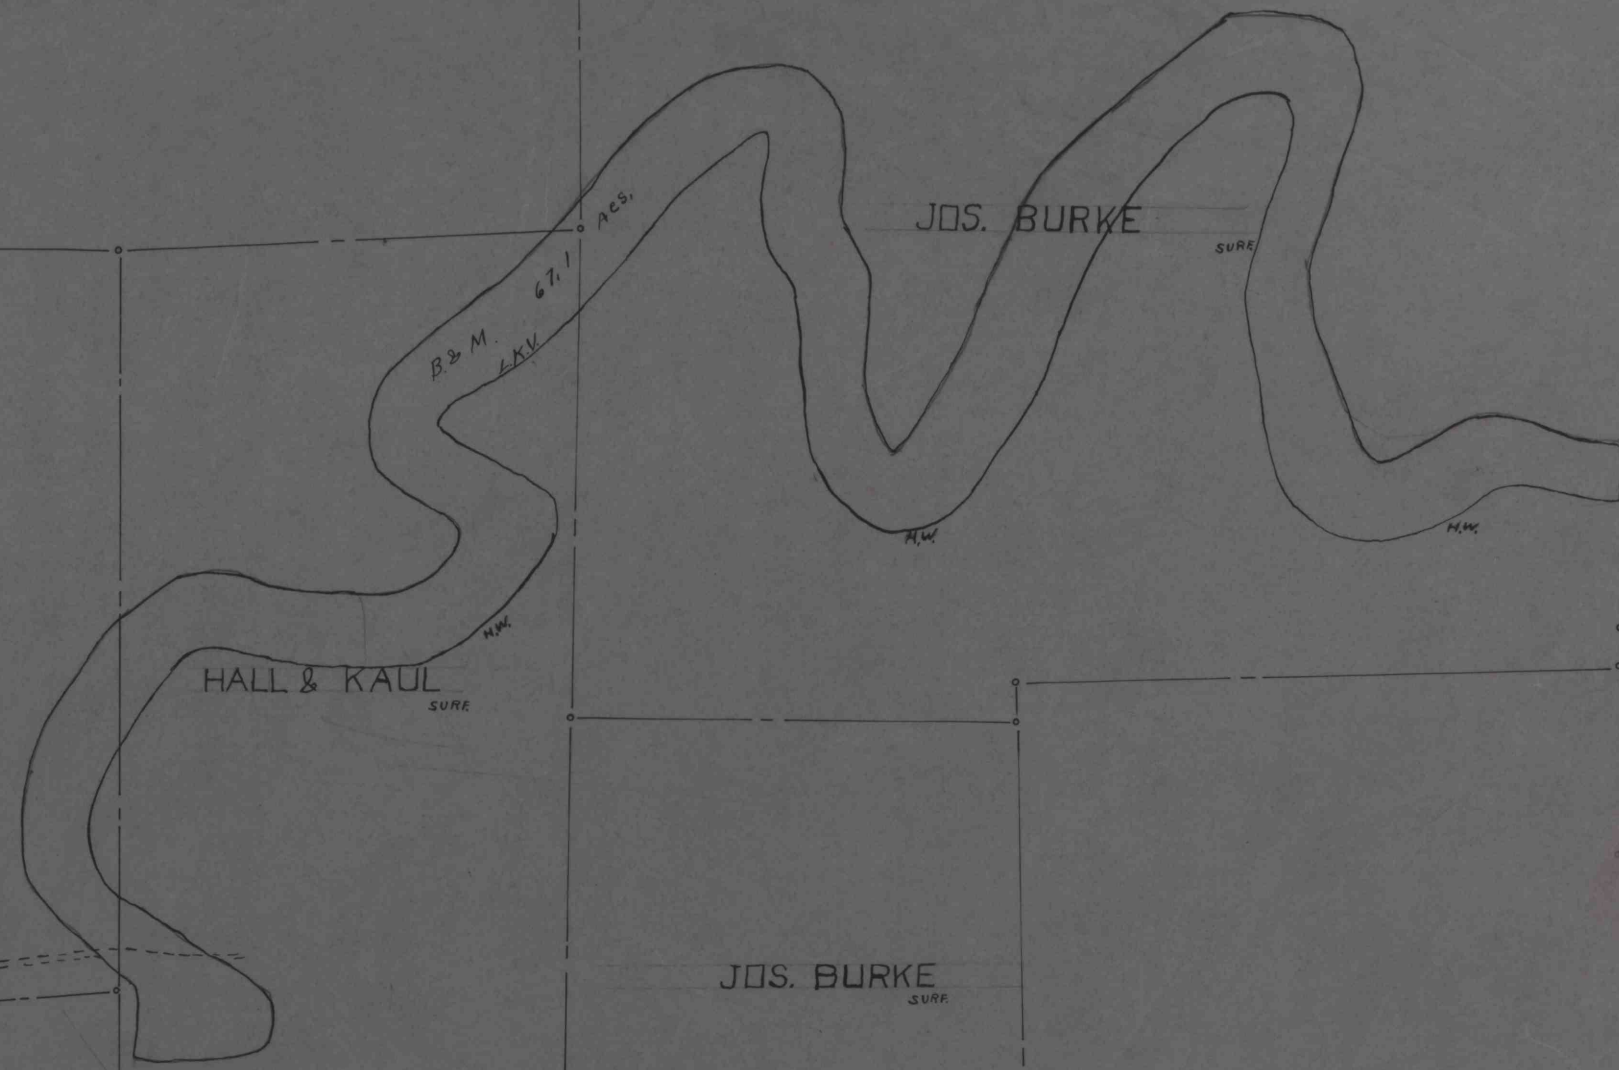

JOS. BURKE
SURE

LEON OVELL
SURE

TO BENEZETTE

CHAS. SHUTTERS
SURF

N.S.M.CO.
FEE

acreage stripped
New Shawmut Bond. 194.7 Acs.
JAY TWP. ELK CO.
H&K
Burke

NEWSHAWMUT MINING CO.
ST. MARYS, PA.
TOTAL ACREAGE NOT
BACK-FILLED AND PLANTED
DATE - AUG 1 1960
SCALE - 1 inch = 400 FT.
LKV = LOWER KITTANING VEIN
HW = HIGH WALL.
S.H. Burch - Engr.