


# NEW SHAWMUT MINING CO.

Fee.

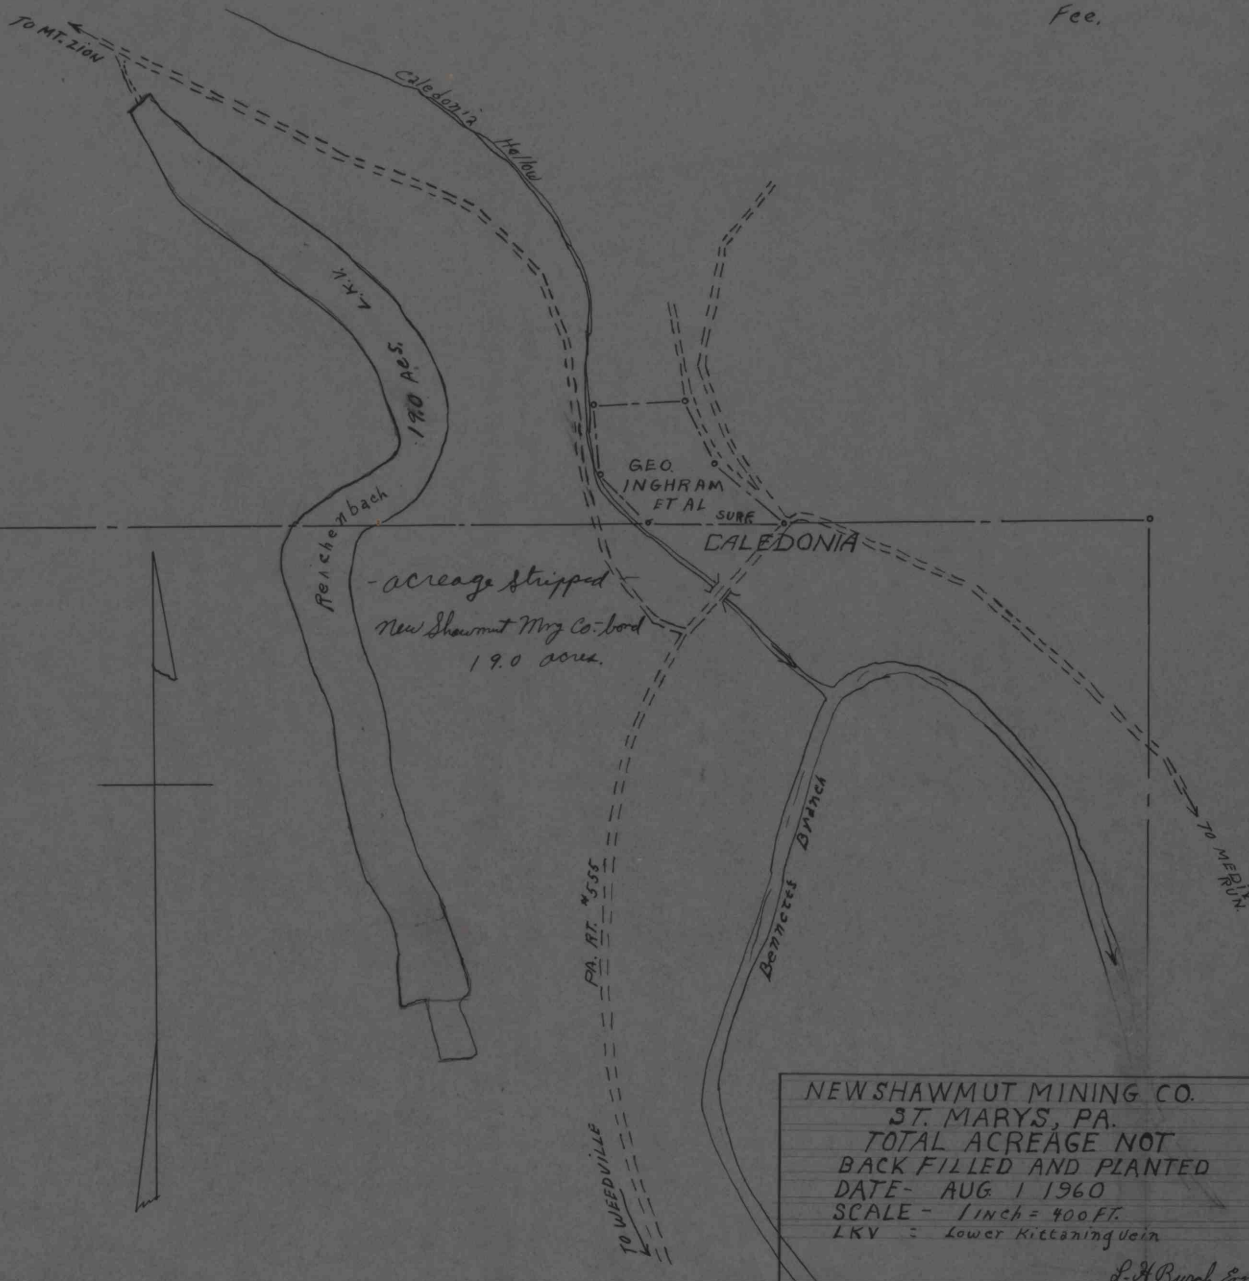

L.H. Burch, Jr.