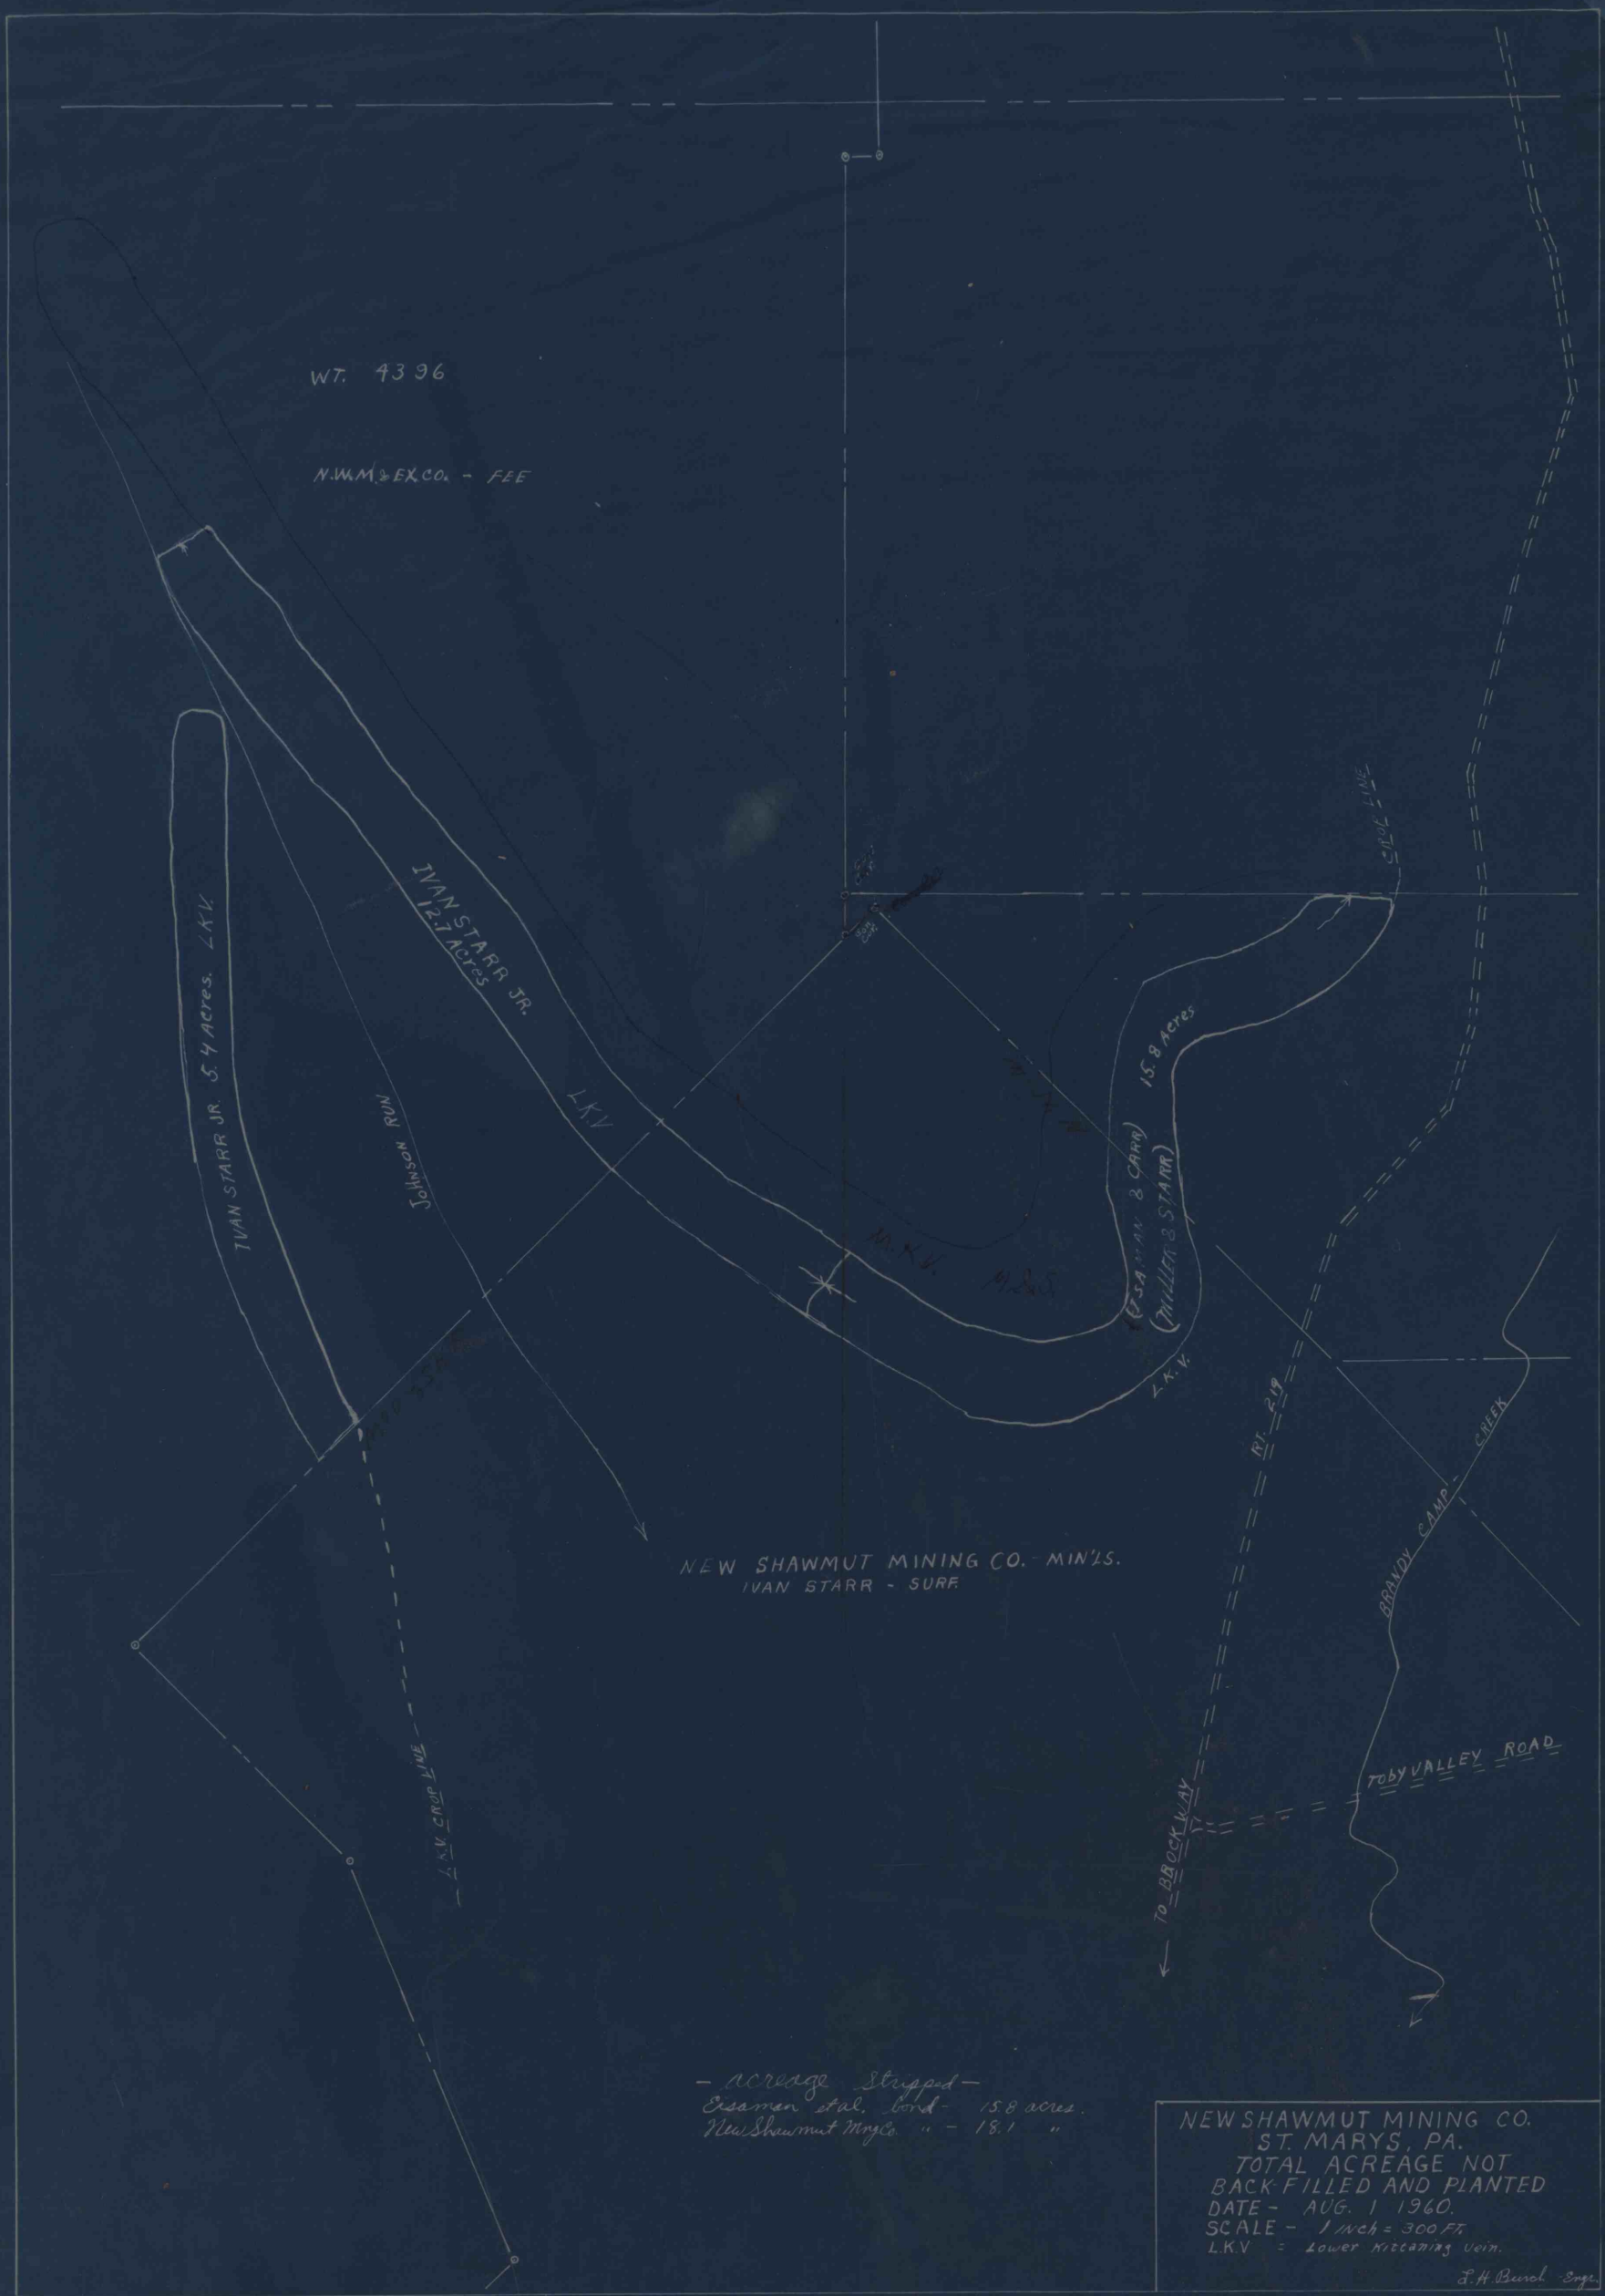
WT. 4396
N.W.M. & EX. CO. - FEE
IVAN STARR JR. 5.4 Acres. L.K.V.
IVAN STARR JR. 12.7 Acres
L.K.V.
Johnson Run
L.K.V.
Essaman & Carr
(Miller & Starr)
15.8 Acres
L.K.V.
Rt. 219
BRANDY CAMP CREEK
NEW SHAWMUT MINING CO. MIN'LS.
IVAN STARR - SURF.
L.K.V. CROP LINE
TO BROCKWAY
TOBY VALLEY ROAD
- acreage Stripped -
Essaman etal. bond - 15.8 acres.
New Shawmut Mng Co. " - 18.1 "
NEW SHAWMUT MINING CO.
ST. MARYS, PA.
TOTAL ACREAGE NOT
BACK FILLED AND PLANTED
DATE - AUG. 1 1960.
SCALE - 1 inch = 300 FT.
L.K.V = Lower Kittanning Vein.
L.H. Burch Engr.

IMAPS 16199