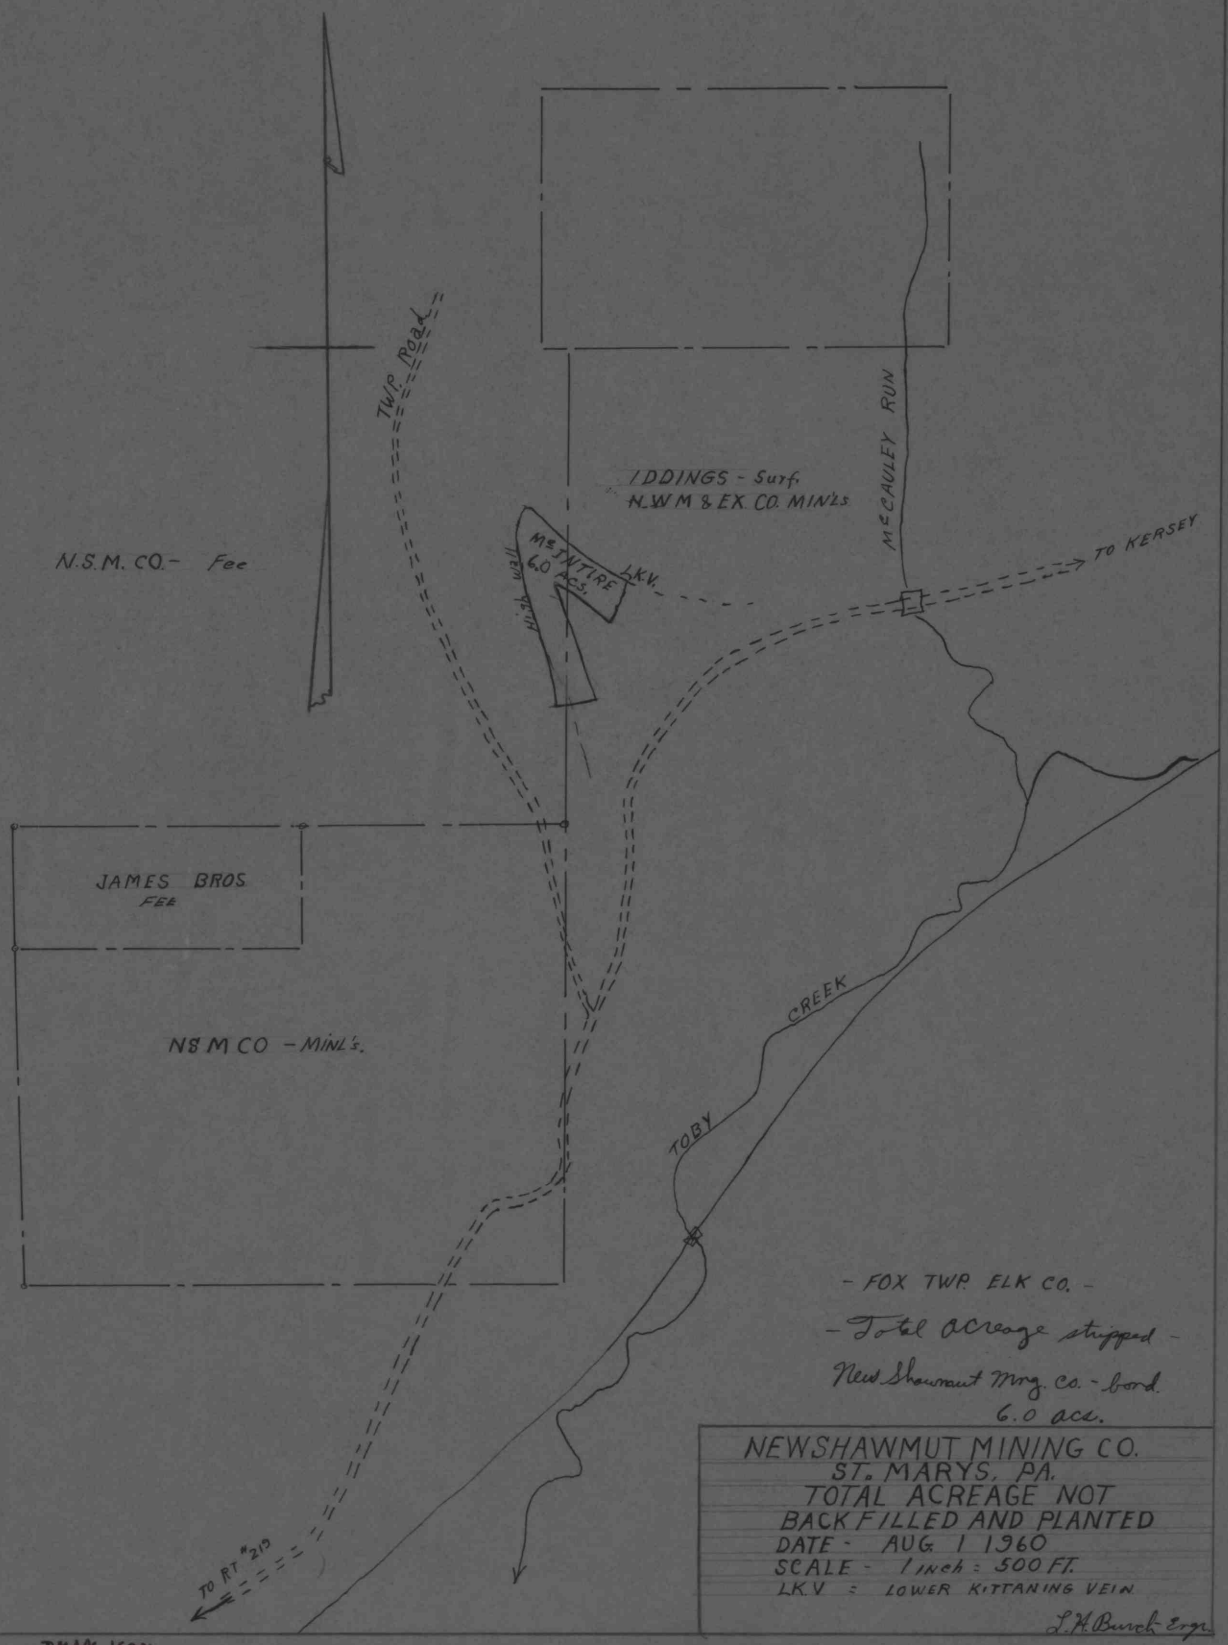
TWP. Road
N.S.M. CO.- Fee
IDDINGS - Surf.
N.W.M & EX. CO. MIN'Ls
McCAULEY RUN
TO KERSEY
M&S INTIRE
6.0 ACS.
LKV.
JAMES BROS
FEE
N&M CO - MIN'L's.
TOBY
CREEK
- FOX TWP. ELK CO. -
- Total acreage stripped -
New Shawmut Mng. Co. - bond.
6.0 acs.
NEWSHAWMUT MINING CO.
ST. MARYS, PA.
TOTAL ACREAGE NOT
BACK FILLED AND PLANTED
DATE - AUG. 1 1960
SCALE - 1 inch = 500 FT.
LKV = LOWER KITTANING VEIN
L.H. Burch Engr.
TO RT #219

IMAPS 16201