


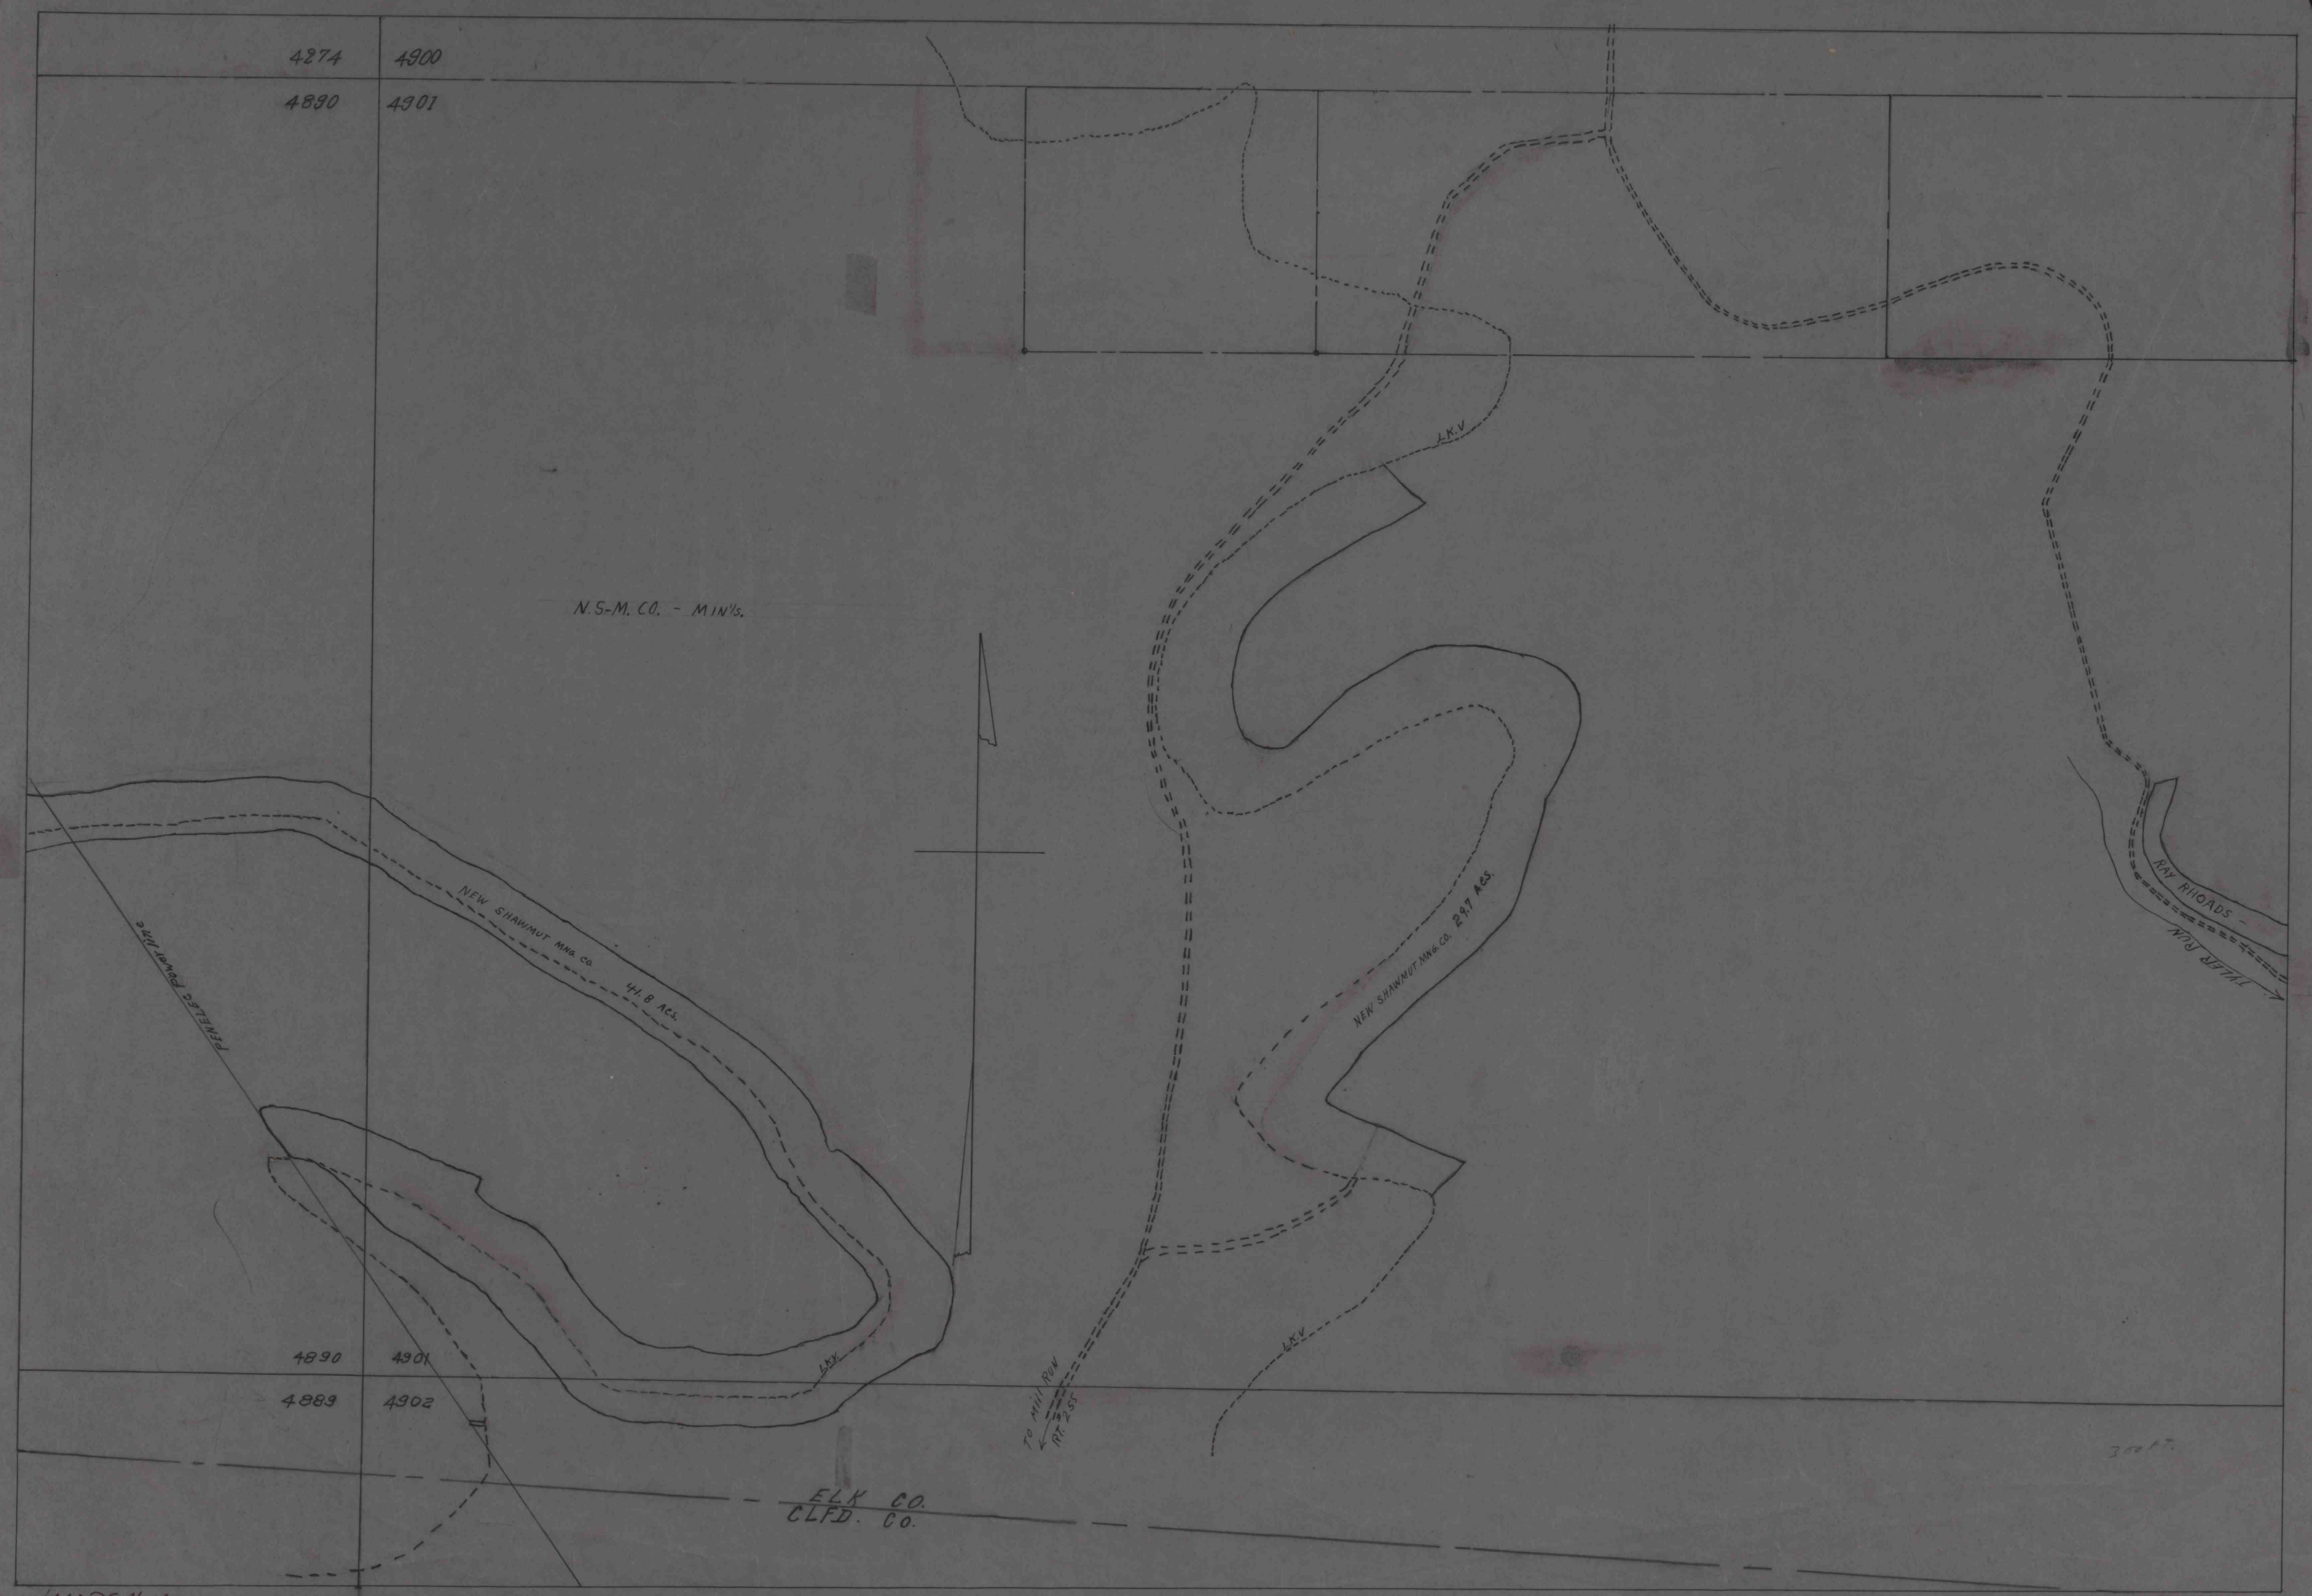

1/4 mile to highway
Strip 3.3 Acs.

- Acreage Stripped -
New Shawmut Mining Co. - Lord
Mill Run area - 74.5
Tyler Run " - 3.3
Total 77.8

NEW SHAWMUT MINING CO.
ST. MARYS, PA.
TOTAL ACREAGE NOT
BACK FILLED AND PLANTED
DATE - AUG. 1 1960
SCALE - 1/4 inch = 300 FT.
LKV = Lower Kitzbich vein

L.H. Burch, Eng.

MAPS 416204