


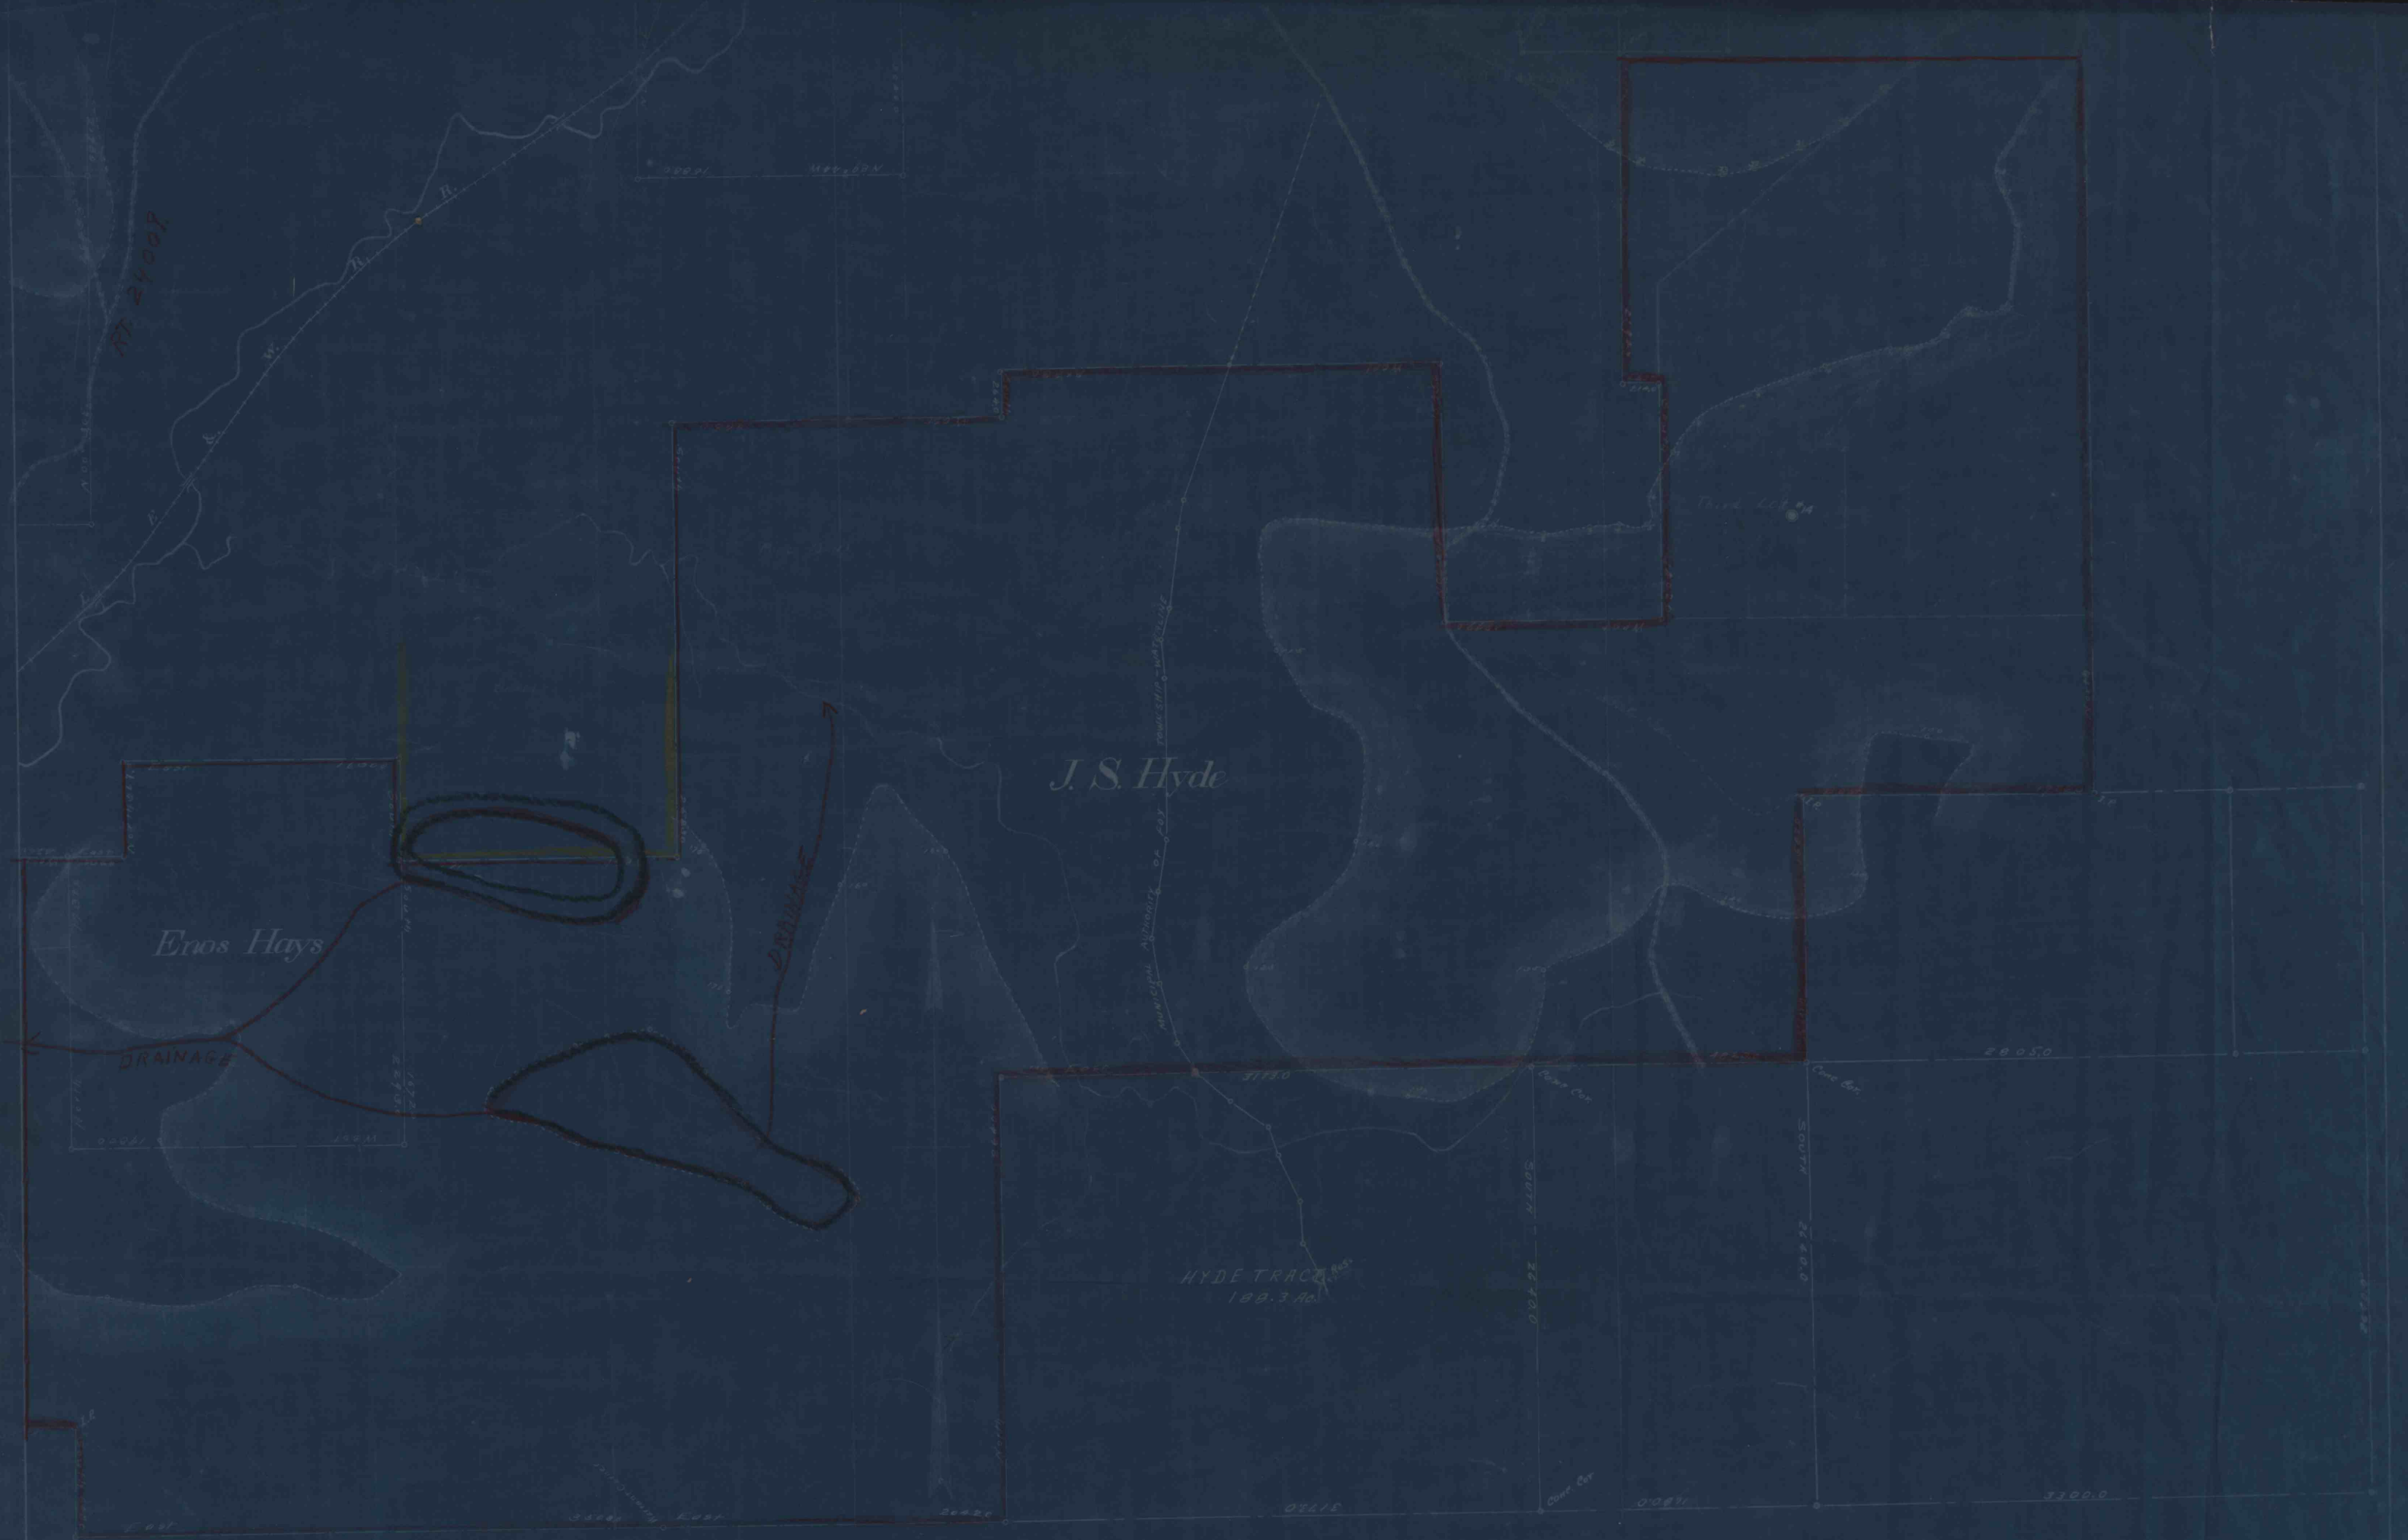

MAP
of the
ELBON FIELD

ELK CO. PA.
Scale 1 in = 500 ft
Oct. 1, 1903
Aug 31 1961

- N.S.M Co. Map
- Beaules Lands
- John Bond Strip P Job

Jewis H. Burch