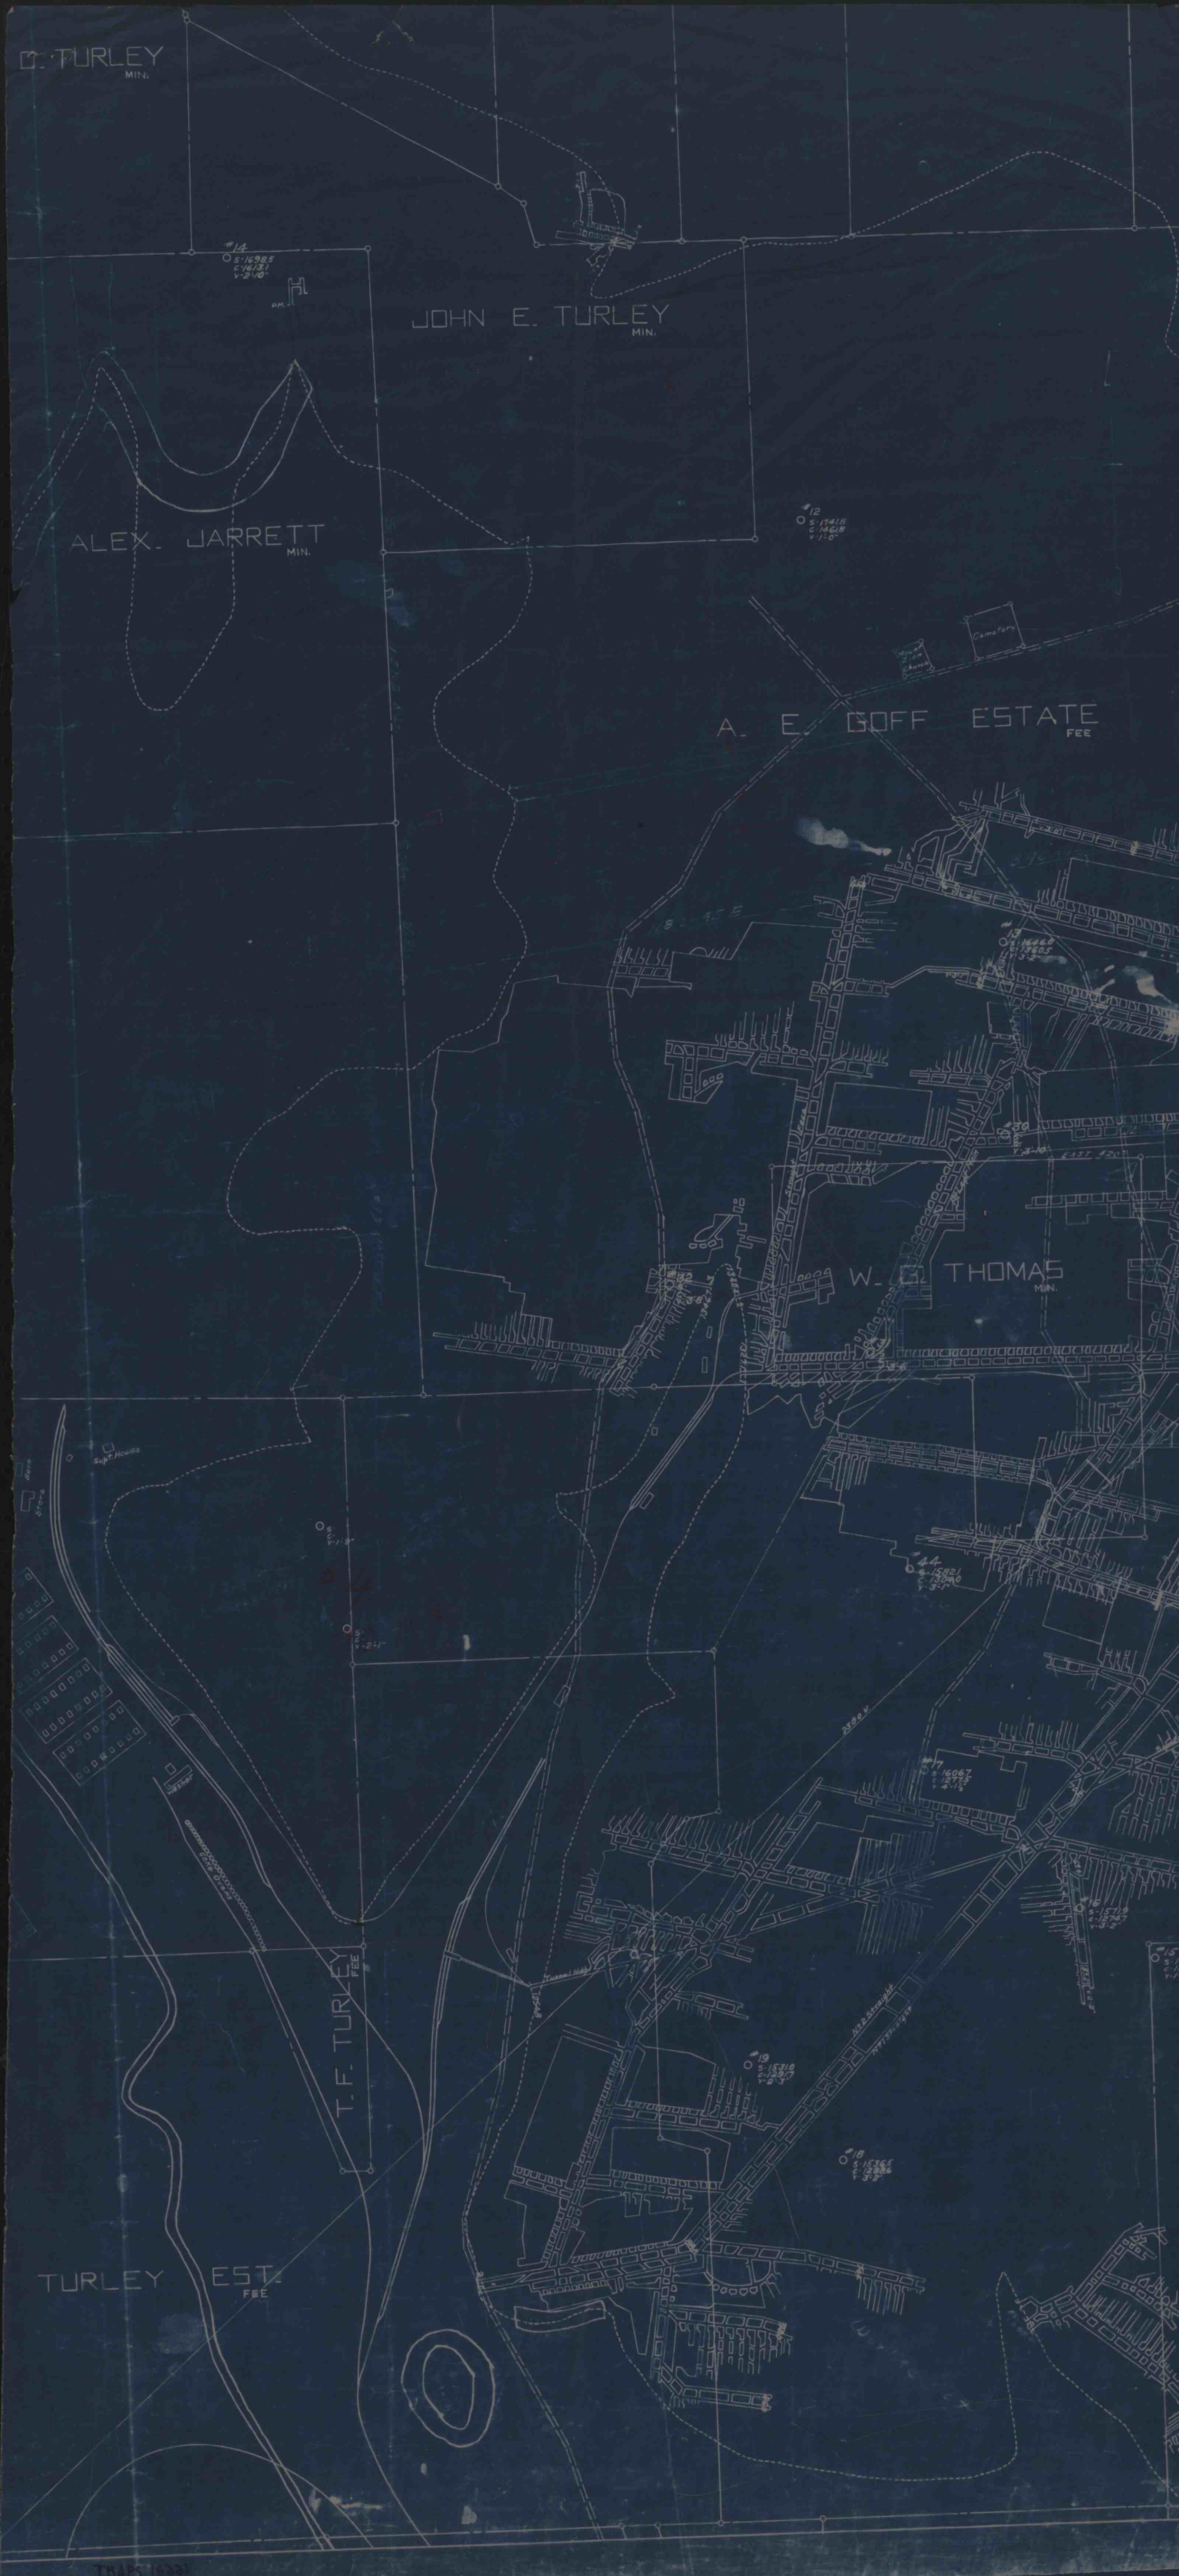
TURLEY
MIN.
JOHN E. TURLEY
MIN.
ALEX. JARRETT
MIN.
A. E. GOFF ESTATE
FEE
W. G. THOMAS
MIN.
T. F. TURLEY
FEE
TURLEY EST.
FEE

IMAPS 16331